



FINAL SURVEY NOTE BOOK
 No. _____
 DATE _____
 BY _____

ORIGINAL SURVEY NOTE BOOK
 No. _____
 DATE _____
 BY _____

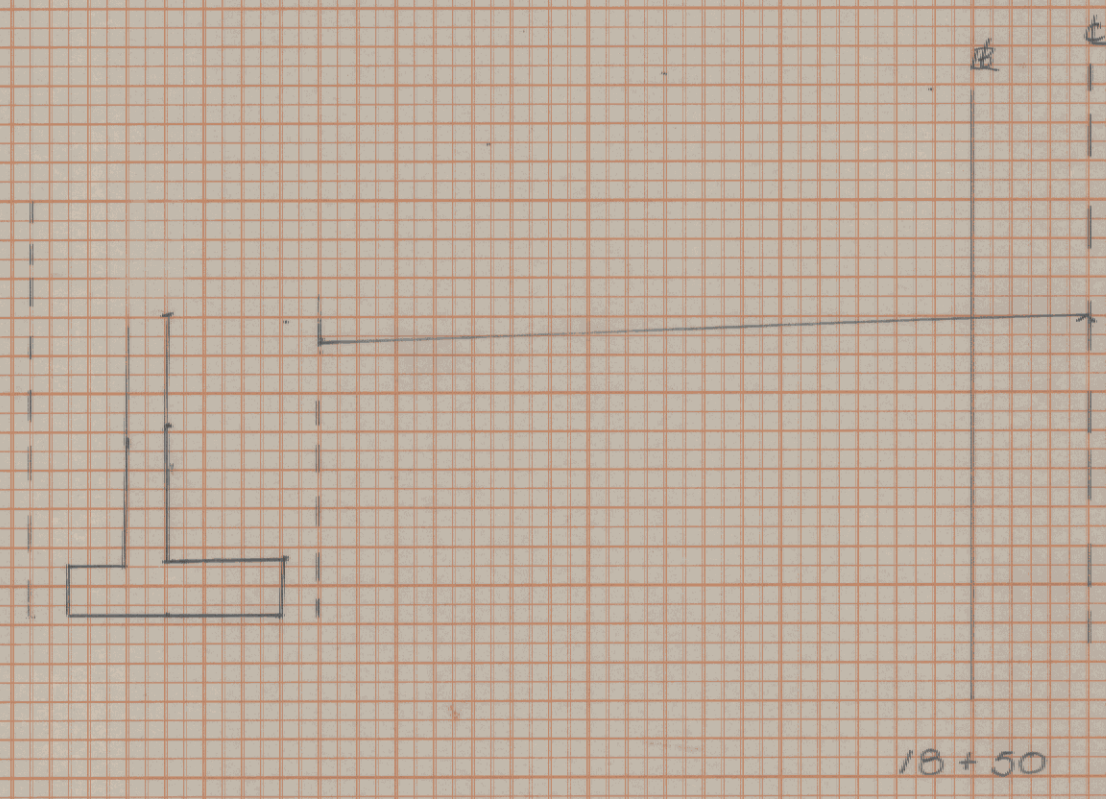

570

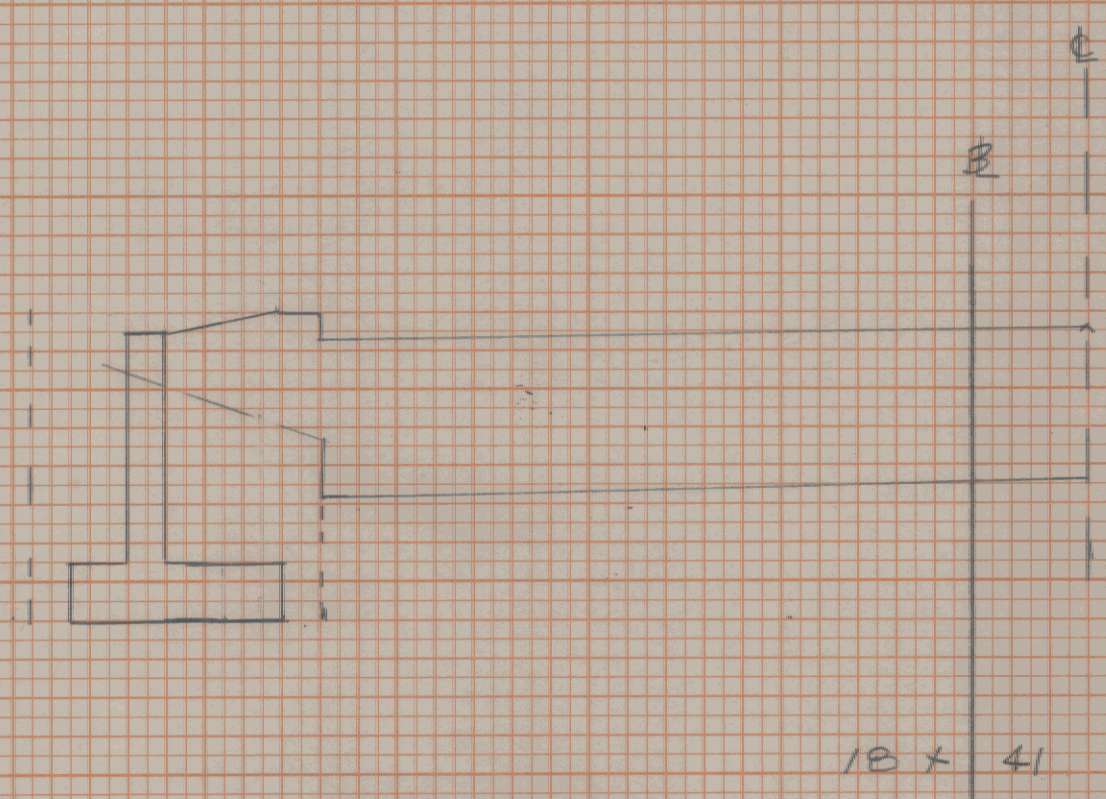

570

Handwritten signature or initials

Montpelier ME6CM6400G1
 Structure sections
 Wall #5