
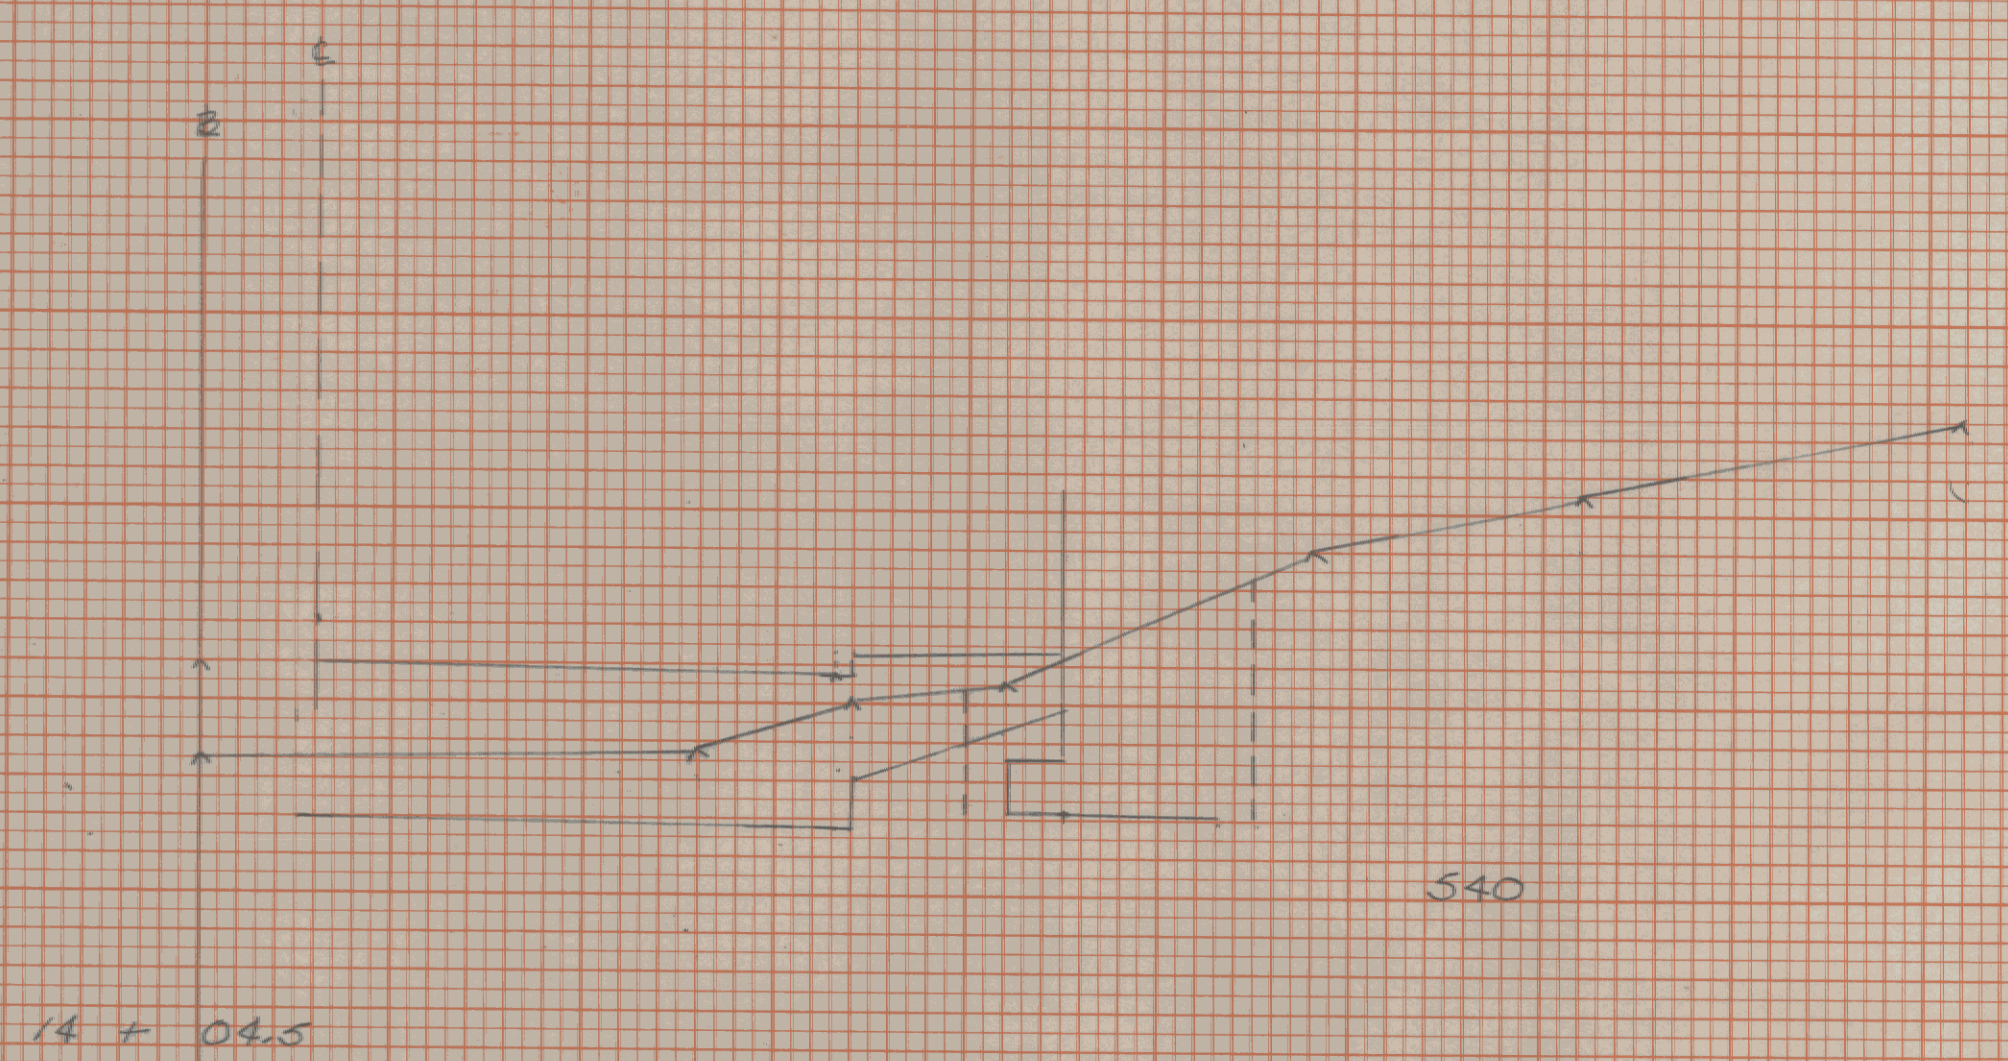
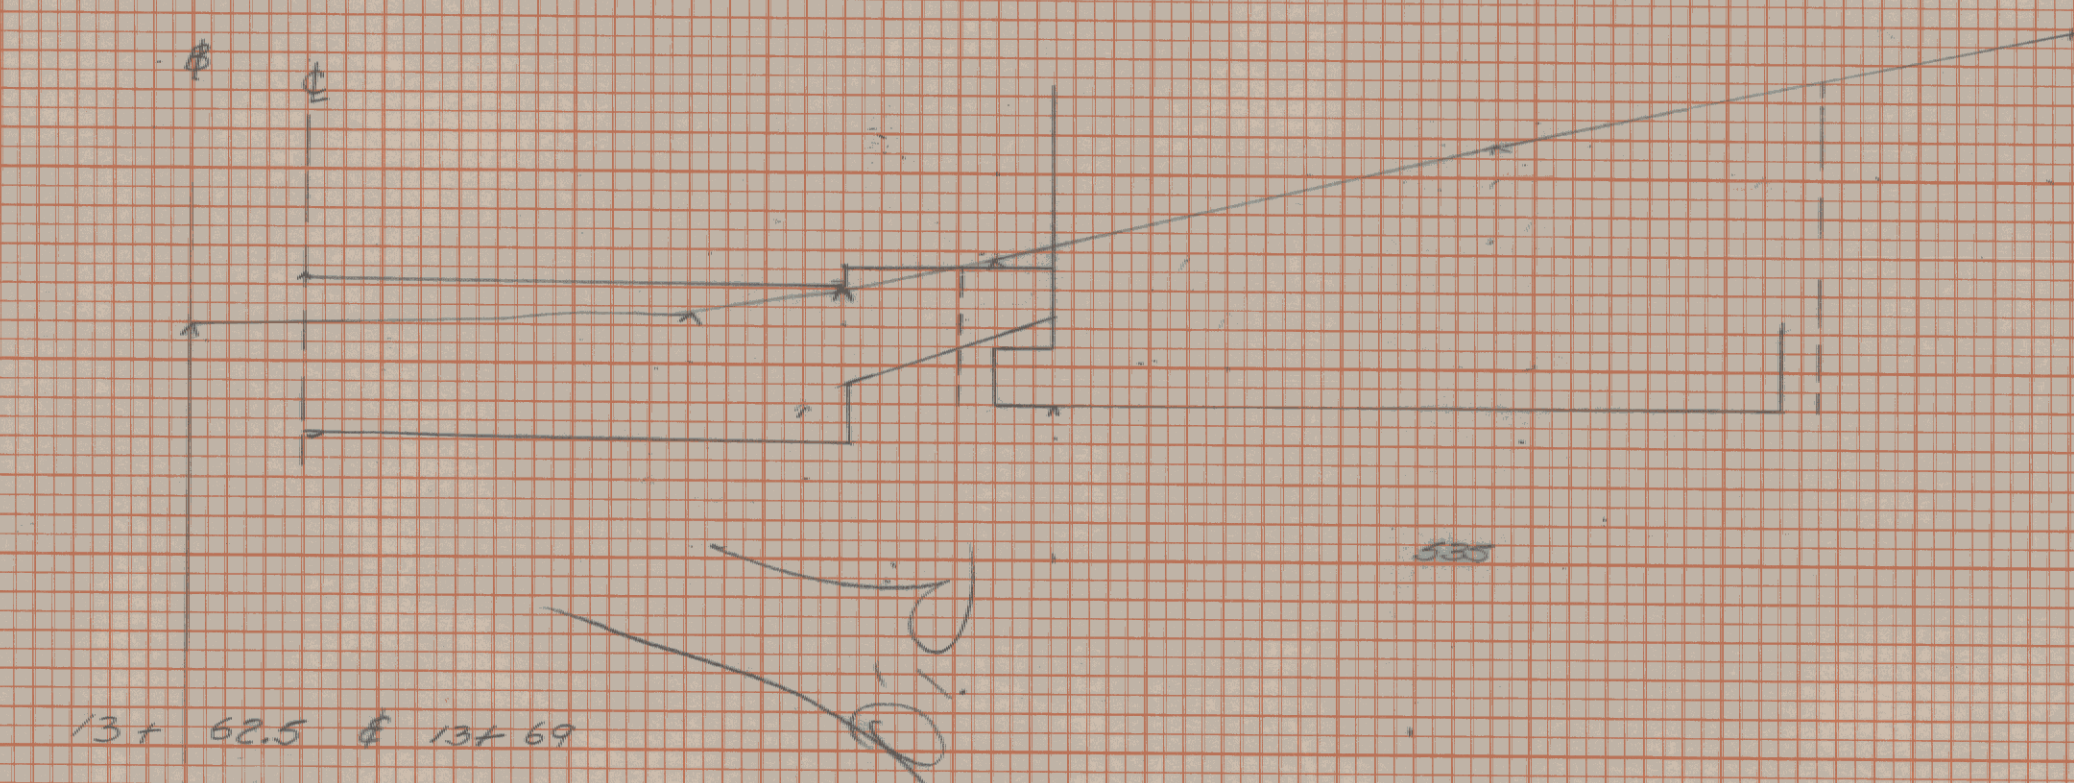
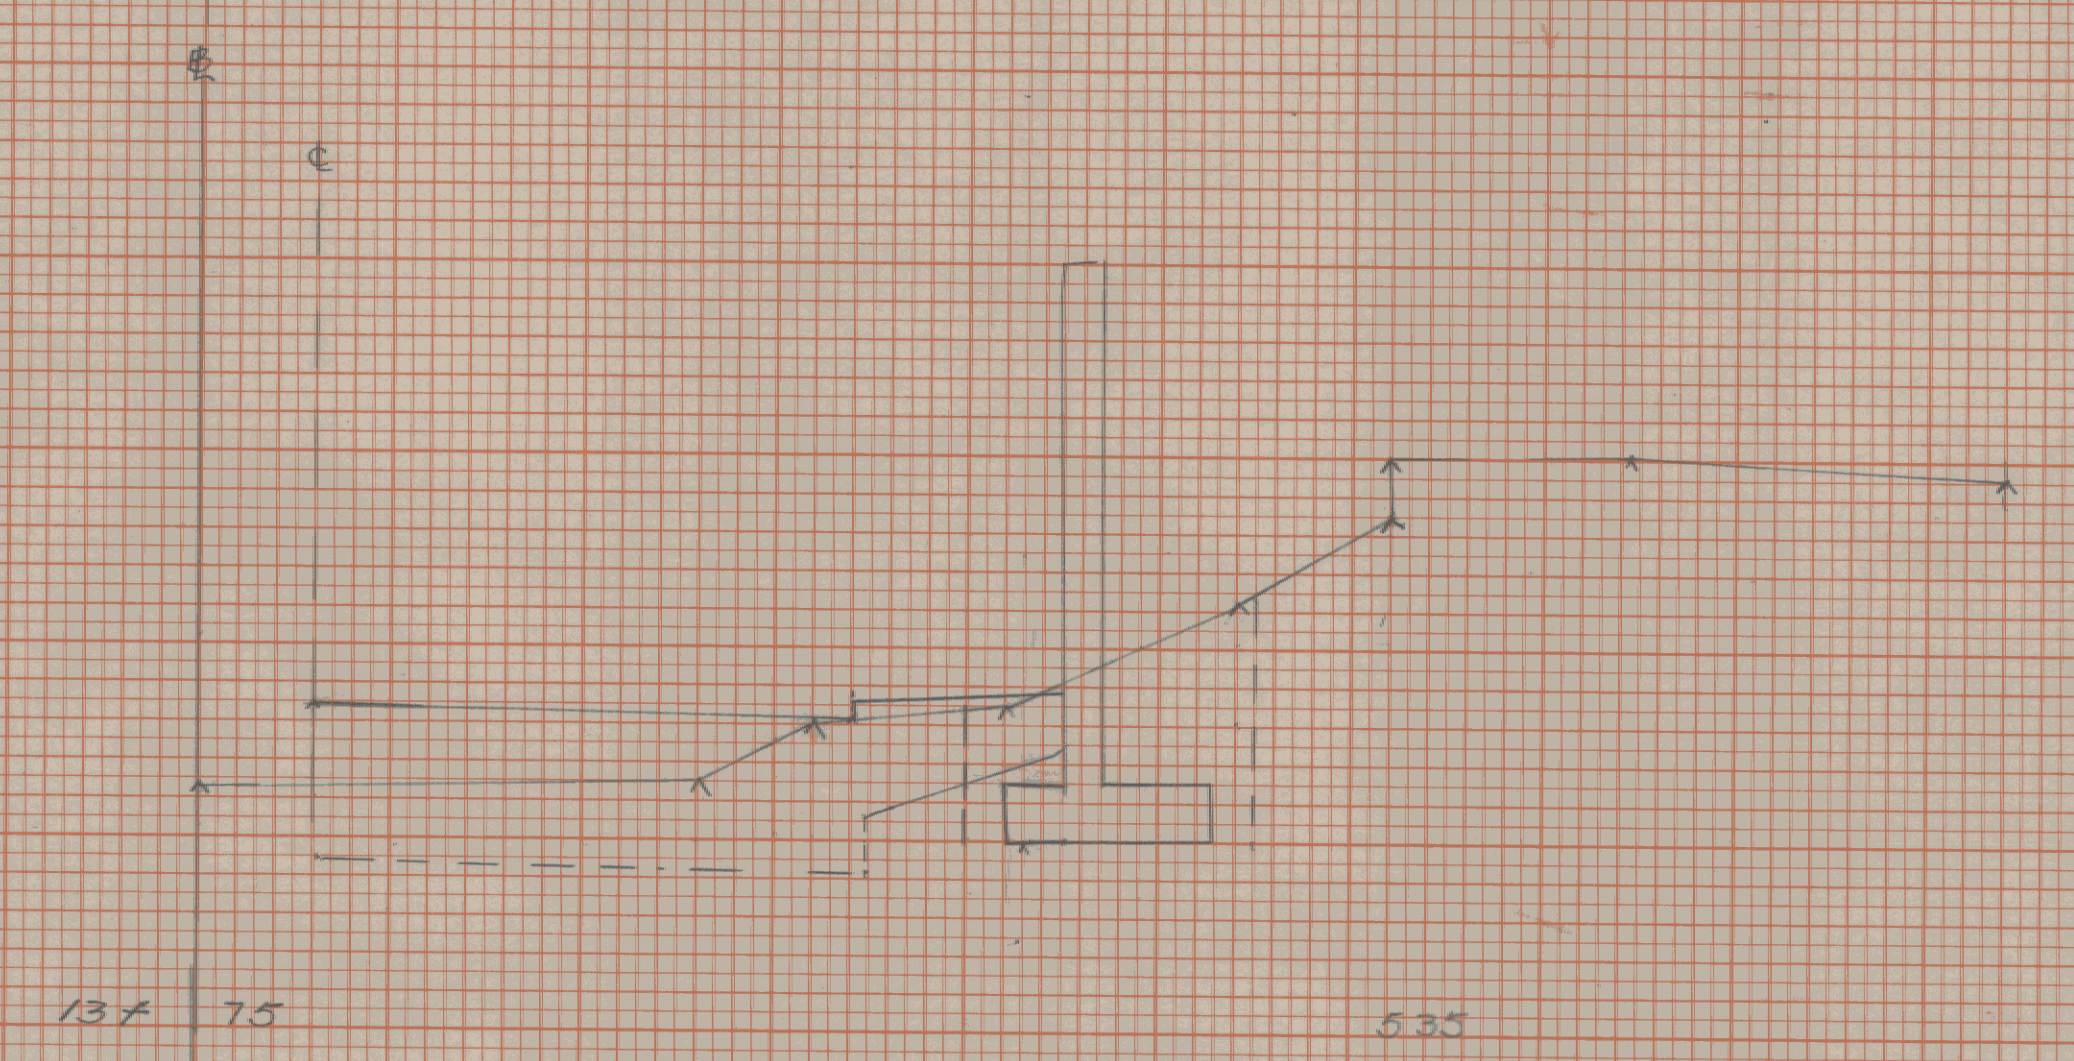


DATE
BY
REVIEWED
PLOTTED
TEMP. ATT.
APPROVED
FINAL SURVEY NOTE BOOK No.

DATE
BY
REVIEWED
PLOTTED
TEMP. ATT.
APPROVED
ORIGINAL SURVEY NOTE BOOK No.

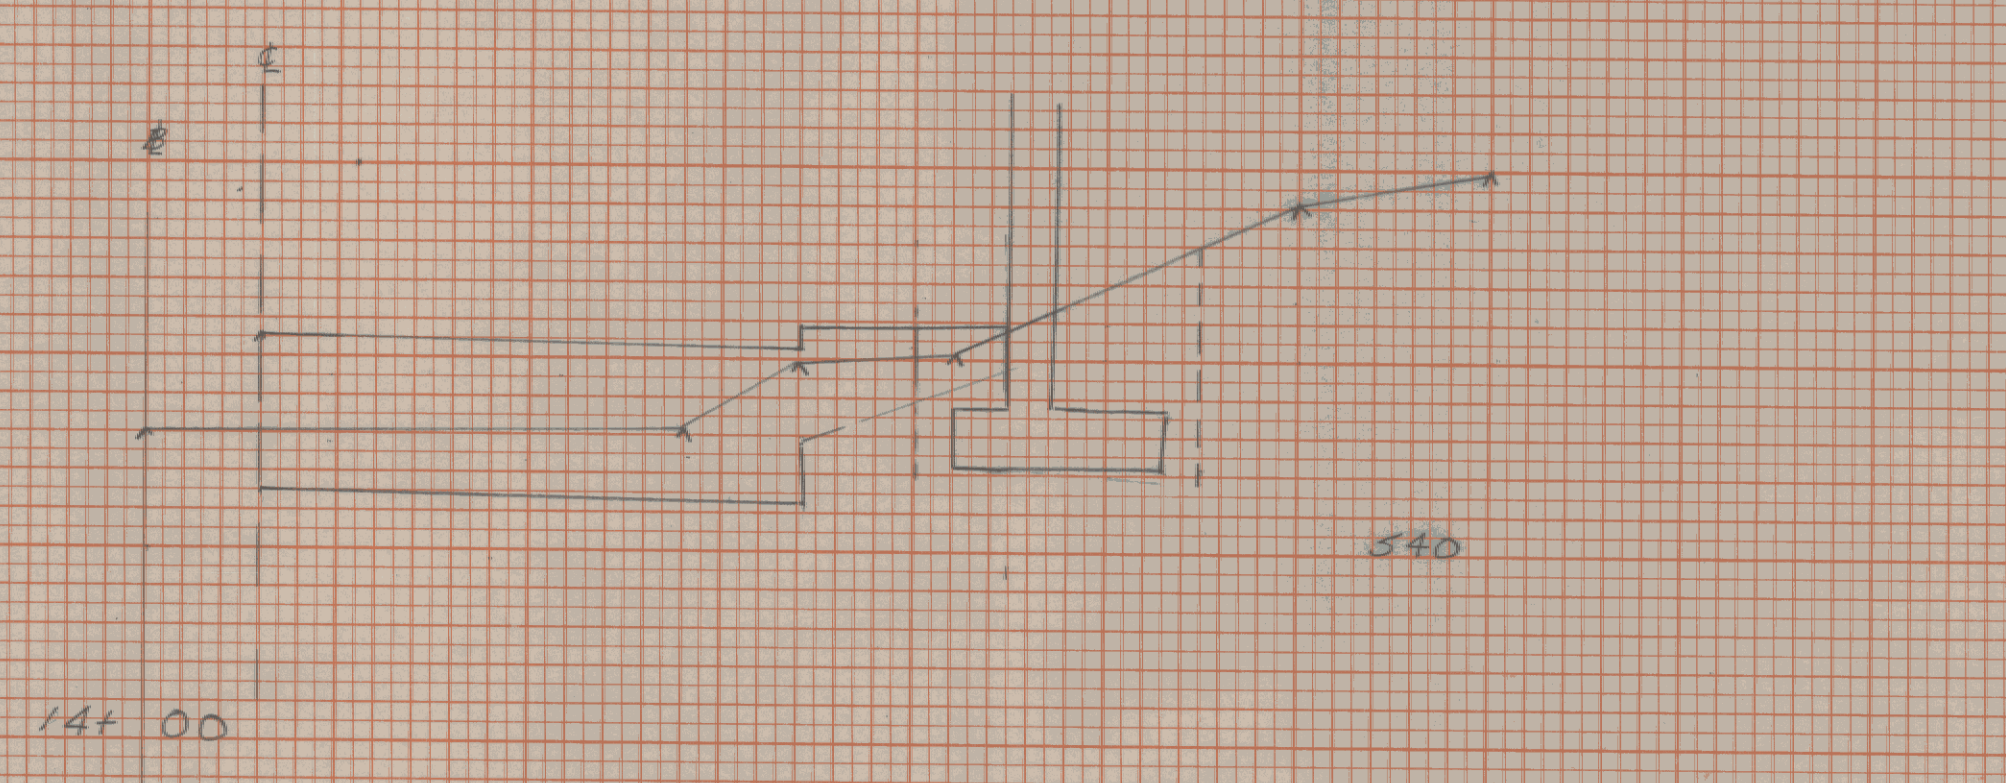

Handwritten signature

Montpelier M26CM600001
Structure sections
Wall #4