


DATE
BY
SURVEYED
FINAL SURVEY NOTE BOOK No.
TEMPERATURE
AREA
WIND DIRECTION

DATE
BY
SURVEYED
ORIGINAL SURVEY NOTE BOOK No.
TEMPERATURE
AREA
WIND DIRECTION

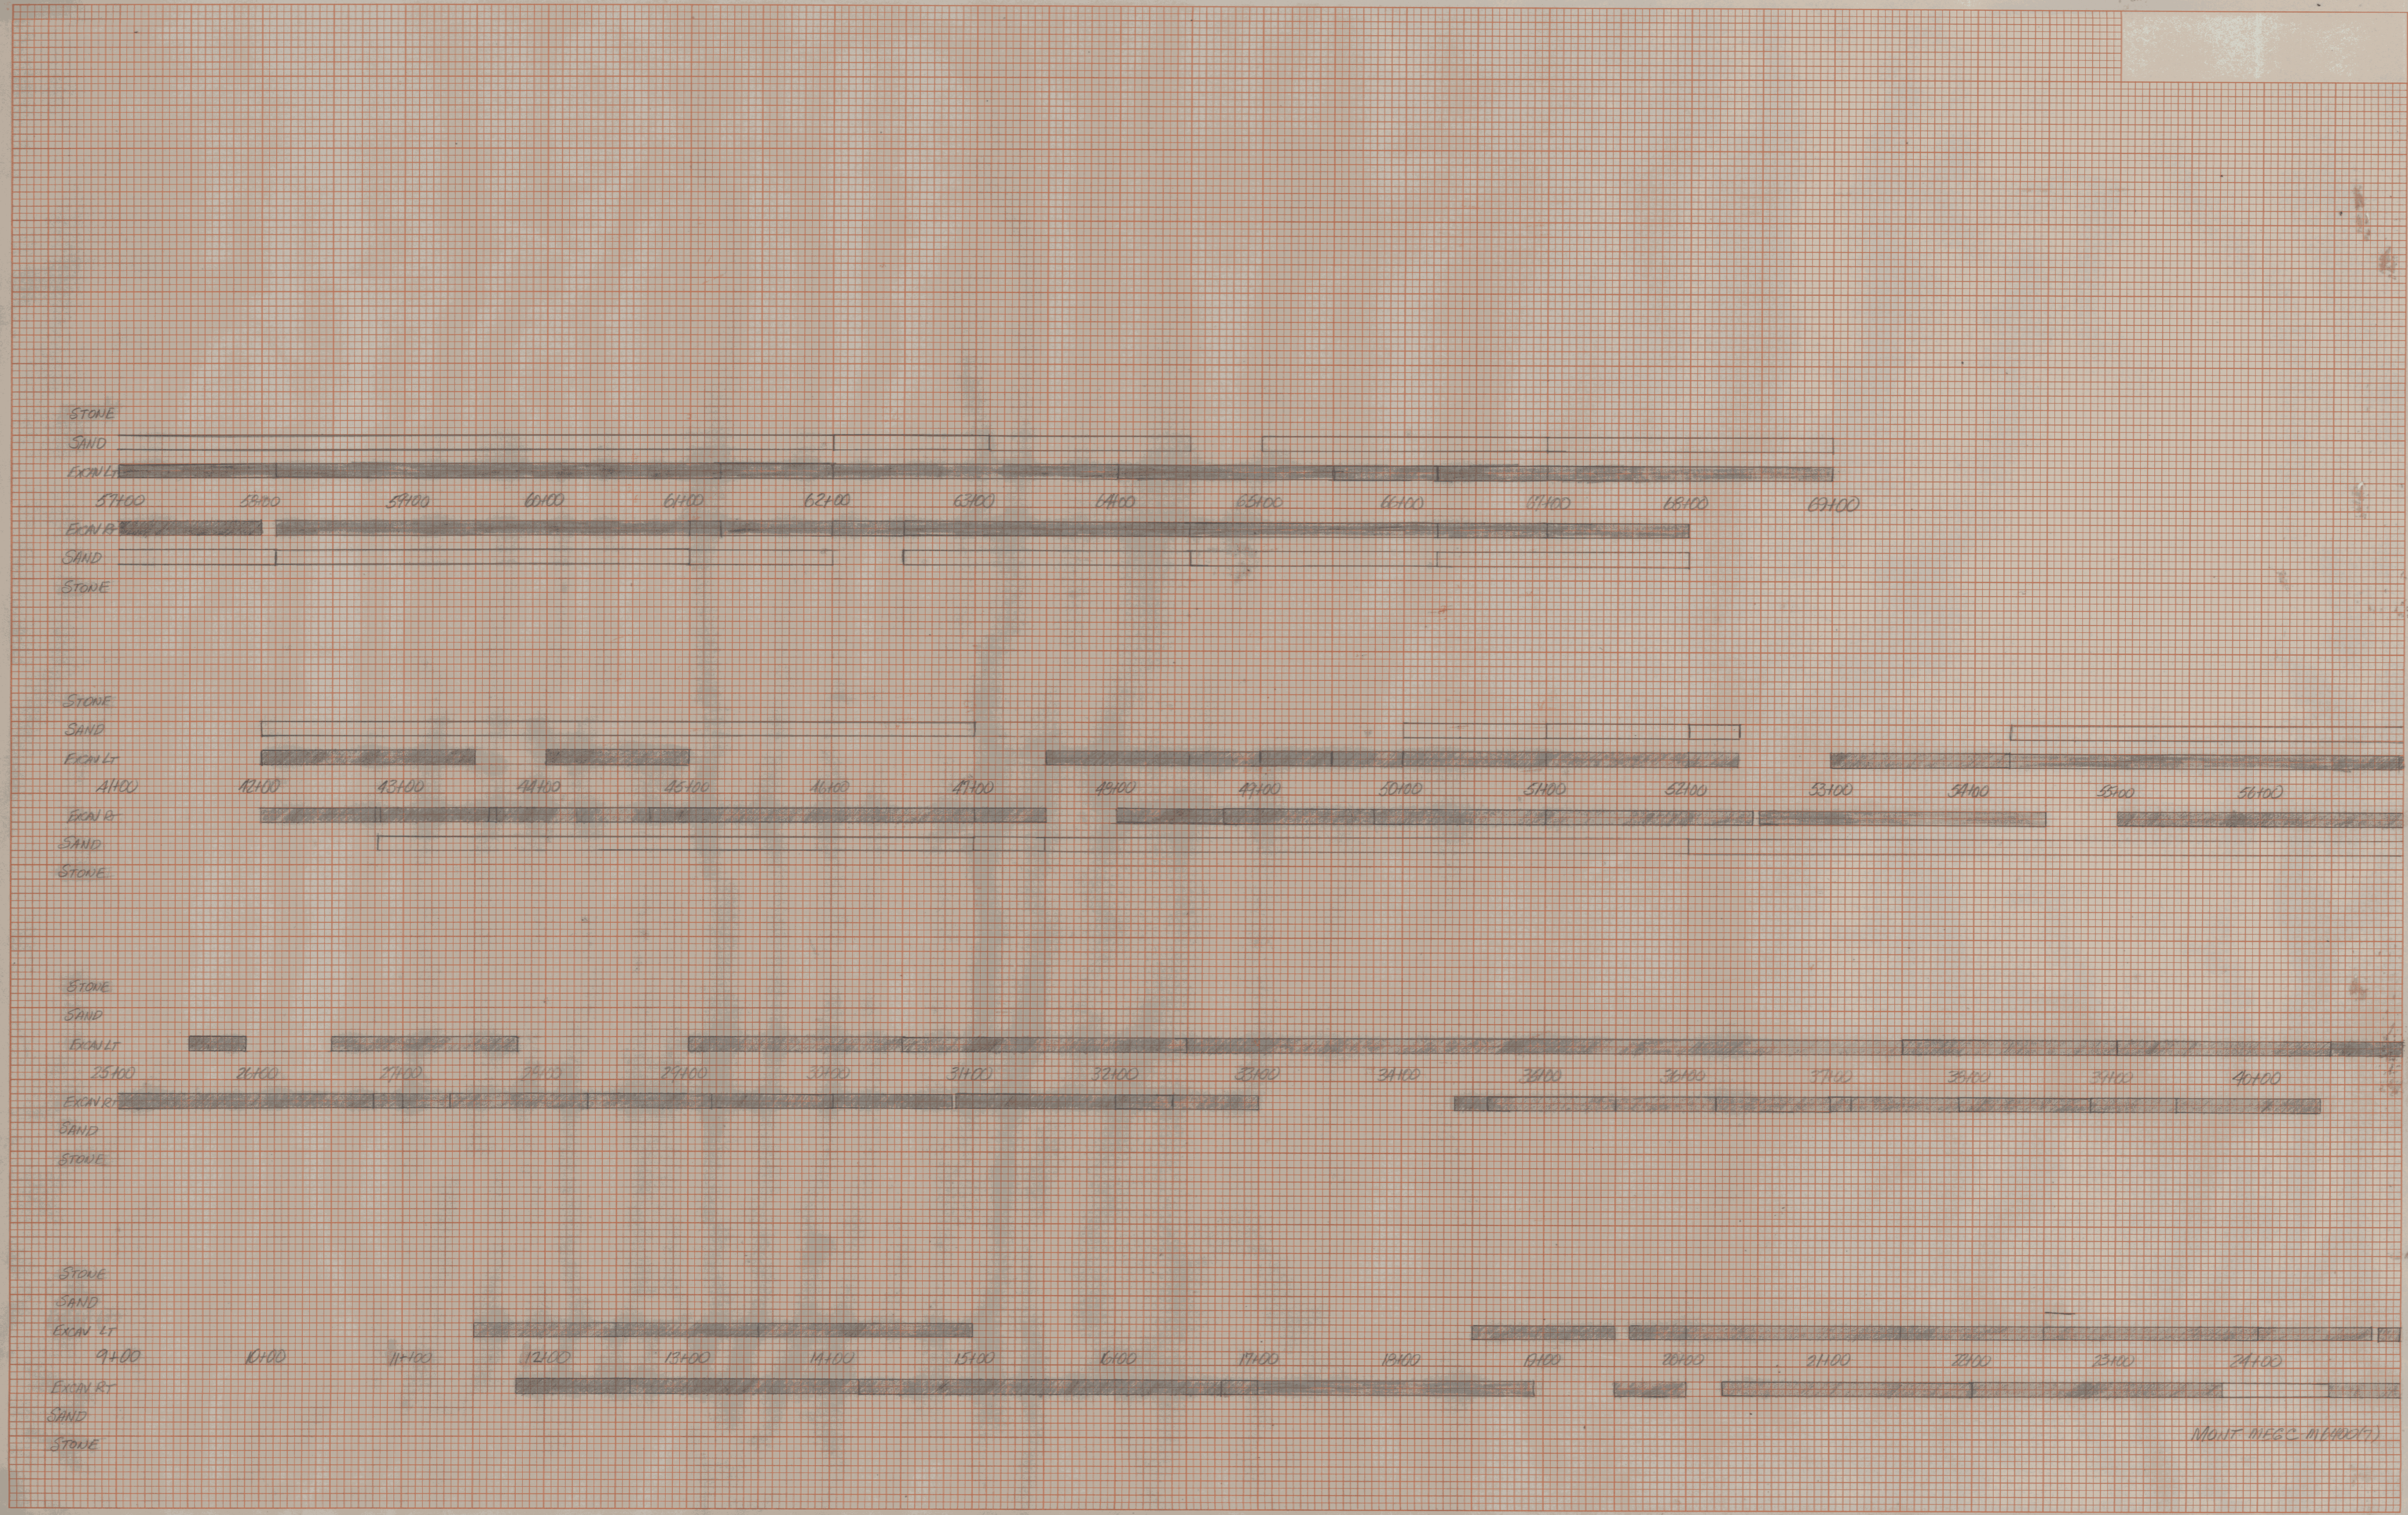

WONT. DIEGC. IN (100/1)