


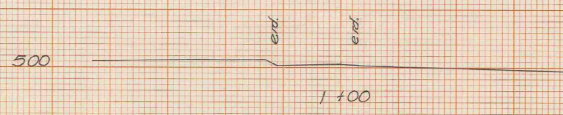


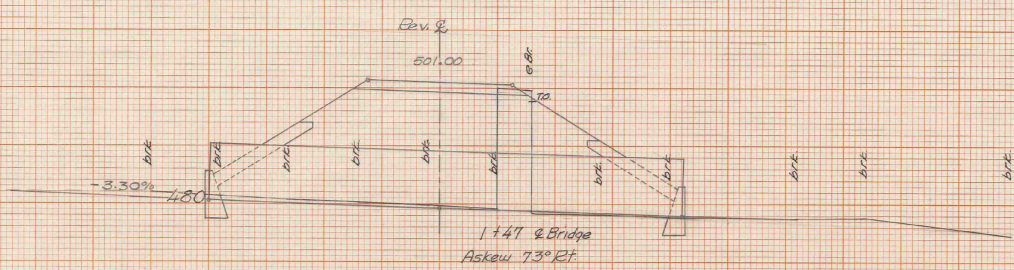

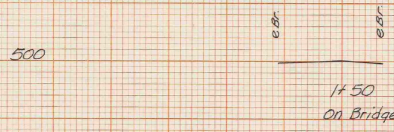

DATE \_\_\_\_\_  
BY \_\_\_\_\_  
PROJECT \_\_\_\_\_  
SHEET NO. \_\_\_\_\_  
DATE \_\_\_\_\_  
SCALE \_\_\_\_\_


DATE \_\_\_\_\_  
BY \_\_\_\_\_  
PROJECT \_\_\_\_\_  
SHEET NO. \_\_\_\_\_  
DATE \_\_\_\_\_  
SCALE \_\_\_\_\_

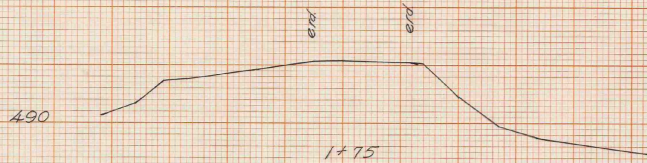


STATE OF VERMONT  
DEPARTMENT OF HIGHWAYS  
ROYALTON  
Robinson 11/3/75  
Hopkins  
SCALE 1 INCH = 10 FEET  
3 of 4  
1+00 1+75

DATE	
BY	
DESIGNED BY	
CHECKED BY	
IN CHARGE	
APPROVED	

DATE	
BY	
DESIGNED BY	
CHECKED BY	
IN CHARGE	
APPROVED	

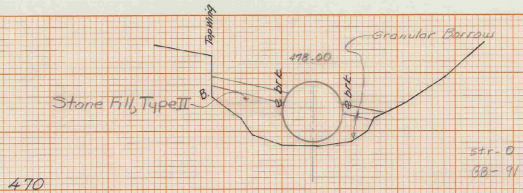

Sta. 0  
38-91

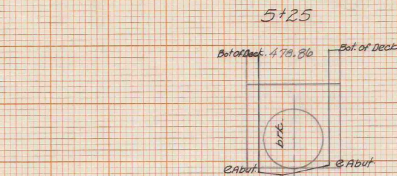


Sta. 5+10 Begin Stone Fill, Type II  
" " Begin Unclass. Chan. Exc.

Sta. 30  
GB - 240 - 79 = 161



Sta. 4+14 End Stone Fill, Type II


470

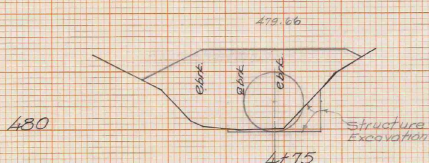

Sta. 26  
GB - 315


Sta. 4+69 End Unclass. Chan. Exc.  
Sta. 4+69 Begin Granular Borrow  
Sta. 4+70 Begin Structure Excavation  
Sta. 4+72 Begin Stone Fill, Type II  
" " Begin Unclass. Chan. Exc.

470

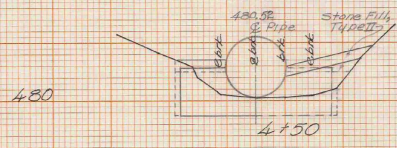


GB - 60  
Sta. 0  
Sta. 135


480

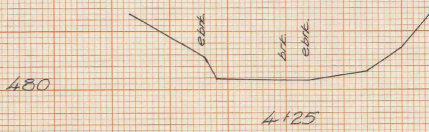

470

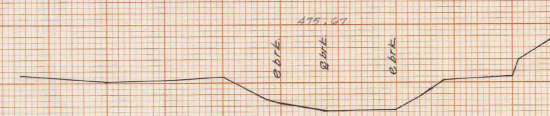


5+75

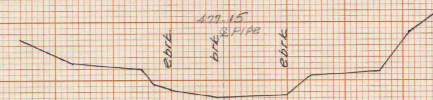

5+50

Sta. 5+31 End Structure Excavation  
Sta. 5+30 End Granular Borrow  
Sta. 5+35 End Stone Fill, Type II  
" " End Unclass. Chan. Exc.

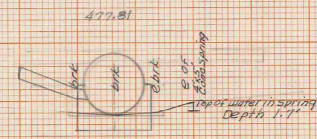

5+31  
Spring Pit

Sta. 84  
Sta. 9

Channel Sections  
No. POT 1+470 =  
96 POT 5+00  
Δ = 75° 00' RT.

STATE OF VERMONT
DEPARTMENT OF HIGHWAYS
TOWN OF ROYALTON
Locality Robinson 4/20/76
File Hopkins
SCALE: 1 INCH = 10 FEET
Plot No. Sheet A-4
Sta. 4+25 to Sta. 5+75

Bridge  
1976

Royalton  
TH 36 - C13

1976

BOX 3474



DONE

INITIALS



Vermont Agency of  
Transportation  
PHASE 3-INTERSTATE