

INDEX OF SHEETS

1. COVER SHEET
2. QUANTITY SHEET
3. RAIL & FASCIA REPAIRS
4. SCUPPER & EXPANSION JOINT DETAILS
- STANDARD DETAIL SHEETS
5. E-3 R-14 MAY 74
6. G-1 R-4 JUN 74
7. SCB-D6-73 R-29 DEC 75-DETAIL A

RECORD PLANS-MATERIALS

RUTLAND TH 2610 BRIDGE  
 CONTRACTOR-BRIDGES INC. MONTPELIER,VT.  
 CONTRACT DATED- 12 MAY 1976  
 CONSTRUCTION BEGAN- 7 JUNE 1976  
 CONSTRUCTION COMPLETED- 24 AUGUST 1976  
 ACCEPTED- 31 AUGUST 1976  
 RES.ENGR.-HOWARD P. BARNES

RECORD PLANS-PAUL E. SINGLETON

STATE OF VERMONT  
 DEPARTMENT OF HIGHWAYS



PROPOSED IMPROVEMENT

BRIDGE PROJECT  
 TOWN OF RUTLAND  
 COUNTY OF RUTLAND

ROUTE No TH-1-CL-2 BRIDGE No B5

PROJECT LOCATION BEGINNING AT A POINT ON TH#1 (CL-2) APPROX. 0.84 MILE NORTH OF THE TH#1-US ROUTE 7 INTERSECTION AND EXTENDING NORTHERLY ALONG TH#1 FOR 0.055 MILES.

PROJECT DESCRIPTION THIS PROJECT CONSISTS OF INSTALLING NEW EXPANSION JOINTS AT THE PIERS, A NEW HEAVY DUTY BRIDGE RAIL, ALSO CLEANING & PAINTING OF STRUCTURAL STEEL, PLUGGING OF WINDSLOTS, LIMITED APPROACH WORK AND OTHER REPAIRS AS INDICATED WITHIN THESE PLANS.


LENGTH OF STRUCTURE:	207 FEET
LENGTH OF PARTICIPATION ROADWAY:	23.74 FEET
LENGTH OF NON-PARTICIPATION ROADWAY:	17.26 FEET
LENGTH OF PROJECT:	290.74 FEET

GENERAL NOTES

1. ITEM 637.10 MAINTENANCE OF TRAFFIC FOR BRIDGE PROJECTS WILL CONSIST OF MAINTAINING A 12' (MIN) TRAVEL LANE THROUGH THE PROJECT DURING WORKING HOURS. DURING NON-WORKING HOURS THE TRAVELED PORTION OF THE BRIDGE WILL BE 24' OR AS DIRECTED BY THE ENGINEER. ALL FLASHES, SIGNS, BARRICADES AND OTHER ACCESSORIES NECESSARY FOR THE HANDLING OF TRAFFIC WILL BE INCLUDED IN THE LUMP SUM PRICE FOR ITEM 637.10.
2. ALL WORK AND MATERIALS SHALL BE IN ACCORDANCE WITH THE STANDARD SPECIFICATIONS FOR HIGHWAY AND BRIDGE CONSTRUCTION BY THE STATE OF VERMONT DEPARTMENT OF HIGHWAYS, DATED JANUARY 1976.
3. THE CONCRETE REMOVAL AND REPAIR LIMITS SHOWN ON THE PLANS ARE ONLY APPROXIMATE AND ARE SUBJECT TO REVISION BY THE ENGINEER. THE CUT SURFACE WILL BE AIR BLAST CLEANED AND COATED WITH EPOXY BONDING COMPOUND BEFORE PLACING NEW CONCRETE.
4. THE ENTIRE SURFACE OF ALL FASCIA BEAMS AND ALL BEARINGS WILL BE CLEANED AND PAINTED IN ACCORDANCE WITH ITEM 419.35. PAINTING, BLAST CLEANING, THE LUMP SUM PRICE WILL ALSO INCLUDE SPOT CLEANING OF THE THREE INTERIOR BEAMS AS DIRECTED BY THE ENGINEER. ALL INTERIOR BEAMS WILL ALSO BE PAINTED.
5. THE COST OF EXPANSION BOLTS FOR THE INSTALLATION OF HEAVY DUTY STEEL BEAM BRIDGE RAIL AND EXPANSION DEVICES AT PIER SHALL BE INCLUDED IN THE UNIT BID PRICE FOR THESE TWO ITEMS.
6. THE COST OF NEW EXPANSION BOLTS, IF NOT SPECIFIED, SHALL BE INCLUDED IN THE UNIT BID PRICE FOR THESE TWO ITEMS.


CONVENTIONAL SIGNS

- COUNTY LINE
- TOWN LINE
- LIMITS OF ACCESS
- POINT OF ACCESS
- FENCE LINE
- STONE WALL
- TRAVELED WAY
- GUARD RAIL
- RAILROAD LINE
- SURVEY LINE
- CULVERT
- POWER POLE
- TELEPHONE POLE
- TREES
- FA CONST IDENTIFICATION SIGNS
- PROPERTY LINE
- ROW TAKING LINE
- SLOPE RIGHTS
- TOP OF CUT
- TOE OF SLOPE

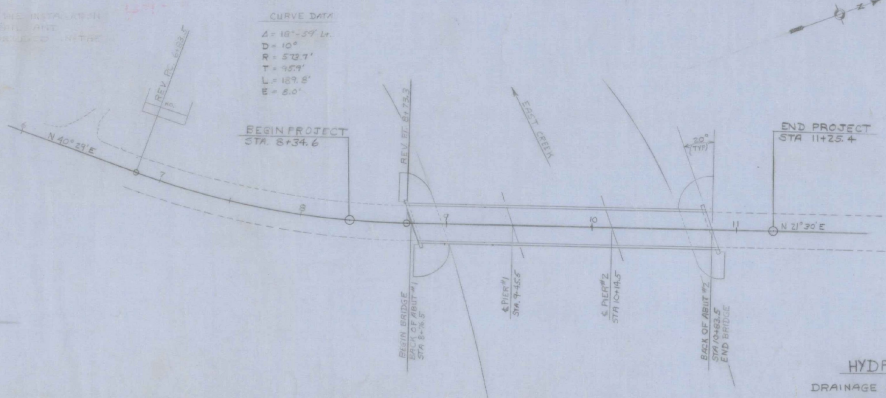

HYDRAULIC DATA


DRAINAGE AREA	44.8 SQ MI.
Q <sub>10</sub> = 1900 CFS	H.W. ELEV = 90.5'
Q <sub>50</sub> = 2800 CFS	= 91.2'
Q <sub>100</sub> = 3500 CFS	= 91.6'
Q <sub>1000</sub> = 4300 CFS	= 92.0'
TAILWATER EL. @ Q <sub>25</sub> = 90.7' (BASED ON 1944 PLAN DATA)	
VELOCITY THRU BRIDGE @ Q <sub>50</sub> = 7.7 FPS.	

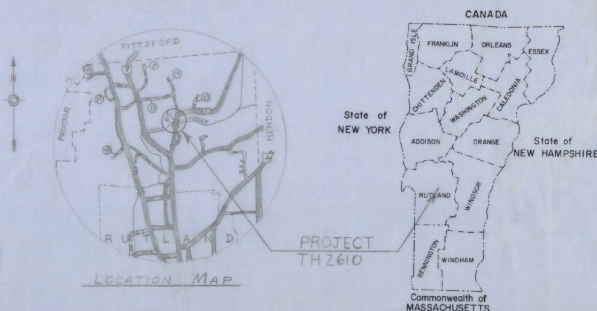

TAR EMULSION-PIKE INDUSTRIES INC. MIDDLEBURY,VT.  
 BITUMINOUS CONCRETE PAVEMENT-PIKE INDUSTRIES INC. MIDDLEBURY,VT.  
 CONCRETE- JOSEPH CARRARA AND SONS -NORTH CLARENDON,VT.  
 STRUCTURAL STEEL-VERMONT STRUCTURAL STEEL-BURLINGTON,VT.  
 PIONEER STEEL ENGINEERING INC.-GREENFIELD,MASS.  
 WATER REPELLENT-KIBBY EQUIPMENT CO. WHITE RIVER JCT.,VT.  
 ELASTOMERIC EXPANSION-A.H.HARRIS AND SONS,INC. HYDE PARK,MASS.  
 EPOXY BONDING COMPOUND-DURAL INTERNATIONAL CORP.,DEER PARK,N.Y.  
 BRIDGE RAILING  
 GUARD RAIL-HEAVY DUTY BRISWOLD FENCE CO. WILLISTON,VT.  
 ANCHOR FOR STEEL BEAM GUARD RAIL

NOTE: ANY FURTHER INFORMATION CONCERNING FINAL QUANTITIES, AMOUNTS OR OTHER DETAILS RELATIVE TO THIS PROJECT MAY BE FOUND IN EITHER THE FIELD BOOKS OR THE ESTIMATE FILE.

TYPICAL BRIDGE SECTION

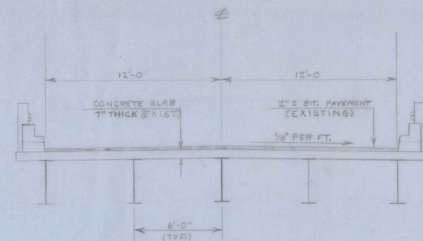

BUILT AS DESIGNED

These plans are subject to such engineering changes as may be required by the Federal Highway Administration or the Chief Engineer. Construction is to be carried on in accordance with these plans and the Standard Specifications for Highway and Bridge Construction dated January 3, 1972 as approved by the Federal Highway Administration on December 28, 1971 for use on this project, including all subsequent revisions and such revised specification and special provisions as are incorporated in these plans.

SUBMITTED BY ORDER OF THE STATE HIGHWAY BOARD

APPROVED *E. H. Wickham* DATE *3/24/76*  
 CHIEF ENGINEER

PROJECT NO. RUTLAND TH 2610  
 SHEET 1 OF 7 SHEETS






ITEM 621.36 - HEAVY DUTY ST. BEAM G.R. W/ST POSTS (TYPE II) (1/3 SPC)





STATION	UNFACTORED LENGTH	F	FACTORED LENGTH
LT 8+58.6-8+72.1	12.5	1.2	15.0
LT 10+79.1-10+91.6	12.5	1.2	15.0
RT 8+68.4-8+80.9	12.5	1.2	15.0
RT 10+87.9-11+00.4	12.5	1.2	15.0

ITEM 621.72 ANCHOR FOR ST BM GUARD RAIL W/ST, LIGHT ST, OR WOOD POSTS.

STATION	QUANTITY
LT 8+58.6	1EA
LT 10+91.6	1EA
RT 8+68.4	1EA
RT 11+00.4	1EA

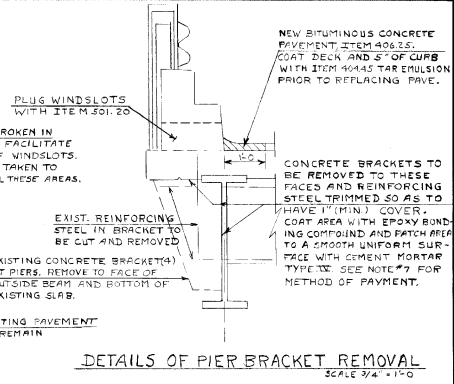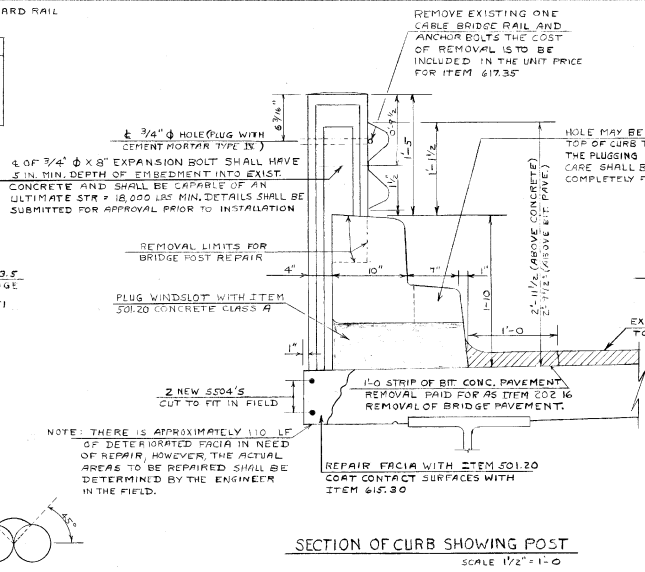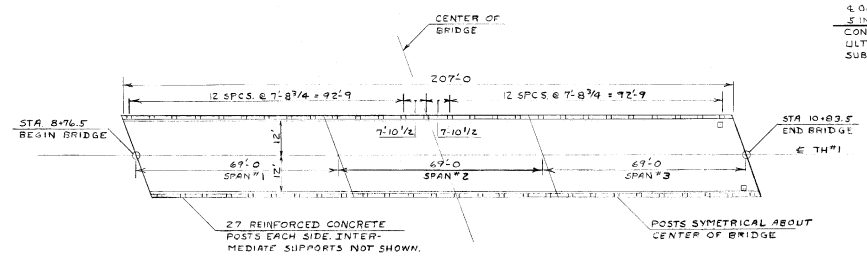

WELDED SPICE DETAIL FOR BRIDGE RAIL POST REPAIR

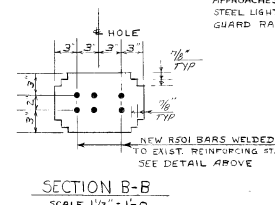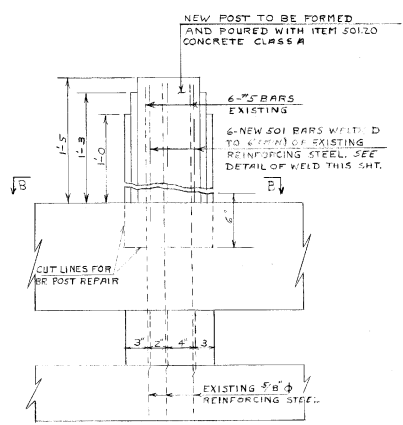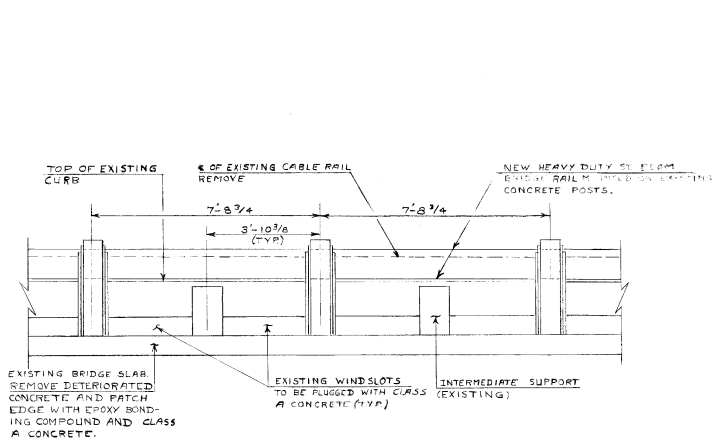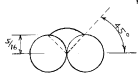

REINFORCING SCHEDULE (AS SHOWN TO F31, GRACE 4)

NO	PIECES	SIZE	LENGTH	MARK	TYPE
26	5	1-7	RS01	STR.	
8	5	1-6	SS02	STR.	
8	5	2-5	SS03	STR.	
6	5	4-0	SS04	STR.	


NOTE: APPROXIMATELY SIX BRIDGE RAIL POSTS ARE BROKEN AND NEED REPAIR AS DETAILED ABOVE, HOWEVER IT MAY BE NECESSARY (AS DETERMINED BY THE ENGINEER) TO REPAIR ADDITIONAL POSTS. IF THIS IS THE CASE ADDITIONAL RS01 BARS WILL BE NEEDED.

NOTES


1. ALL NEW CONCRETE USED FOR PLUGGING WINDSLOTS, INSTALLING SCUPPERS REPAIRING THE BRIDGE RAIL POSTS AND THE FACIA EDGE WILL BE CONCRETE CLASS A ITEM 501.20.
2. DIMENSIONS SHOWN ON THE PLANS ARE TAKEN FROM OLD PLANS (RUL AND STS 12) AND STANDARDS FOR THIS PRODUCT AND SHOULD BE FIELD CHECKED FOR ACCURACY PRIOR TO CONSTRUCTION.
3. REINFORCING STEEL WILL HAVE A 2" CLEARANCE UNLESS SHOWN OTHERWISE ON THE PLANS.
4. ANY CLEANING, BENDING, SPICING OR WELDING OF REINFORCING STEEL WILL BE CONSIDERED SUBSIDIARY TO ITEM 501.18 REINFORCING STEEL AND THE COST FOR SAME WILL BE INCLUDED IN THE UNIT BID PRICE FOR ITEM 501.18.
5. BRIDGE RAIL-HEAVY DUTY STEEL BEAM SHALL INCLUDE THE FURNISHING AND INSTALLATION OF HEAVY DUTY STEEL BEAM RAIL ON THE EXISTING CONCRETE POSTS AND ALL THE INCIDENTAL HARDWARE AND LABOR NECESSARY FOR THE COMPLETION OF THE ITEM.
6. A TRANSFLEX 150AC EXPANSION JOINT IS DEPICTED AS THE NEW JOINT USED AT THE PIERS, HOWEVER AN EQUIVALENT DEVICE MAY BE SUBMITTED TO THE VERMONT HIGHWAY DEPARTMENT BRIDGE ENGINEER FOR APPROVAL.
7. PATCH ENDS OF CONCRETE PIER DIAPHRAGMS WITH MORTAR TYPE IV (SECTION 709.04). THE COST OF THE MORTAR AND LABOR FOR THIS PATCHING WILL BE INCLUDED IN THE UNIT BID PRICE FOR ITEM 702.10. THIS ITEM WILL ALSO BE NECESSARY FOR CLEANING ALL LOOSE MATERIAL FROM THE TOP OF THE DIAPHRAGM.
8. SCUPPERS ARE TO BE FABRICATED OF A36 STRUCTURAL STEEL AND GALVANIZED IN THEIR ENTIRETY IN ACCORDANCE WITH ASTM I23 SPECIFICATIONS.
9. ITEM 514.10 WATER REPELLENT WILL BE PLACED ON ALL EXPOSED CONCRETE IN THE CURB AND FASCIA AREA INCLUDING THE CONCRETE BRIDGE RAIL POSTS AND ALL FASCIA CONCRETE OUTSIDE OF THE FASCIA BEAM. CARE SHALL BE TAKEN TO PREVENT SPALLS ON NEW BIT PAVE AREAS.
10. NEW HEAVY DUTY STEEL BEAM GUARD RAIL WITH STEEL POSTS TYPE II ITEM 621.36 WILL BE INSTALLED AT EACH CORNER OF BRIDGE APPROACHES ITEM 621.72 ANCHOR FOR STEEL BEAM GUARD RAIL WITH STEEL LIGHT STEEL OR WOOD POSTS WILL BE USED WITH EACH RUN OF GUARD RAIL.

**STATE OF VERMONT**  
**DEPARTMENT OF HIGHWAYS**


TOWN OF	RUTLAND	Bridge No.	25
HIGHWAY NO.	TH 1 - CLASS 2	Log Sta.	
<b>TH 1 OVER EAST CREEK</b>			
<b>BRIDGE RAIL FACIA REPAIRS</b>			
Designed by	D PERHINS	Drawn by	D PERHINS
Checked by	K. Hell	Bridge Design Supervisor	
	date Mar 76	E Date	date 3/76
PROJECT	RUTLAND	PROJECT NO.	TH 2610
Bridge Sheet No.		Sheet	3 of 7

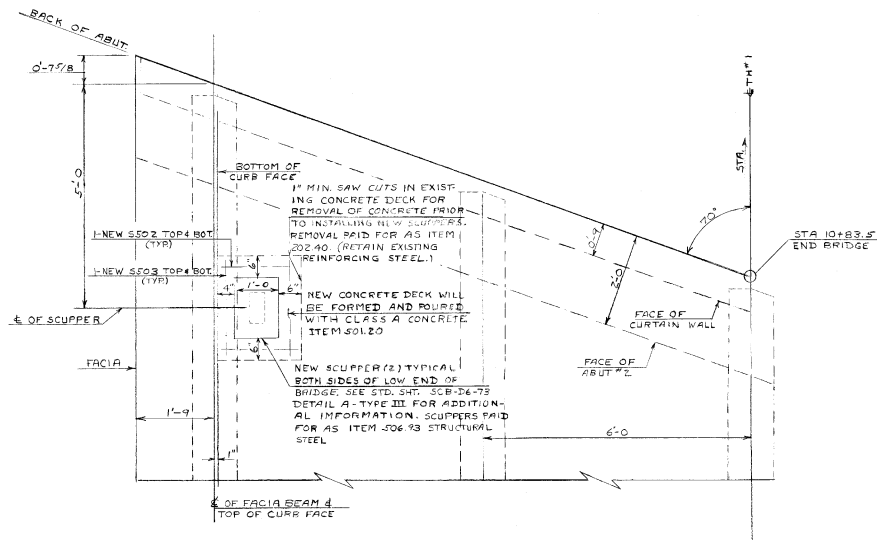


PARTIAL PLAN OF BRIDGE DECK  
SHOWING NEW SCUPPER DETAILS  
SCALE 3/4" = 1'-0"

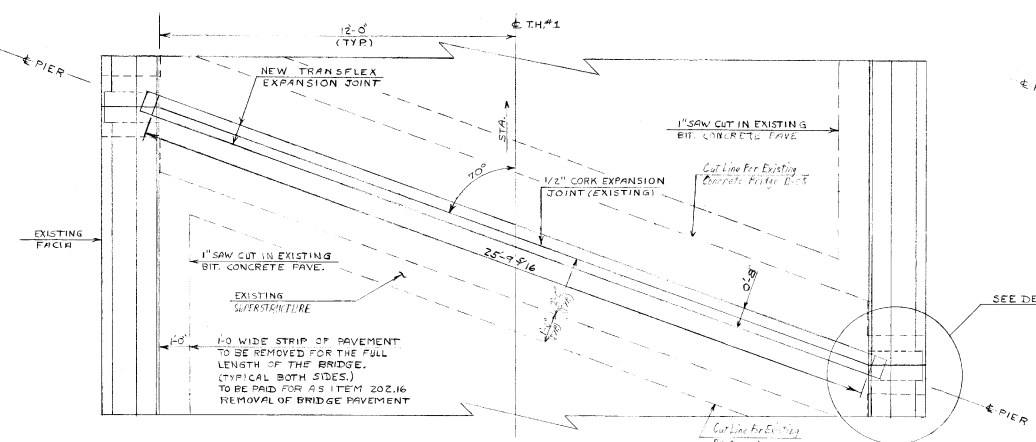


DECK PLAN SHOWING EXPANSION JOINT @ PIER  
SCALE 1/2" = 1'-0"

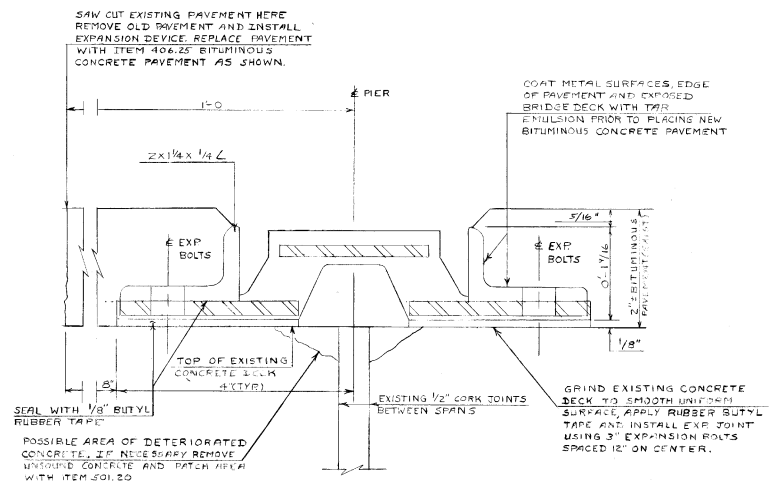

TYPICAL SECTION OF EXPANSION JOINT  
TRANSFLEX-150 AC SHOWN

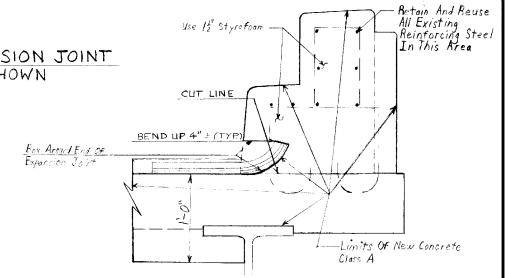

SECTION C-C  
SCALE 1/2" = 1'-0"

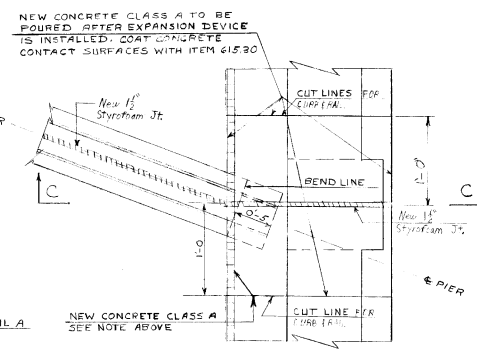


DETAIL A  
SCALE 1/2" = 1'-0"

REVISIONS  
1. Revised Detail 'A' To Show New Styrofoam Joint In Curt Line And Bolt.  
2. Revised Section C-C Showing Bolts In Of Expansion Joint, End.  
3. Revised 'Deck Plan' Showing New Conc. And Bolt Cut Lines.  
D. Perkins & D. Willey  
June 76


- NOTES
- ALL FIELD WELDING SHALL BE DONE BY SKILLED CERTIFIED WELDERS IN ACCORDANCE WITH THE SPECIFICATIONS FOR THE STRUCTURAL WELDING CODE OF THE AMERICAN WELDING SOCIETY.
  - FABRICATORS DRAWINGS OF EXPANSION DEVICES WILL BE SUBMITTED TO THE VT. HIGHWAY DEPT. BRIDGE ENGINEER FOR APPROVAL.

STATE OF VERMONT  
DEPARTMENT OF HIGHWAYS

TOWN OF	RUTLAND	Bridge No.	75
HIGHWAY NO.	TH11-CLASS Z	Log Sta.	
		Surv. Sta.	
TH11 OVER EAST CREEK			
SCUPPER & EXPANSION JOINT DETAILS			
Designed by	D. PERKINS	Drawn by	D. PERKINS
Checked by	D. HELL	Bridge Design Supervisor	E. BERT
	date Mar 76		date 3/76
PROJECT	RUTLAND	PROJECT NO.	TH2610
Bridge Sheet No.		Sheet	4 of 7

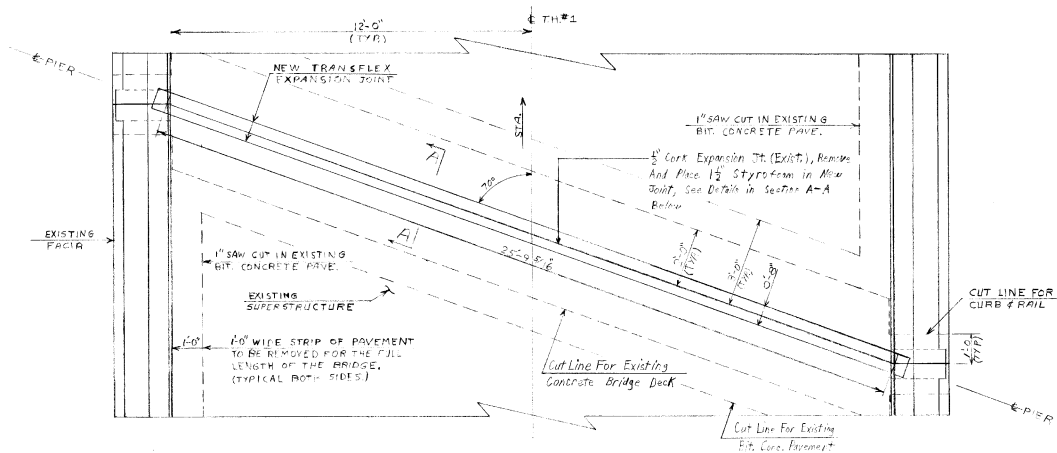

REVISED EXPANSION JT. @ PIERS #1 & #2  
Scale 1/2"=1'-0"

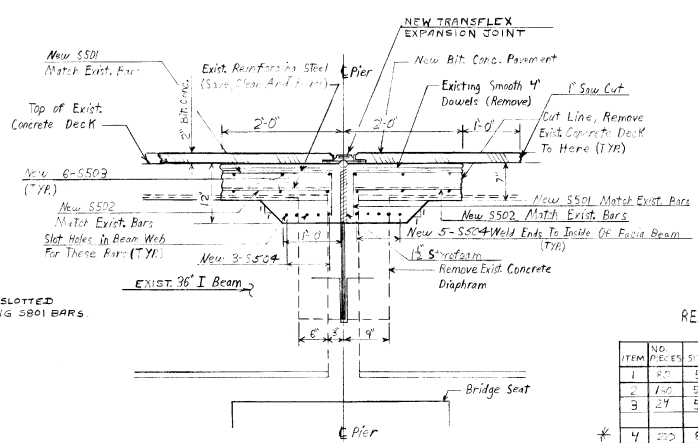

SECTION A-A  
Scale 1/2"=1'-0"


REINFORCING STEEL SCHEDULE  
AASHTO M31, GRADE 60

ITEM	NO.	PIECES	SIZE	LENGTH	MARK	TYPE	A	B	C	D
1	107	5	2'-0"	S504	17		8	7-9		
2	140	5	25'-6"	S502	17c					
3	24	5	25'-0"	S502	17c					
4	202	8	26'-0"	S504	17c					


\* S504 BARS REPLACE 7-201'S AS PER W.M.S. 6-28-76 D.C.P.

NOTES

1. All Existing Concrete Surfaces To Be In Contact With New Concrete Shall Be Coated With Item 615.30, Epoxy Bonding Compound.
2. Concrete Removal At PIER Expansion Joints Will Be Paid For As Item 202.35, Removal Of Existing Concrete Or Masonry.
3. Item 501.20, Concrete Class A Will Be Used To Reinstruct Top Bridge Deck At The Pier Expansion Joints.
4. Payment For 1 1/2" Styrofoam Expansion Material Used At Piers 1 & 2 Expansion Joints Shall Be Included In The Lump Sum Price Of Item 501.20, Concrete Class A.

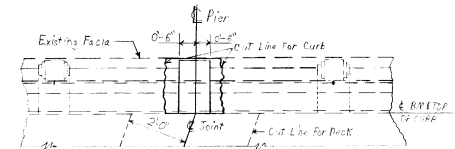

PLAN OF RAIL & CURB  
AT & OF PIERS 1 & 2  
Scale 1/2"=1'-0"

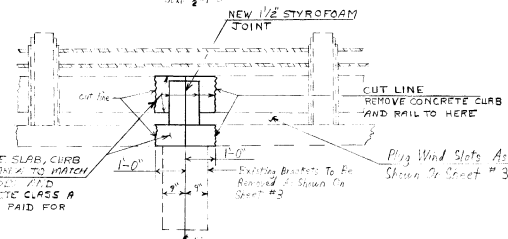


ELEVATION OF RAIL & CURB  
AT & OF PIERS 1 & 2  
Scale 1/2"=1'-0"

REBUILD THE CONCRETE SLAB, CURB AND RAIL IN THIS AREA TO MATCH THE EXISTING GRADE. 7.0' DIMENSIONS CONCRETE CLASS A WILL BE USED AND PAID FOR AS ITEM 501.20.

Remove Existing Brackets To Be Replaced & Sawn Ca. Spent #3

Place Wind Stops As Shown On Sheet # 3

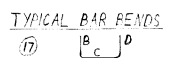

**STATE OF VERMONT**  
**DEPARTMENT OF HIGHWAYS**

TOWN OF RUTLAND Bridge No. 5

Highway No. TH #1 - CLASS 2 Log Sta.

TH #1 OVER EAST CREEK Surv. Sta.

REVISED EXPANSION JOINT DETAILS

Designed by W.M.S. Drawn by G. WILLE

Checked by J. Couture date 6-76 Bridge Design Supervisor

PROJECT RUTLAND TH #10 PROJECT NO. TH 2810

Bridge Sheet No. Sheet 4A of 7



Bridge  
1976

Rutland  
TH 2610

1976

Vermont Agency of  
Transportation  
PHASE 3-INTERSTATE

INITIALS

DONE

Box 3394