

Index of Sheets


1. Title, Plan, Profile, Typical
2. Plan, Profile
3. Earthworks, Grades & Cautions
4. Sections

Rev Data (office)
 Δ 13° 42' LT
 D 2°
 R 2864.79
 T 344.14
 L 685.0
 E 20.60
 Bank 0.27 ft

Parcel No. 3
 Elidore H. Gorton
 IO+00LT-15+90LT. 0.18A±
 IO+00LT-15+88LT. Slope Rights (T)
 Recorded in Shaftsbury W.D.
 Date 5-19-75 Bk. 56, Pg. 48

Parcel No. 4
 Conrad F. & Janet S. Metcalfe
 15+88LT-17+78LT. 935 S.F.±
 15+88LT-19+05LT. Slope Rights (T)
 Recorded in Shaftsbury
 Date 5-23-75 Bk. 56, Pg. 57

Rev. Data
 Δ 3° 31' Lt.
 D 0° 45'
 R 7639.44
 T 284.52
 L 468.89
 E 3.60
 Do Not Bank

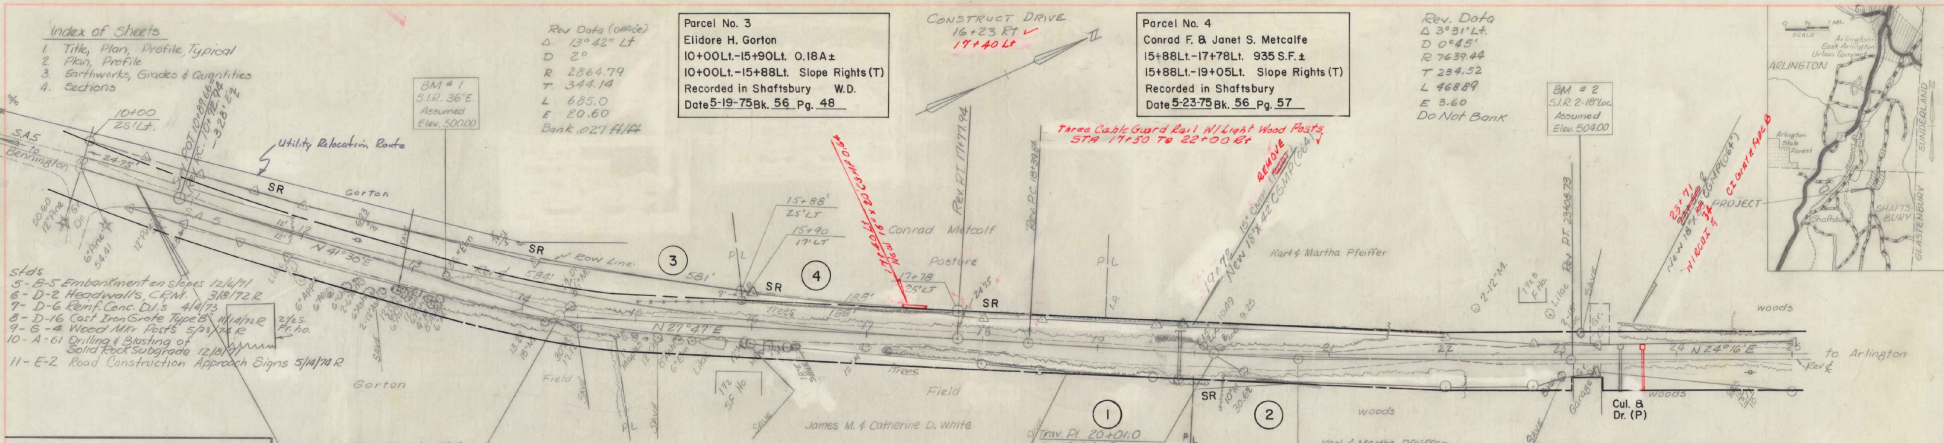

- Stds**
- 5-5.5 Embankment on slopes 1:1 to 1 1/2:1
 - D-2 Headwalls, CEM 3/8x12 R
 - D-6 Comp. Conc. D.I.s 4/4x3
 - D-16 Cast Iron Gate Type B 1/4x12
 - 9-6 Wood Wtr. Wtr. 5/4x12
 - 10-A-01 Drilling & Blasting of Solid Rock Subgrade 12/10/77
 - 11-E-2 Road Construction Approach Signs 5/14/78


SUBMITTED BY ORDER OF THE STATE HIGHWAY BOARD
 APPROVED: *E. M. Stebbins* DATE 1/7/74
 CHIEF ENGINEER
 DEPARTMENT OF TRANSPORTATION
 FEDERAL HIGHWAY ADMINISTRATION
 APPROVED: _____ DATE _____
 DIVISION ENGINEER
 APPROVED: *R. J. LeVine* DATE 1/13/75
 ROW DIRECTOR

Parcel no. 1
 James M. & Cathrine D. White
DELETED
 16+23Rt- Drive (T) Release
 Recorded in Shaftsbury Date _____ Bk. _____
 Pg. _____

Parcel no. 2
 Karl & Martha Pfeiffer
 19+85Rt-20+80Rt. Slope Rights (T) 360 S.F.±
 23+50Rt. Culvert & Drainage (P)
 WDOE
 Recorded in Shaftsbury Date 4-22-75 Bk. 56 Pg. 416-417


TOWN OF SHAFTSBURY
COUNTY OF BENNINGTON
 Town Highway #5 (Class II)
 Length of Roadway 1846.72 Feet = 0.3498 Mile
 Length of Bridges 0 Feet = 0 Mile
 Length of Project 1846.72 Feet = 0.3498 Mile
 Beginning at a point approximately 0.3498 miles
 southerly of the Shaftsbury-Arlington town line and
 extending in a northerly direction 1846.72 feet.

Traffic Data
 Accidents: 0
 1974 ADT 145
 1973 DHV 35
 T 54
 D 6
 V 40 MPH
 Sight Dist
 Hor 2900'
 Vert _____

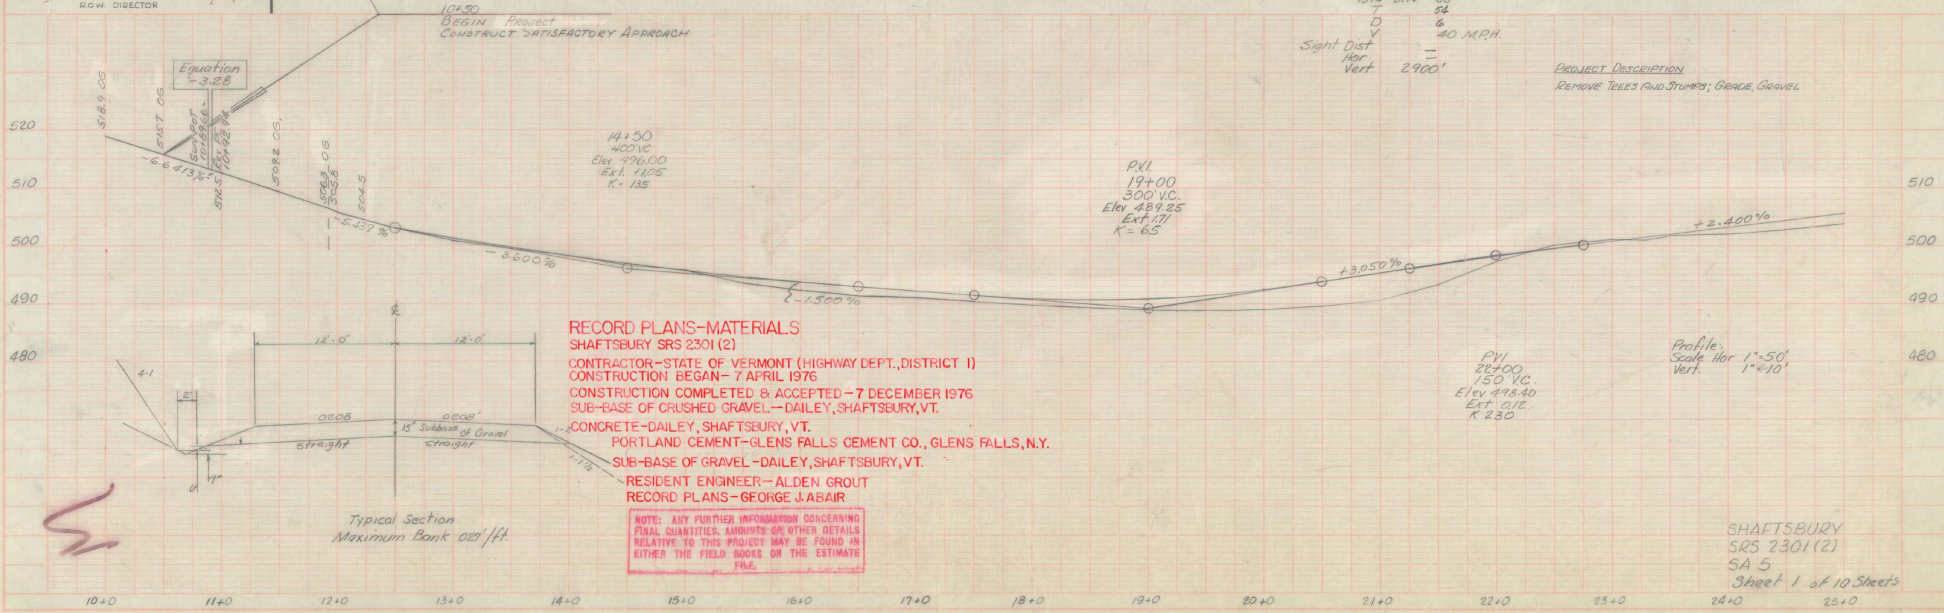

RECORD PLANS-MATERIALS
 SHAFTSBURY SRS 2301 (2)
 CONTRACTOR-STATE OF VERMONT (HIGHWAY DEPT., DISTRICT I)
 CONSTRUCTION BEGAN-7 APRIL 1976
 CONSTRUCTION COMPLETED & ACCEPTED-7 DECEMBER 1976
 SUB-BASE OF CRUSHED GRAVEL-DAILEY, SHAFTSBURY, VT.
 CONCRETE-DAILEY, SHAFTSBURY, VT.
 PORTLAND CEMENT-GLENS FALLS CEMENT CO., GLENS FALLS, N.Y.
 SUB-BASE OF GRAVEL-DAILEY, SHAFTSBURY, VT.
 RESIDENT ENGINEER-ALDEN GROUT
 RECORD PLANS-GEORGE J. ABAIR

NOTE: ANY FURTHER INFORMATION CONCERNING
 FINAL QUANTITIES, AMOUNTS OR OTHER DETAILS
 RELATIVE TO THIS PROJECT MAY BE FOUND IN
 EITHER THE FIELD BOOKS OR THE ESTIMATE
 FILE.

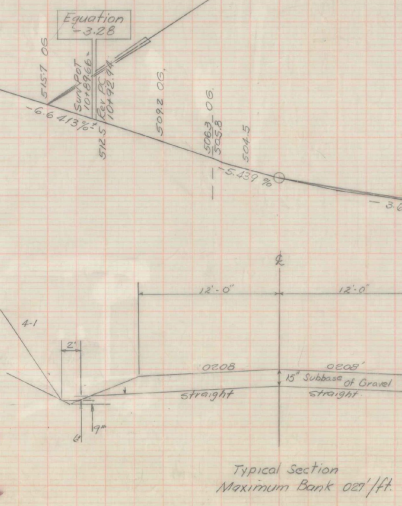

SHAFTSBURY
 SRS 2301 (2)
 SA 5
 Sheet 1 of 10 Sheets

Three Cable Guard Rail w/ Light Wood Posts
Sta 28+73 - 29+83.51

Rev. Data
 $\Delta 6^{\circ}15' \text{ L}$
 $D 2^{\circ}$
 $R 284.79$
 $T 156.41$
 $L 312.50$
 $E 4.27$
Bank 0.27 ft/ft

Approach
Location
Shaftsbury
Town Line

PT 29+48.8
SAS Trv PI 29+01.0
 $\Delta 6^{\circ}15' \text{ L}$

SAS Trv PI 33+42.7
 $\Delta 31^{\circ}35' \text{ RT}$

Rev PI 28+59.90 =
28+59.58

SAS Trv PI 29+01.0
 $\Delta 6^{\circ}15' \text{ L}$

BM # 3
S.I.R. 24'E
Assumed
Elev 521.62


0 50 100
Scale in Feet
1" = 50'

1. Parcel #1 deleted Per C.O. #2932
Ord. 5-22-75


29+00
END Project
CONSTRUCT SATISFACTORY APPROACH

Profile
Scale Hor. 1" = 50'
Vert. 1" = 10'




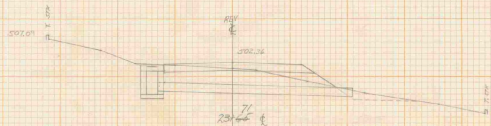


NEW 18" X 34" CGMP 0.064
 REDI W/ CAST IRON GRATE, TYPE B @ INLET
 DITCH @ OUTLET




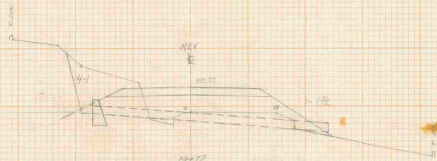


90° 15" CAP REMOVE
 NEW 90° 18" X 42" CEMP (0.064)

SHARPS PARK
 SKS 230 (2)
 5-26-76
 DRAINAGE

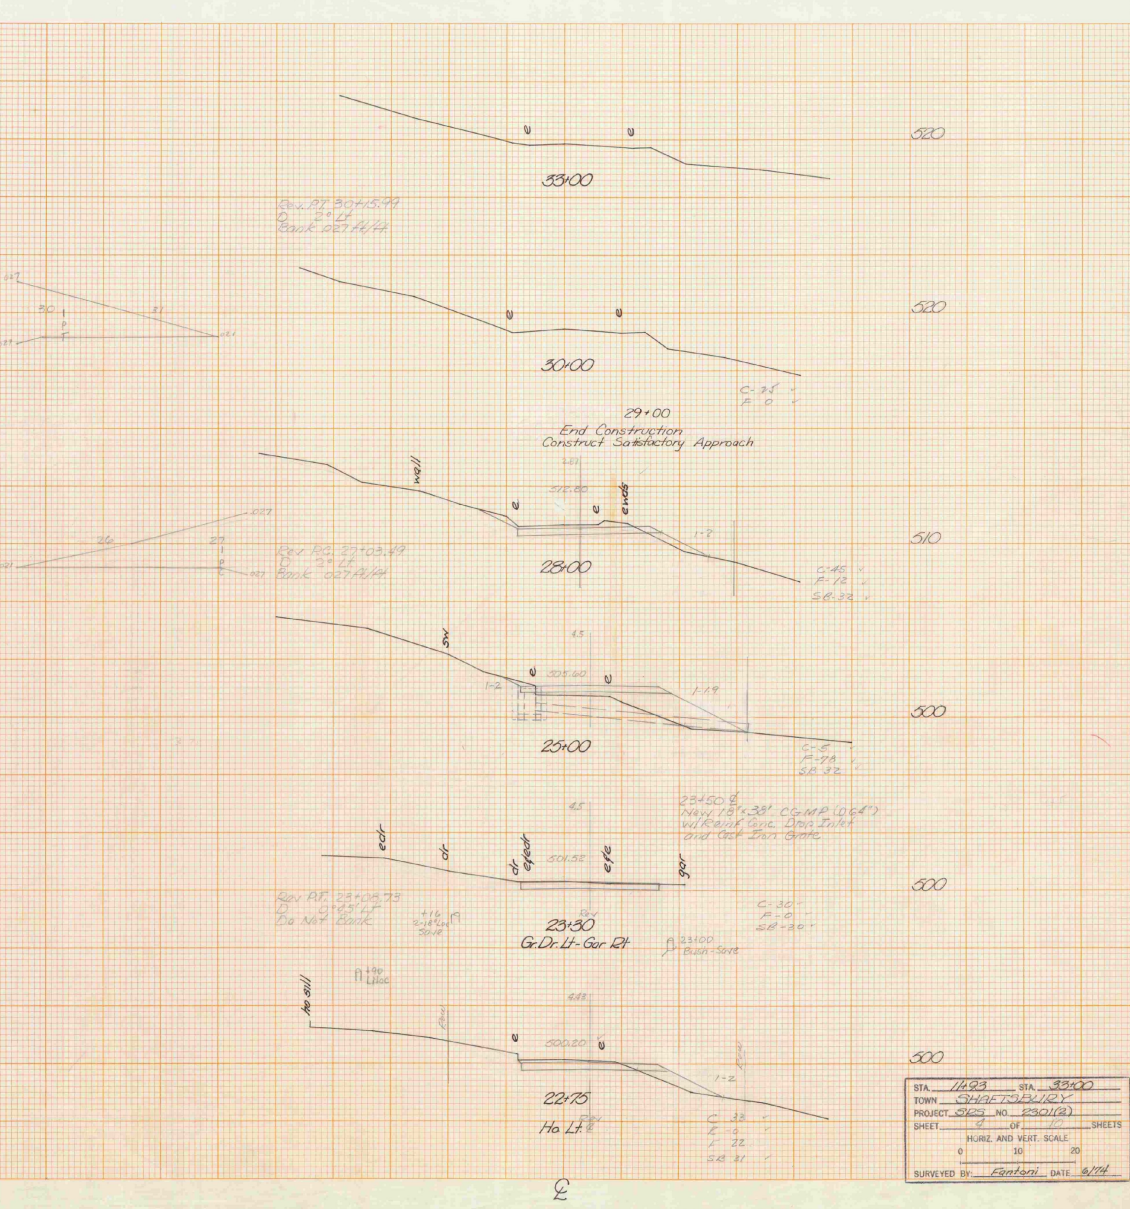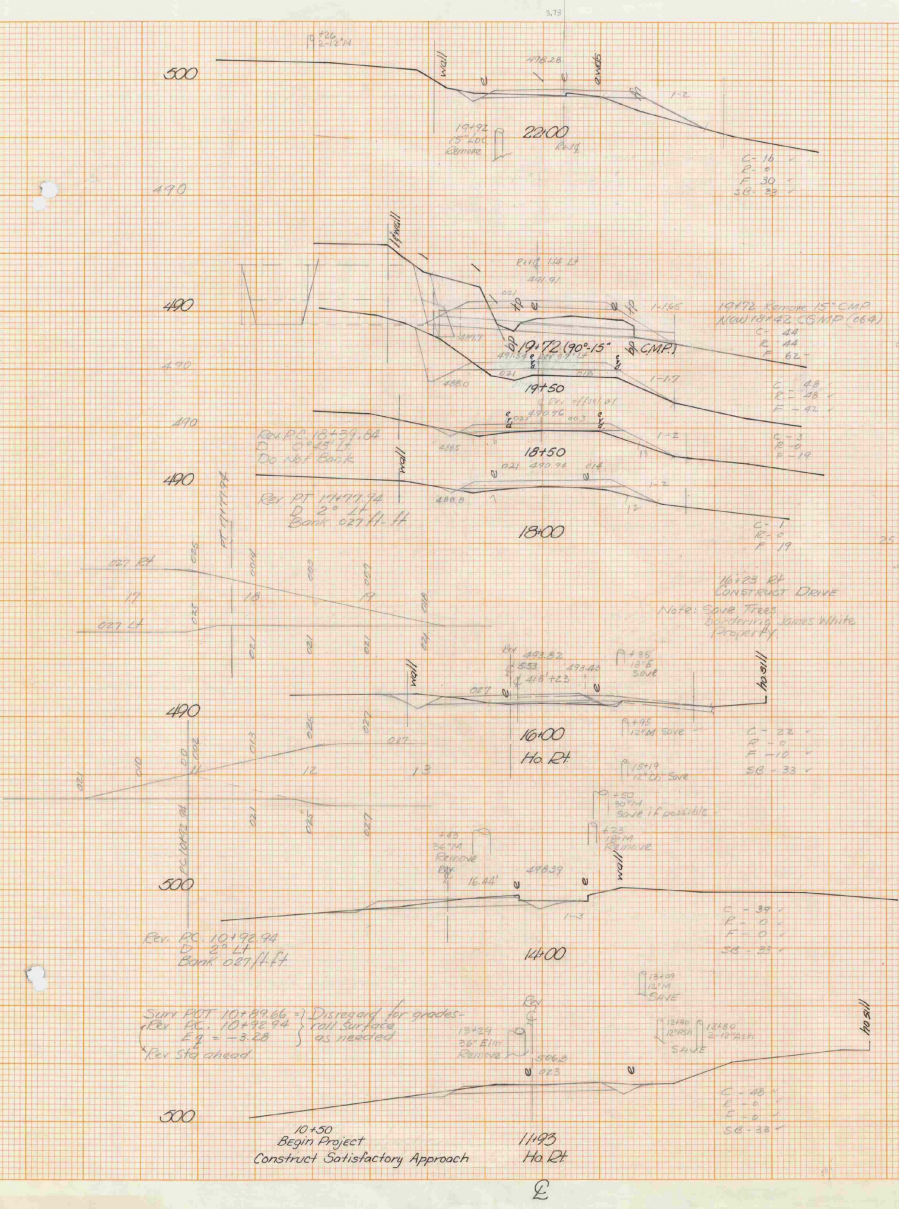

STA. 1193	STA. 3300
TOWN SHEETS 2512 Y	
PROJECT SHEET NO. 23012	
SHEET 2	SHEETS
HORIZ. AND VERT. SCALE	
1" = 20'	1" = 20'
SURVEYED BY: Fantoni DATE: 4/24	

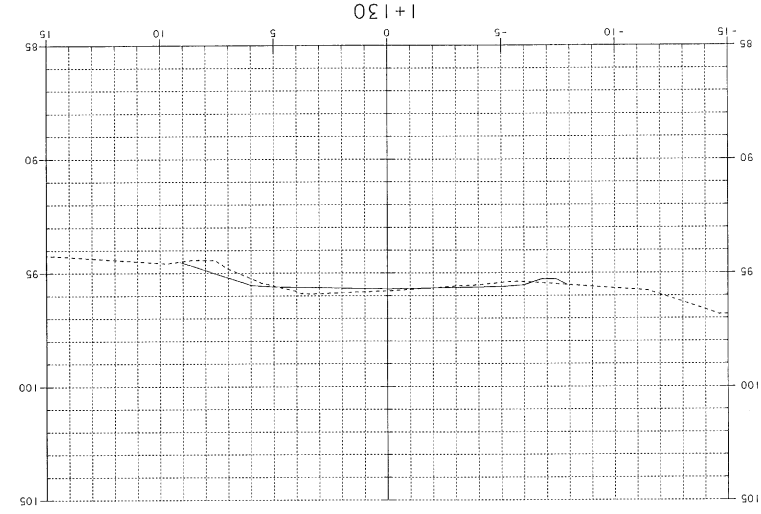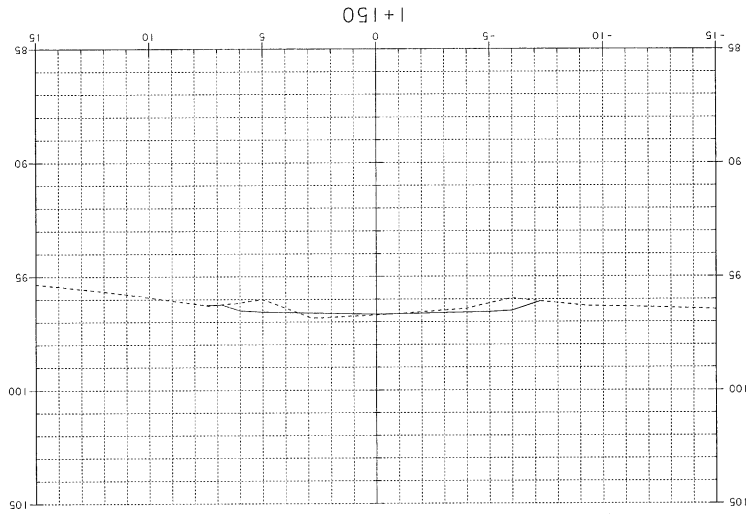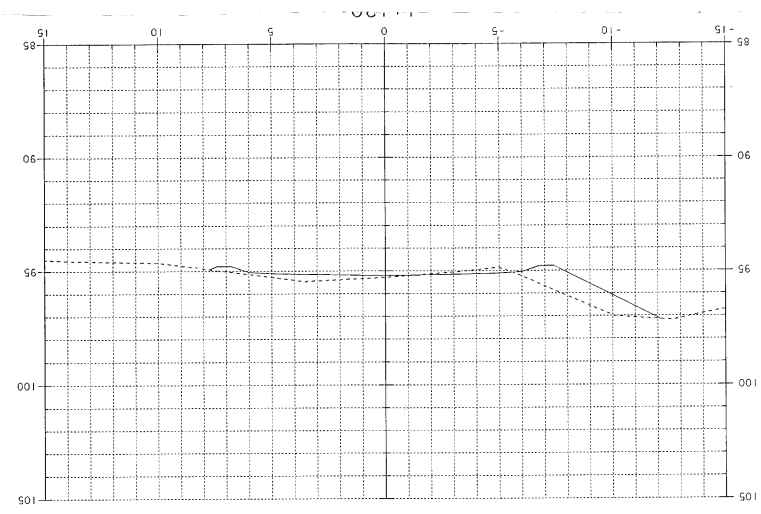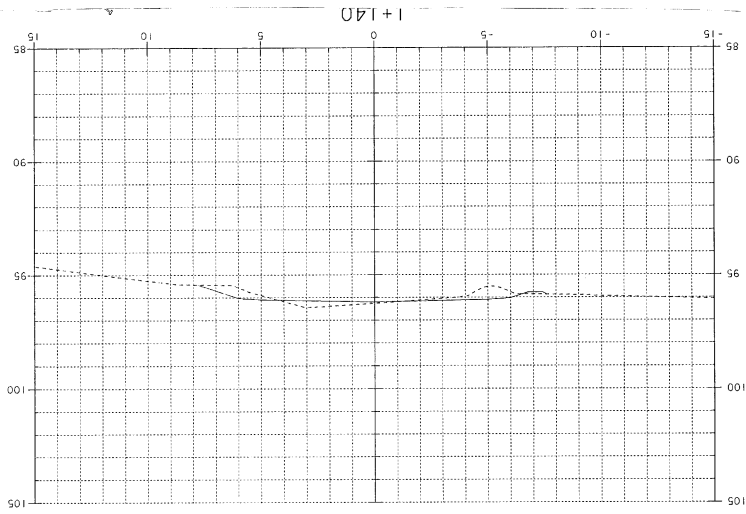

1976

Shaftsbury
SRS 2301 (2)

1976

Vermont Agency of
Transportation
Phase III- Interstate
#090303-01
INITIALS
Hanger 3728