



THIS SHEET TO BE USED  
FOR ROW INFORMATION ONLY

ROW DI ANS

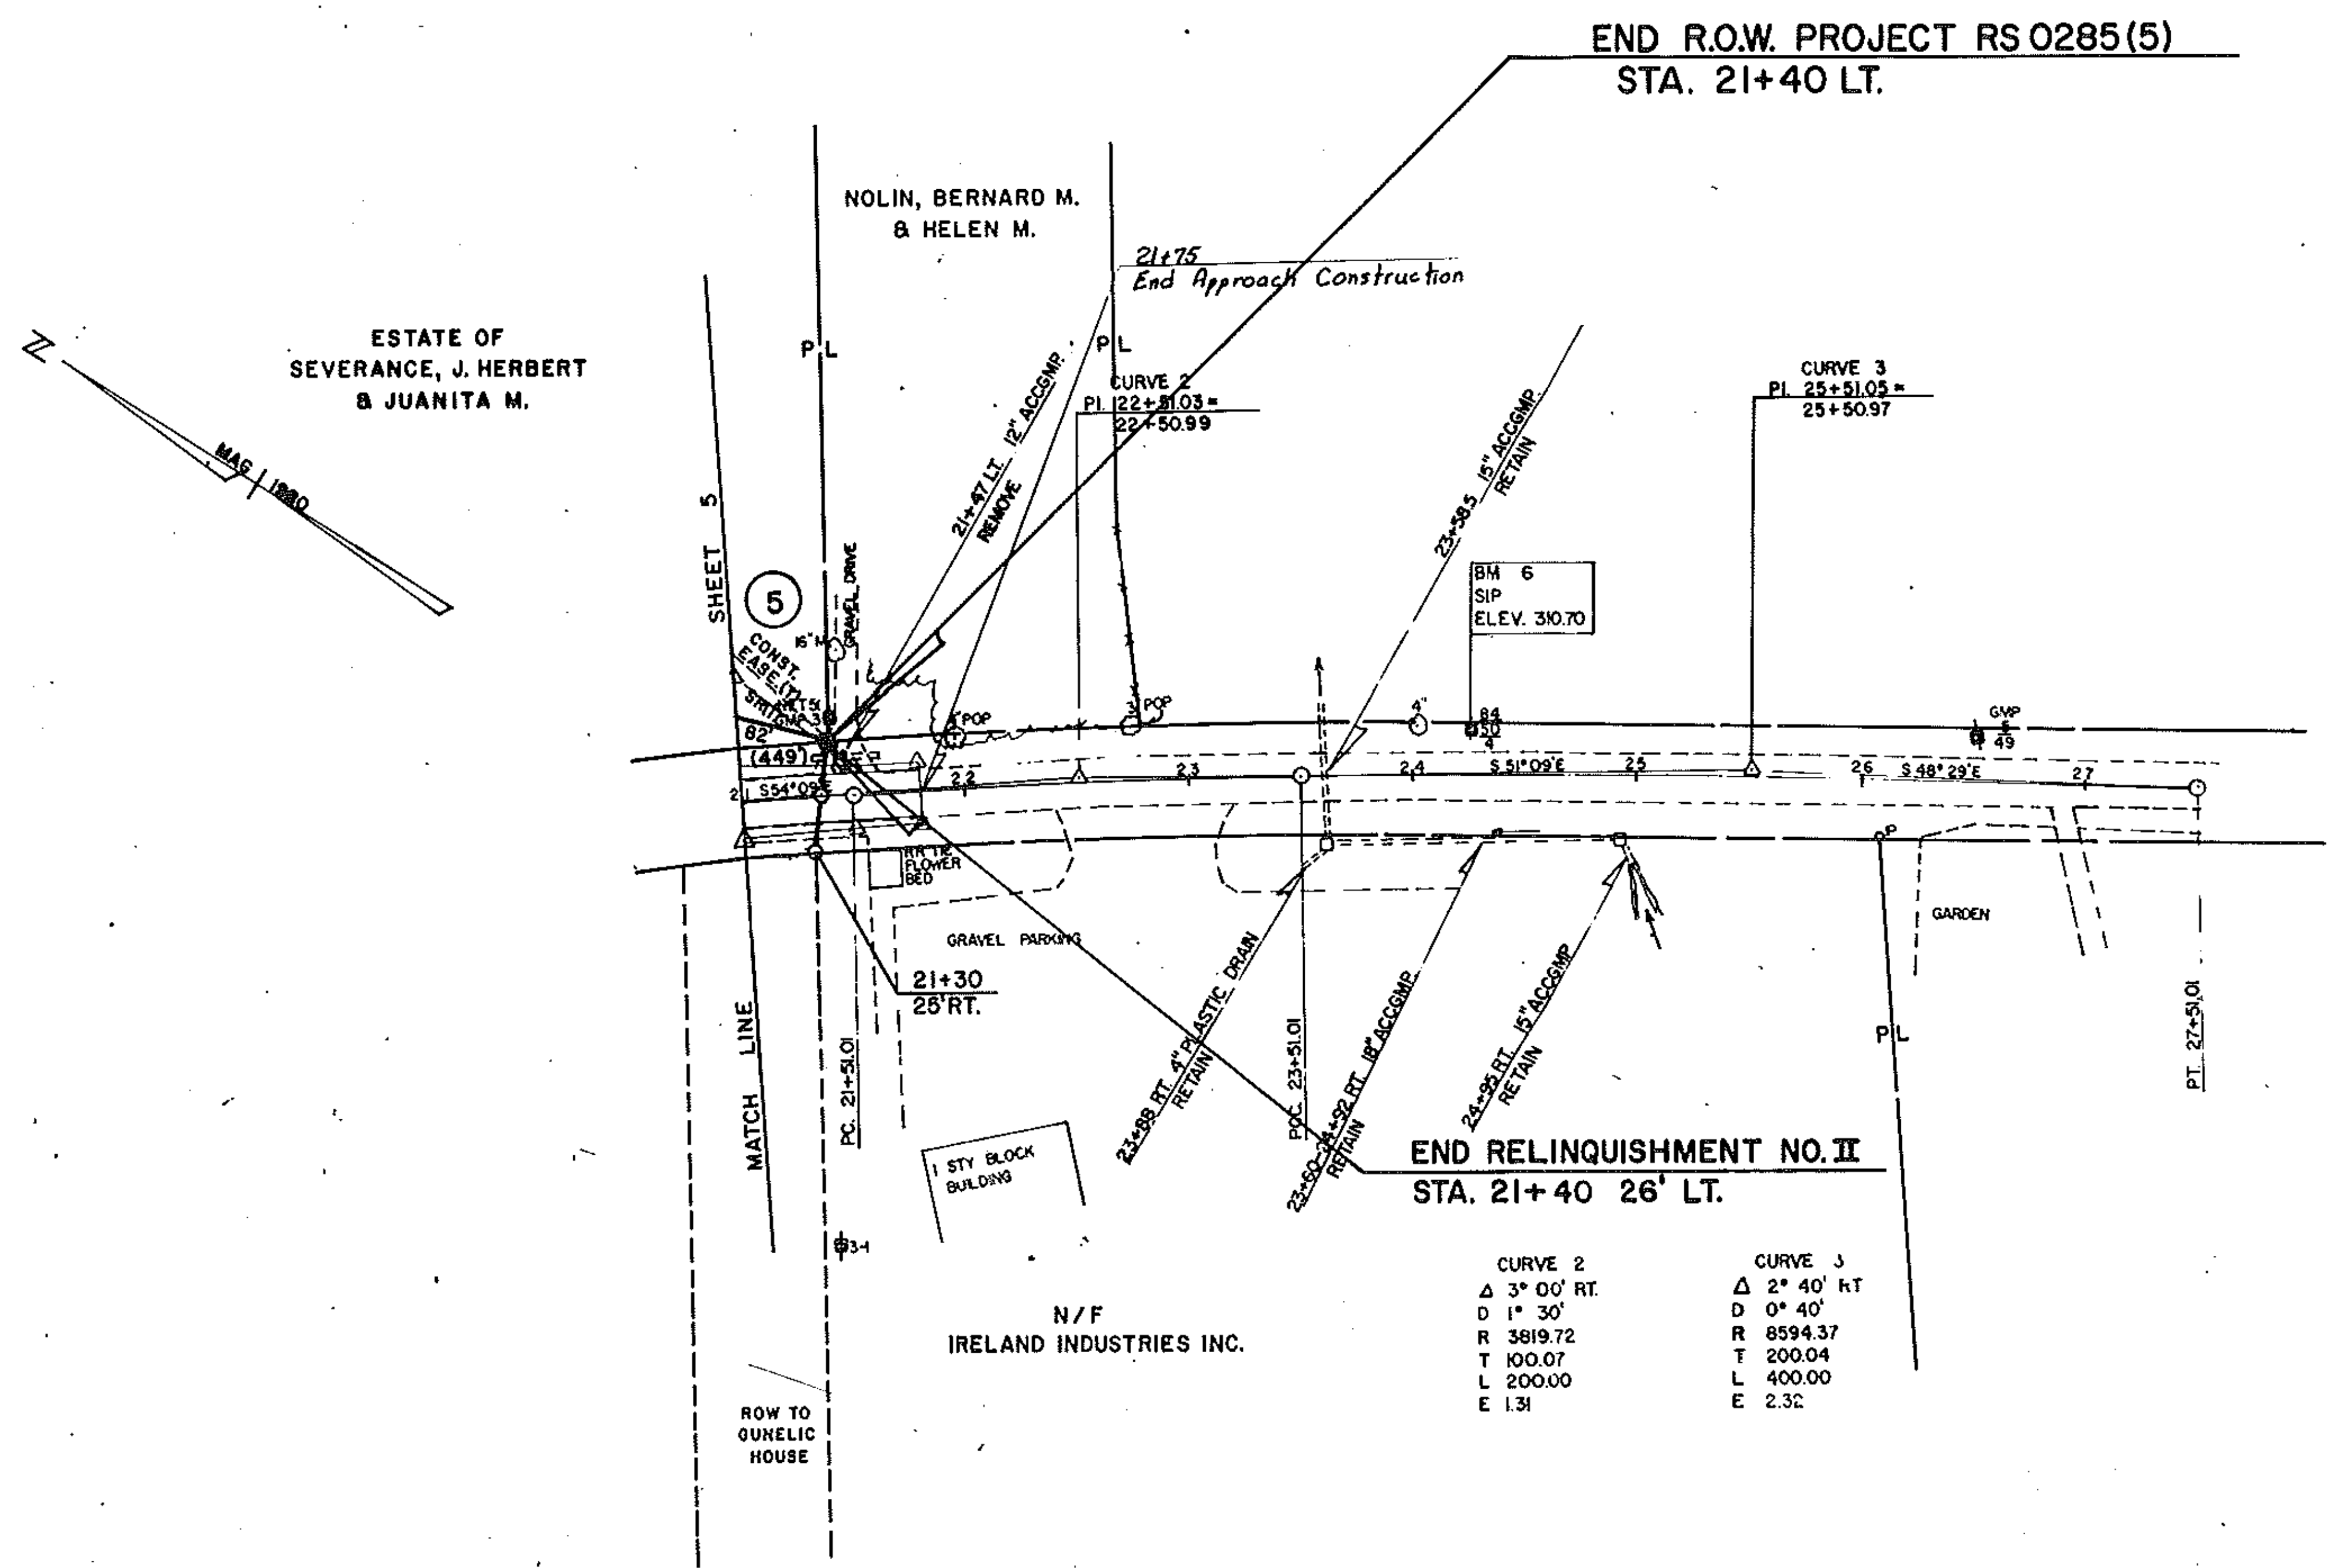

END RELINQUISHMENT NO. II  
STA. 21+40 26' LT.

CURVE 2	CURVE J
Δ 3° 00' RT.	Δ 2° 40' RT.
D 1° 30'	D 0° 40'
R 3819.72	R 8594.37
T 100.07	T 200.04
L 200.00	L 400.00
E 1.31	E 2.32

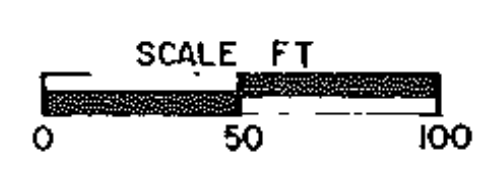

PC 21+51.01	PCC 23+51.01	PT 27+51.01	SURVEYED BY FALL DATE 9/80
4" POP 47.21	RR TIES	3" POP 10.87	DRAWN BY DATE
3" POP 36.49	RR TIES	3" SPIRES IN POINT 10.84	TRACED BY DATE
		3" SPIRES IN POINT 16.60	COLCHESTER
		3" SPIRES IN POINT 101.34	PROJ. RS NO. 0285 (5)
			SHEET 16 OF 93

UM	NGVD 1929
VERTICAL	N/A
HORIZONTAL	