

Curve Data
 Δ 23° 58'
 D 30'
 R 1909.9
 L 405.4
 T 798.9
 E 42.6

21+75
 End Approach Construction
 CURVE 2
 P.I. 22+51.03 = 22+50.99

CURVE 3
 P.I. 25+51.05 = 25+50.97


CURVE 2
 Δ 3° 00' RT
 D 1° 30'
 R 3819.72
 T 100.07
 L 200.00
 E 1.31

CURVE 3
 Δ 2° 40' RT
 D 0° 40'
 R 8594.37
 T 200.04
 L 400.00
 E 2.32

Note: All slope work shall be adjusted as necessary to stay within existing R.O.W., STA 105+50 - 110+00

Note: From 105+50 Lt to 115+00 Lt and 109+00 Rt to 115+00 Rt Pavement shall be cut or sawn not ripped

Payment shall be Subsidiary To Common Excavation

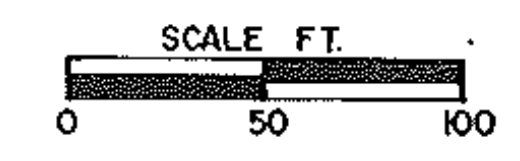

M	NGVD 1929
HORIZONTAL	N/A

PC 21+51.01	PCC 23+51.01	PT 27+51.01	SURVEYED BY FALL DATE 9/80
4" POP 36.49	RR TIES 24.83	RR TIES 24.83	DRAWN BY _____ DATE _____
RR TIES 24.83	RR TIES 24.83	RR TIES 24.83	TRACED BY _____ DATE _____
RR TIES 24.83	RR TIES 24.83	RR TIES 24.83	COLCHESTER
RR TIES 24.83	RR TIES 24.83	RR TIES 24.83	PROJ. RS NO. 0285 (5)
RR TIES 24.83	RR TIES 24.83	RR TIES 24.83	SHEET 21 OF 13