


21+75
End Approach Construction

300
310
320

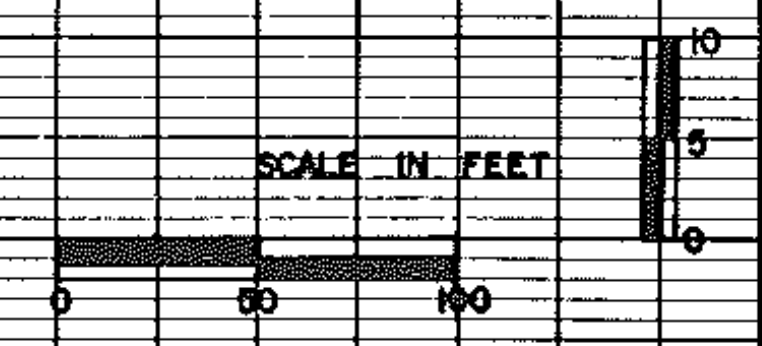

COLLECTOR
RS 0285 (S)
SHEET 22 OF 33 SHEETS

21+00 +50 22+00 +50 23+00 +50 24+00 +50 25+00 +50 26+00 +50 27+00