




See Non-Line Sections
Sta. 17+00 to 4

37+00

St. 36+55.2 to 11.5 Sta 17+00
Common Excavation for
Removal of old T&T
Surface and base material


300

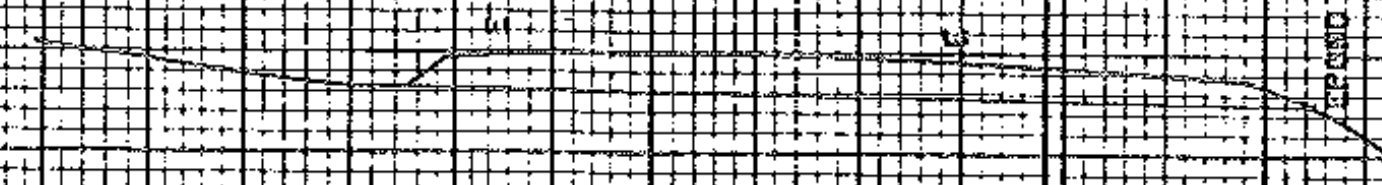

36+00

Grade to drain all areas
of existing T&T

290

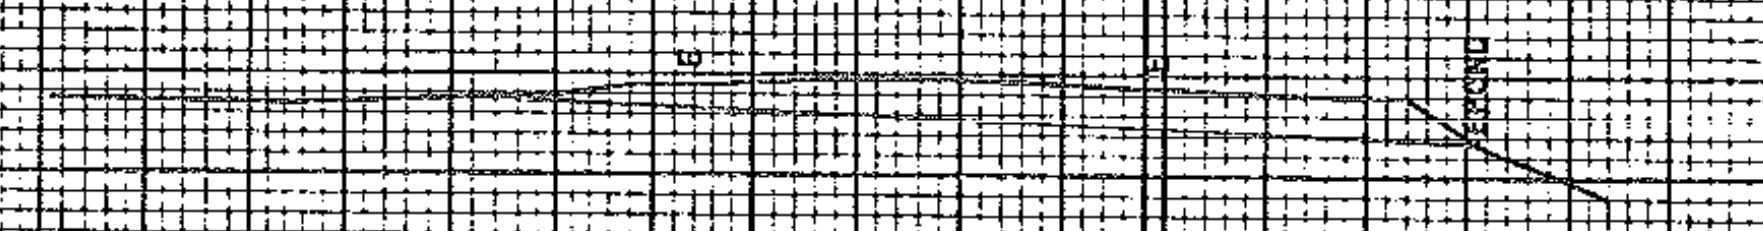

35+00

300



34+00

300



33+25

300

FROM STA. 33+25 TO STA. 37+00
PROJECT NAME: GOLDCHESTER T&T
NO. R00208167
SURVEYED BY: FALL
SHEET 2 OF 6 SHEETS: 13
PLOTTED: 11/25/00
OCT 1999

SCALE: 1" = 10'