


Width Transition
STA 105+50 - 107+25
(4.5-7')

Scale 1" = 20'

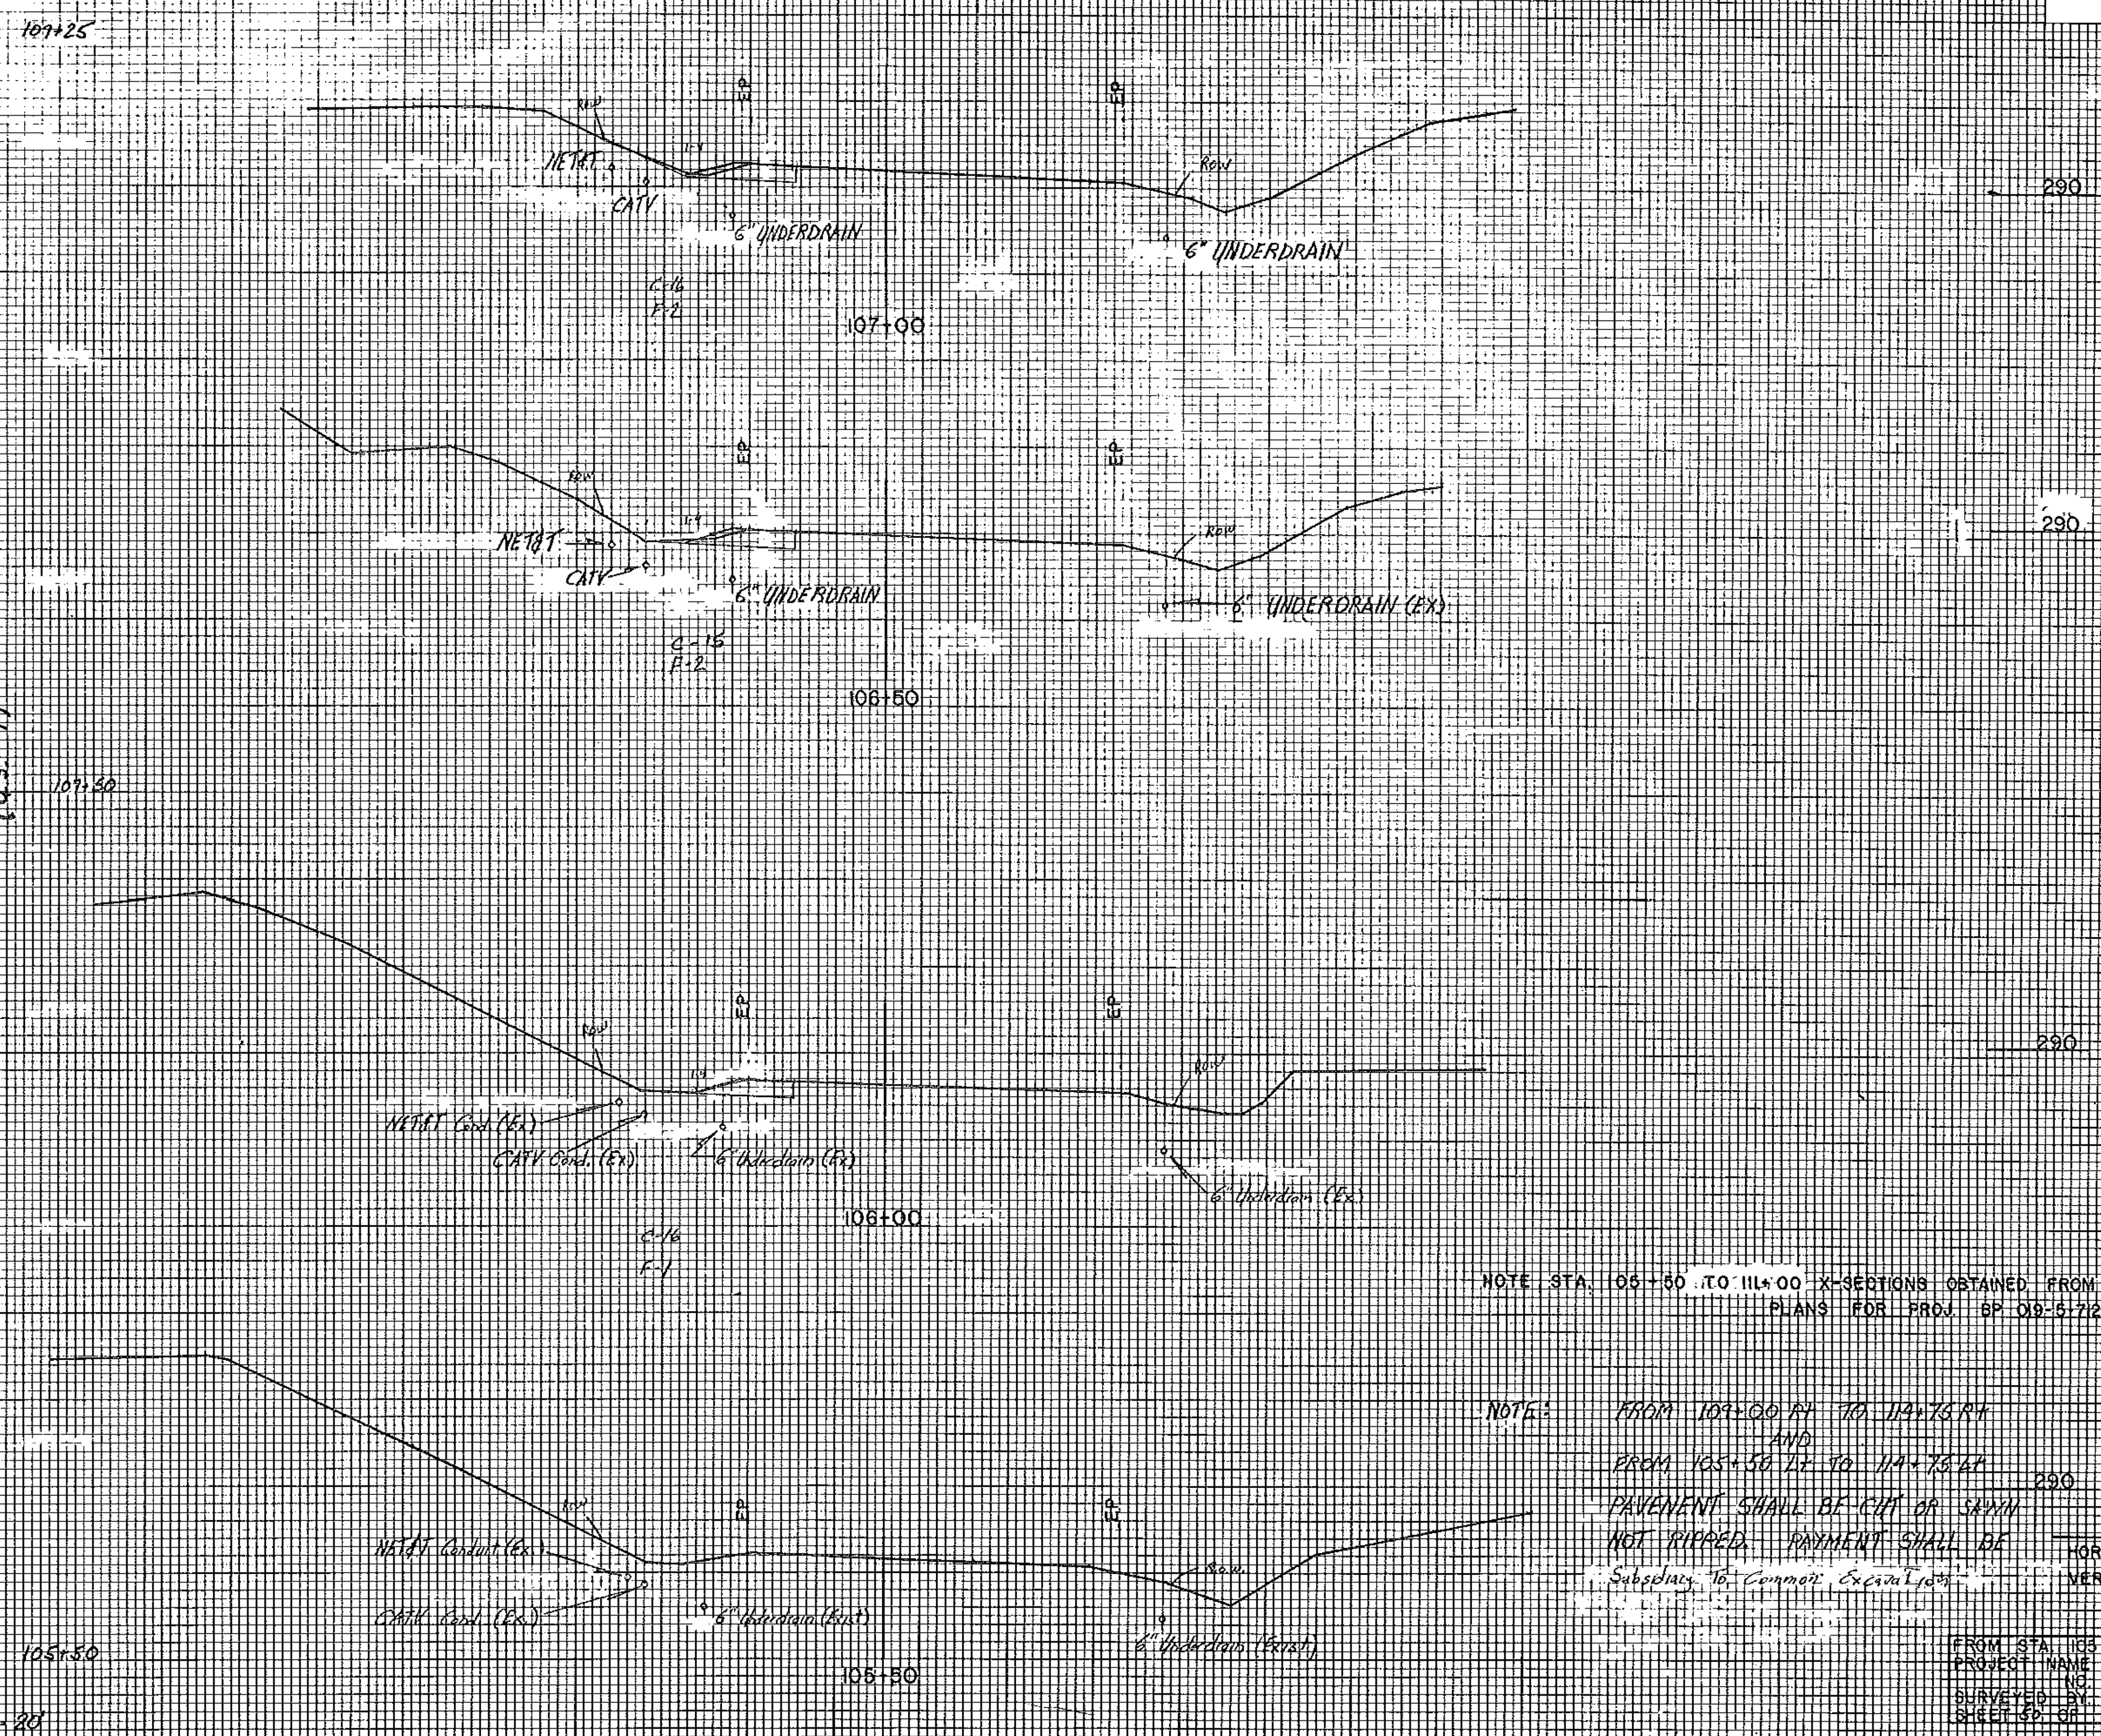

NOTE STA. 105+50 TO 111+00 X-SECTIONS OBTAINED FROM FINAL RECORD PLANS FOR PROJ. BP 019-6723

NOTE: FROM 109+60 PM TO 114+75 PM
AND
FROM 105+50 AM TO 114+75 AM
PAVEMENT SHALL BE CUT OR SAWN
NOT RIPPED. PAYMENT SHALL BE
Subsidiary to Common Excavation

SCALE
HORIZ 1" = 10'
VERT 1" = 10'

FROM STA. 105+50 TO STA. 107+00
PROJECT NAME COLCHESTER
NO. RD265(5)
SURVEYED BY
SHEET 52 OF 93 SHEETS