



3/16
F-5

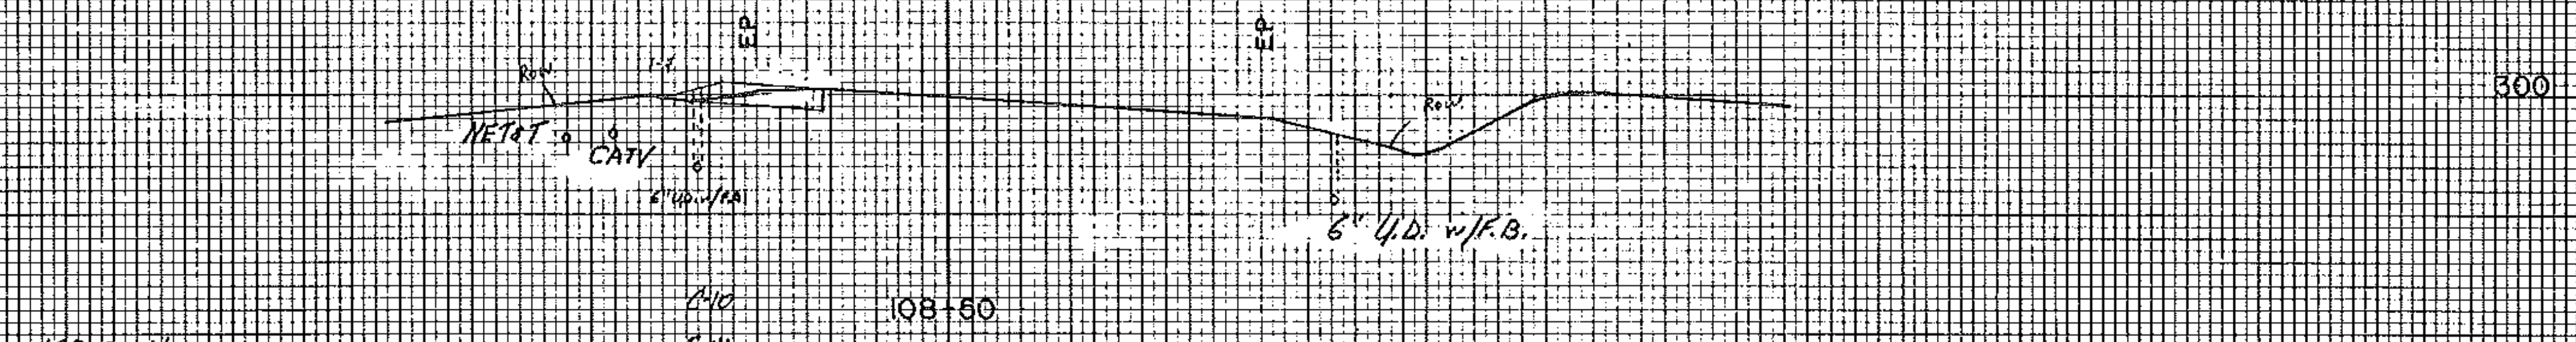


108+50 L.P.
EXTEND U.D. FLUSH BASIN

1/10
F-11

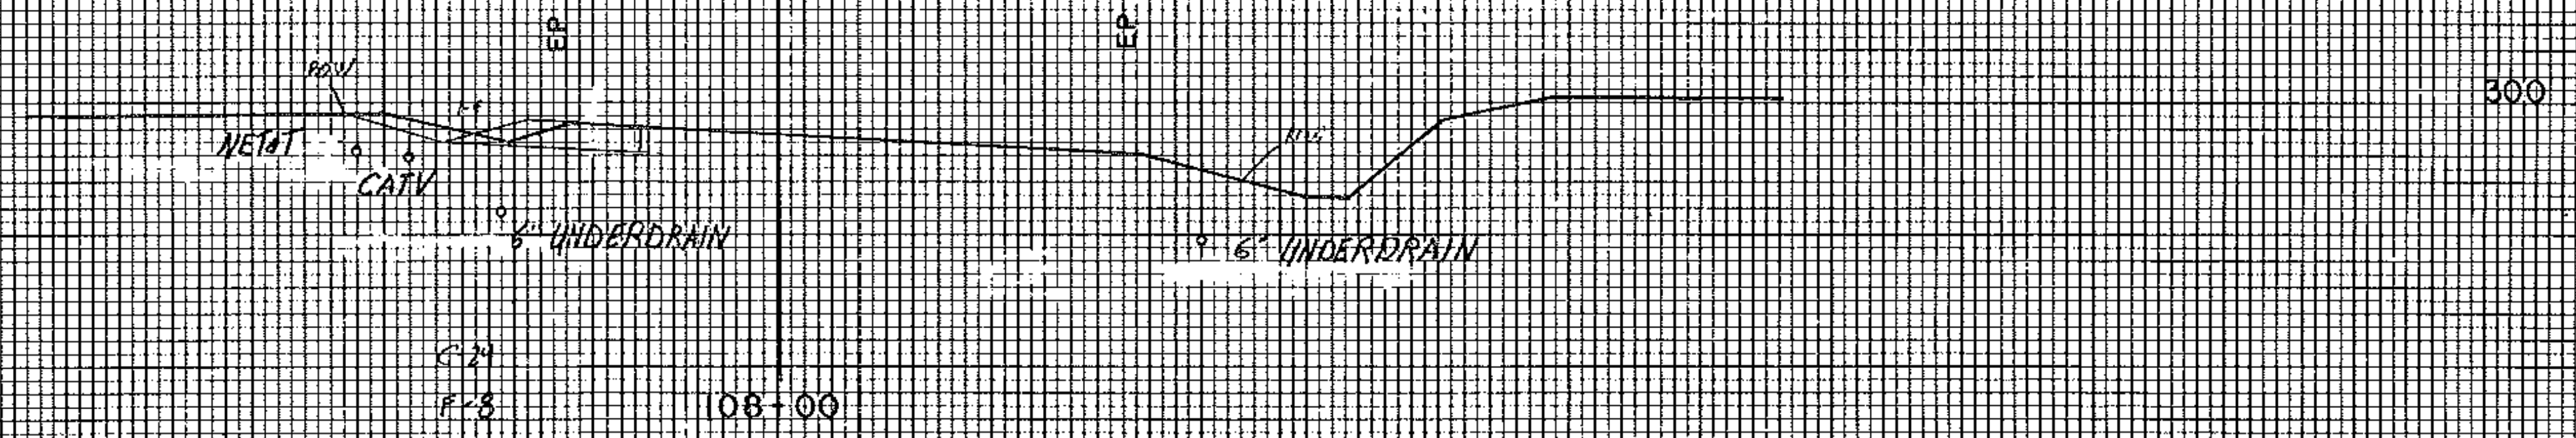

C-24
F-8

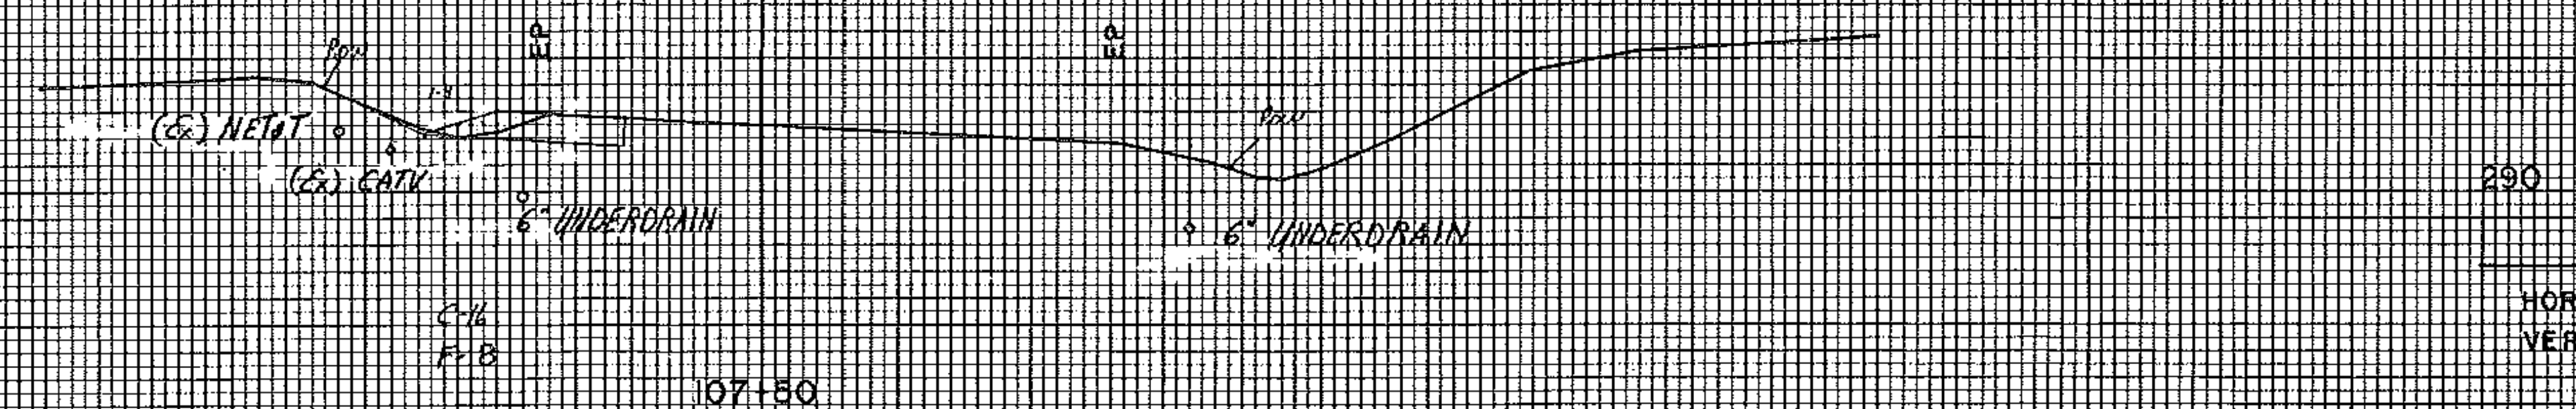

C-16
F-8

300

300

300

290

SCALE
HORIZ. 1" = 10'
VERT. 1" = 10'

FROM STA. 107+50 TO STA. 109+00
PROJECT NAME: COLCHESTER
NO. R00285(5)
SURVEYED BY
SHEET 5 OF 18 SHEETS