

INDEX OF SHEETS

1. TITLE SHEET
2. QUANTITY SHEET
3. PLAN & PROFILE
4. PIPE DETAILS
5. OUTLET HEADWALL DETAILS
6. REINFORCING STEEL SCHEDULE

LIST OF STANDARDS

7. E-3 12-15-78 (R)
8. E-6 12-15-78 (R)
9. E-7 9-5-78 (R)
10. E-7a 8-8-77 (R)
11. G-1d 9-12-77 (R)
12. SCB-DI-75 4-3-78 (R)

CONCRETE-CHARLESTOWN READY MIX INC., CHARLESTOWN, N.H.
REINFORCING STEEL-PIONEER VALLEY STEEL CO. INC., GREENFIELD, MASS.

GENERAL NOTES

1. FOR ADDITIONAL NOTES SEE STANDARD SCB-DI-75.
2. ROADWAY ALIGNMENT SHALL MATCH EXISTING AS DIRECTED BY THE ENGINEER.
3. ALL REINFORCING STEEL SHALL HAVE A MINIMUM COVER OF 3", MEASURED FROM THE CONCRETE SURFACE TO THE FACE OF THE REINFORCEMENT.
4. TRAFFIC SHALL BE MAINTAINED UNDER THE ITEM 'MAINTENANCE OF TRAFFIC FOR BRIDGE PROJECTS'. ALL SIGNS AND BARRICADES SHALL BE SUBSIDIARY TO THIS ITEM.
5. THE TWO EXISTING PIPES SHALL BE REMOVED UNDER THE ITEM 'REMOVAL OF STRUCTURE'. CARE SHALL BE TAKEN NOT TO DAMAGE THESE PIPES WHICH SHALL REMAIN THE PROPERTY OF THE TOWN.
6. TURF ESTABLISHMENT SHALL BE SUBSIDIARY TO ALL OTHER ITEMS IN THE CONTRACT.
7. CARE SHALL BE TAKEN IN DRIVING GUARD RAIL POST TO PREVENT POST FROM DAMAGING THE TOP OF THE PIPE.
8. NO EXCAVATION SHALL BE REQUIRED IN ROADWAY OUTSIDE OF STRUCTURE LIMITS. SHIM ROADWAY WITH SUBBASE OF GRAVEL TO OBTAIN NEW ROADWAY GRADE AS DETERMINED BY THE ENGINEER.
9. THE CONTRACTOR MAY REMOVE ONE OF THE EXISTING PIPES AND USE IT TO BUILD A DETOUR. THE CONTRACTOR MUST SUPPLY ALL FILL MATERIAL USED IN THE DETOUR, AND MUST REMOVE ALL OF THIS MATERIAL BEFORE COMPLETION OF THE PROJECT, AS DIRECTED BY THE ENGINEER. ALL WORK AND MATERIALS NECESSARY FOR THE DETOUR SHALL BE PAID FOR UNDER THE ITEM 'MAINTENANCE OF TRAFFIC FOR BRIDGE PROJECTS'.

CONVENTIONAL SIGNS

COUNTY LINE	—
TOWN LINE	—
LIMITS OF ACCESS	—
POINT OF ACCESS	X
FENCE LINE	—
STONE WALL	—
TRAVELED WAY	—
GUARD RAIL	—
RAILROAD	—
SURVEY LINE	—
CULVERT	—
POWER POLE	⊙
TELEPHONE POLE	⊙
TREES	⊙
CONTROL OF ACCESS	—
PROPERTY LINE	—
R.O.W. TAKING LINE	—
SLOPE RIGHTS	—
TOP OF CUT	—
TOE OF SLOPE	—

DATUM

VERTICAL	_____
HORIZONTAL	_____

STATE OF VERMONT AGENCY OF TRANSPORTATION



CONSTRUCTION ACCEPTED-21 SEPTEMBER 1979

RECORD PLANS-MATERIAL SUPPLIERS
 CONTRACTOR-WALLIN CORR, CAVENDISH, VT. CONTRACT DATED-11 JULY 1979
 CONSTRUCTION BEGAN-19 JULY 1979 COMPLETED-7 SEPTEMBER 1979
 RESIDENT ENGINEER-RONALD D. GRAY RECORD PLANS-PAUL E. SINGLETON
 GUARD RAIL-LAFAYETTE-SHELDON INC., ESSEX JCT, VT
 GRANULAR BORROW, GRANULAR BACKFILL FOR STRUCTURES, SUB-BASE OF GRAVEL-THERON FISHER PIT, GRAFTON, VT.


PROPOSED IMPROVEMENT BRIDGE PROJECT

TOWN OF GRAFTON
COUNTY OF WINDHAM



ROUTE NO: T.H. 38, C.L. 3 BRIDGE NO: 31

PROJECT LOCATION: BEGINNING AT A POINT ON T.H. 38, 0.10 MILES NORTHEARLY OF THE INTERSECTION OF VT. RTE. 121 AND T.H. 38 AND EXTENDING NORTHEARLY 0.038 MILES ON T.H. 38.
 PROJECT DESCRIPTION: REMOVAL OF EXISTING PIPES AND CONSTRUCTION OF A 13'-5" x 8'-5" x 44' CGMPPA WITH CONCRETE HEADWALLS. RELATED ROADWAY AND CHANNEL WORK.

LENGTH OF STRUCTURE:	_____	FEET
LENGTH OF PARTICIPATION ROADWAY:	2.00	FEET
LENGTH OF NON-PARTICIPATION ROADWAY:	_____	FEET
LENGTH OF PROJECT:	2.00	FEET

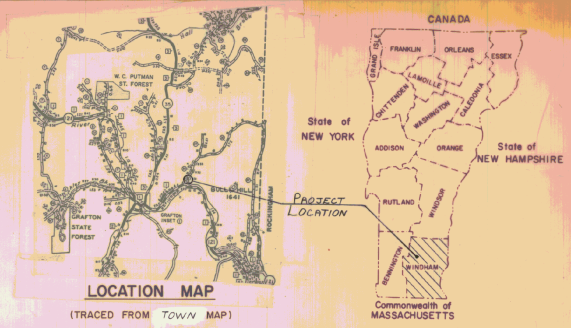

13'-5" x 8'-5" x 44' CGMPPA-REPUBLIC STEEL CORP., BOSTON, MASS.

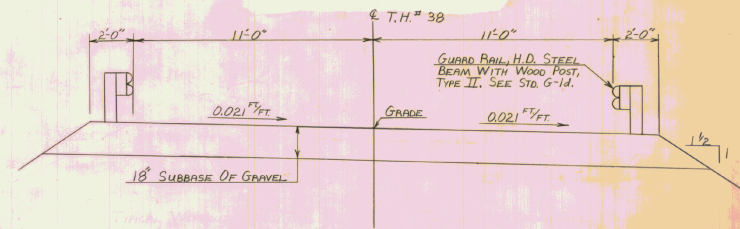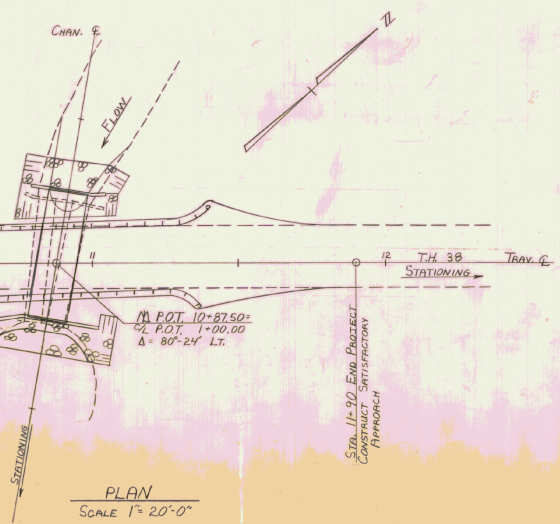

TYPICAL ROADWAY SECTION (AT STRUCTURE)
SCALE 3/8"=1'-0"

BUILT AS DESIGNED

SUBMITTED BY ORDER OF THE STATE TRANSPORTATION BOARD
 APPROVED *A. J. Gagnier* DATE 4-6-79
 DIR. OF ENGINEERING AND CONSTRUCTION


PROJECT GRAFTON NO. TH 3903
 SHEET 11 OF 12 SHEETS

GUARD RAIL, H.D. STEEL BEAM WITH WOOD POST, TYPE II
 STA 10+40 RT. TO STA. 11+38 RT. ✓
 STA 10+46 LT. TO STA. 11+41 LT. ✓

BM #1
 ASSUMED EL. 500.00
 POLE #3
 272 ✓

NOTE
 ROADWAY ALIGNMENT SHALL MATCH INTO THE EXISTING ROADWAY AS DIRECTED BY THE ENGINEER IN THE FIELD.


PLAN
 DRAWN BY
 CHECKED BY
 DATE

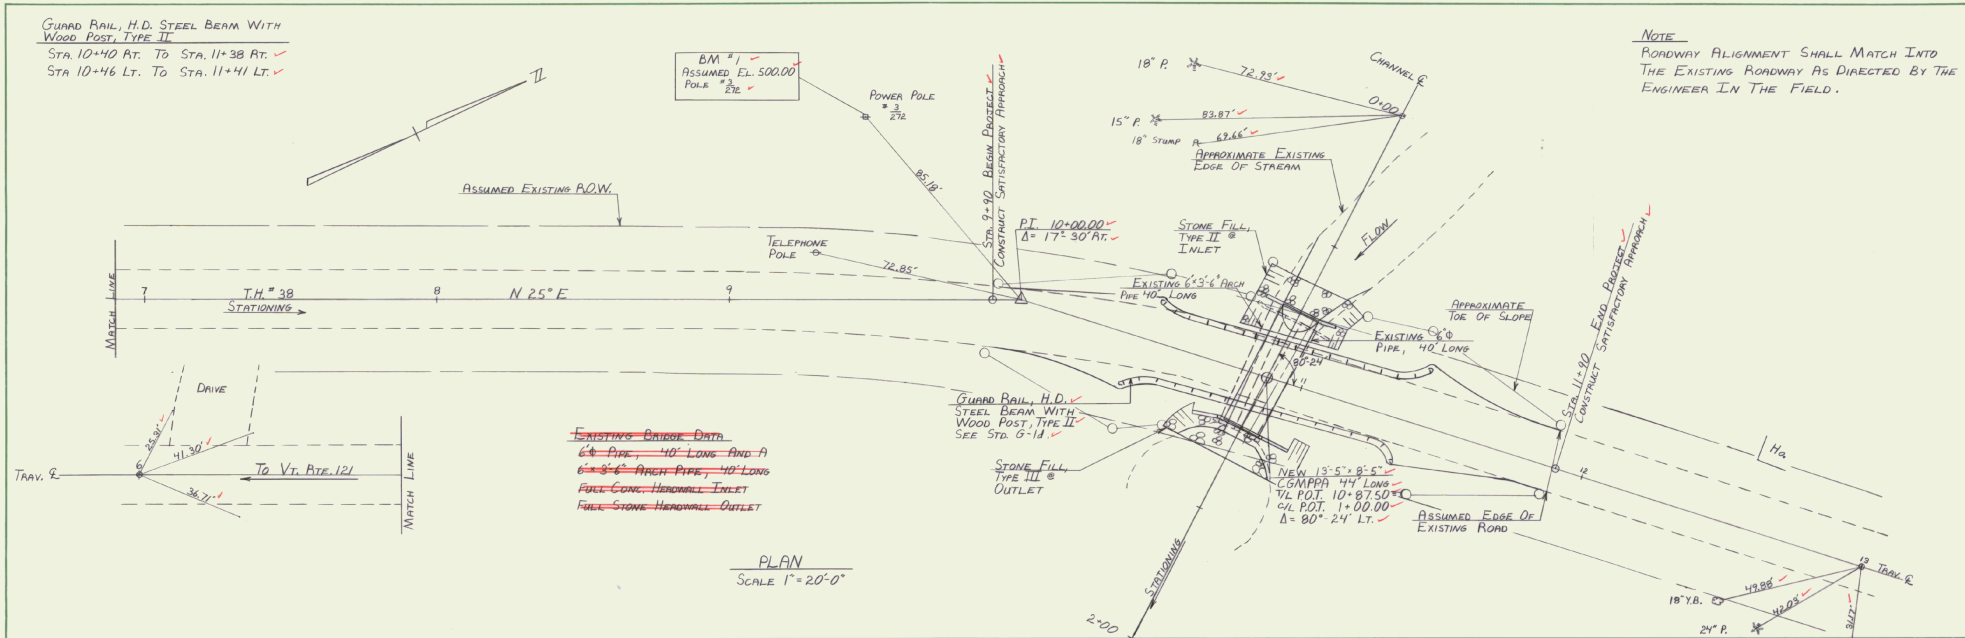


EXISTING BRIDGE DATA
 6" PIPE 40' LONG AND A
 6" 3" 6" ARCH PIPE, 40' LONG
 FUEL COND. HEADWALL INLET
 FULL STONE HEADWALL OUTLET

PLAN
 SCALE 1" = 20'-0"


PROFILE
 DRAWN BY
 CHECKED BY
 DATE

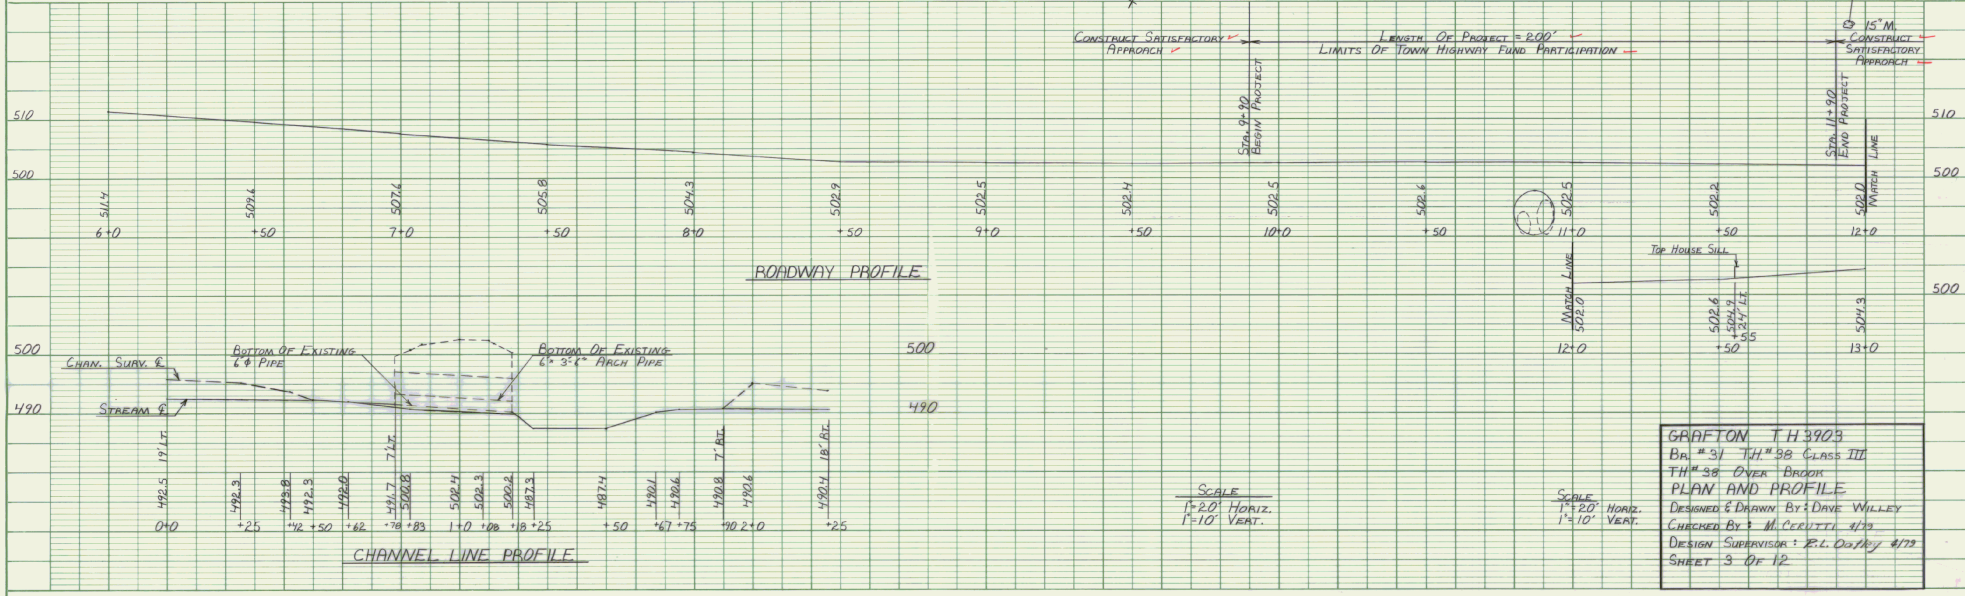

GRAFTON T.H. 3909
 BA # 31 T.H. # 38 CLASS III
 FH # 38 OVER BROOK
 PLAN AND PROFILE
 DESIGNED & DRAWN BY: DAVE WILLEY
 CHECKED BY: M. DEWITT 3/79
 DESIGN SUPERVISOR: R.L. DUNN 3/79
 SHEET 3 OF 12

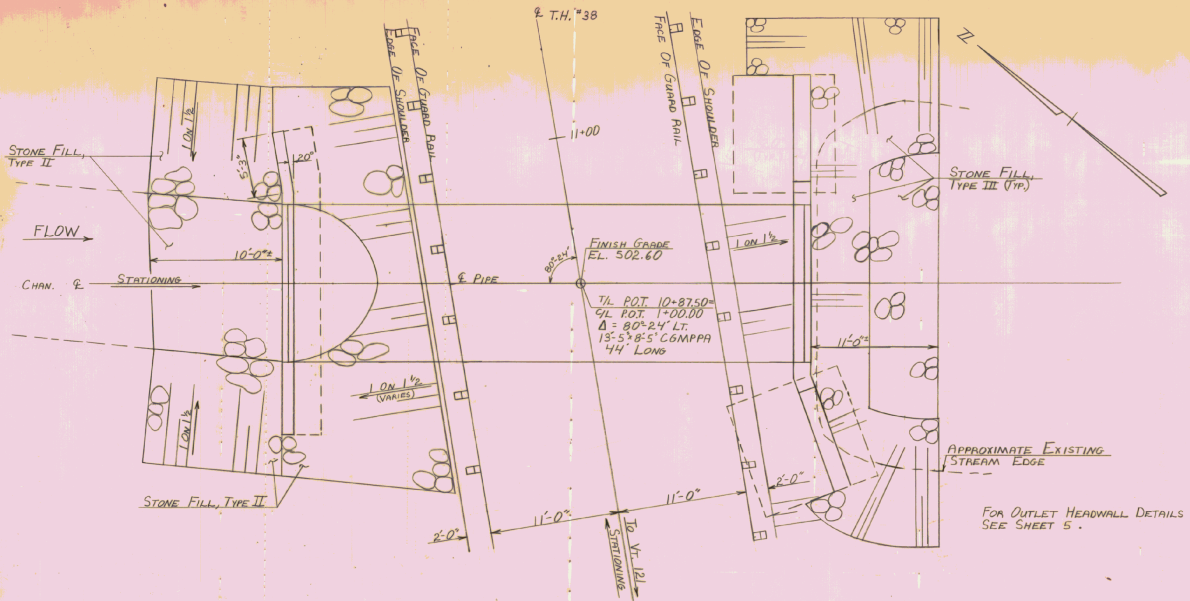

PLAN
SCALE 1" = 5'-0"

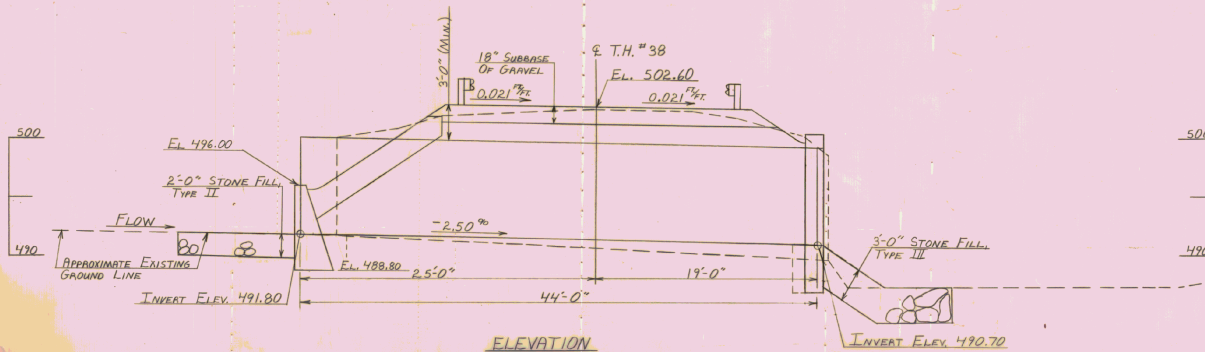

ELEVATION
SCALE 1" = 5'-0"

HYDRAULIC DATA

DRAINAGE AREA = 3.66 SQ. MI.

Q ₁₀ = 560 c.f.s	Q ₁₀ HEADWATER ELEVATION = 498.90
Q ₂₅ = 720 c.f.s	Q ₂₅ HEADWATER ELEVATION = 500.40
Q ₅₀ = 910 c.f.s	Q ₅₀ HEADWATER ELEVATION = 502.30
Q ₁₀₀ = 1100 c.f.s	Q ₁₀₀ HEADWATER ELEVATION = 504.60

TAILWATER DEPTH AT Q₂₅ = 3.0 FEET
 OUTLET VELOCITY AT Q₂₅ = 14 F.P.S.


ADDITIONAL COMMENTS: STONE FILL, TYPE III AT OUTLET AND STONE FILL, TYPE II AT INLET.

DETAILS OF STRUCTURAL PLATE PIPE CULVERTS


PIPE DATA:	STEEL	ALUMINUM
CORRUGATIONS	6" x 2"	
SIZE OF PIPE OR PIPE ARCH	13'-5" x 8'-5"	
WATERWAY AREA (S.F.)	89	
PLATE THICKNESS	0.168 (COATED) THICKNESS	
BOLT SIZE	3/4	
WT. LIN. FT.	367	
TOTAL WEIGHT	16,148	

NOTES

1. P.L. MATERIALS AND CONSTRUCTION SHALL CONFORM TO THE STATE OF VERMONT DEPARTMENT OF HIGHWAYS STANDARD SPECIFICATIONS FOR HIGHWAY AND BRIDGE CONSTRUCTION DATED MAR. 1975 AND THE A.A.S.H.T.O. STANDARD SPECIFICATIONS FOR HIGHWAY BRIDGES DATED 1973 AND ITS LATEST REVISIONS. DESIGN IS FOR HS-20 LIVE LOADING.
2. UNLESS OTHERWISE INDICATED FOUR (4) BOLTS PER LINEAR FOOT FOR STEEL PLATES AND FIVE AND ONE THIRD (5 1/3) BOLTS FOR ALUMINUM PLATES ARE REQUIRED ALONG THE LONGITUDINAL SEAMS. ALL CONNECTIONS FOR STRUCTURAL PLATE SECTIONS SHALL BE MADE WITH GALVANIZED ASTM A-325 BOLTS (AASHO M164).
3. WHEN NORMAL CONSTRUCTION OR REGULAR ROADWAY TRAFFIC IS MAINTAINED OVER THE PIPE THE CONTRACTOR SHALL MAINTAIN A MINIMUM COVER OF 4 FEET OF COMPACTED MATERIAL.
4. ALUMINUM PIPE THAT IS TO BE IN CONTACT WITH CONCRETE SHALL HAVE CONTACT SURFACES THOROUGHLY COATED WITH ZINC CHROMATE, OR BITUMINOUS, OR ASPHALTIC PAINT.
5. PIPES SHALL BE FACTORY ELONGATED 5% (PIPE ARCHES SHALL NOT BE ELONGATED).

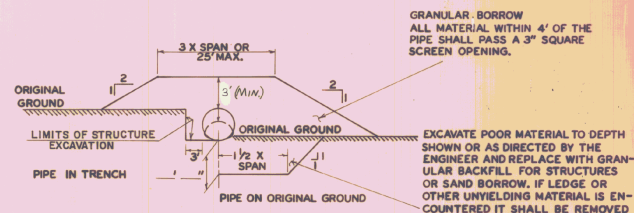


TYPICAL BACKFILL SECTION

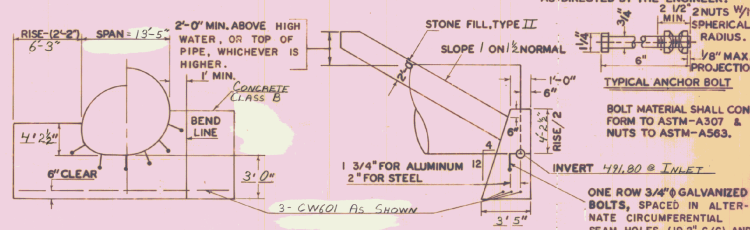

INLET CRADLE HEADWALL DETAILS
(FOR OUTLET HEADWALL DETAILS SEE SHEET 5.)
REINFORCING STEEL SCHEDULE (SEE SHEET 5.)

NO.	PIECES	SIZE	LENGTH	MARK	TYPE

ESTIMATED QUANTITIES SEE SHEET #2.				
NO.	ITEM	UNIT	TOTAL	FINAL

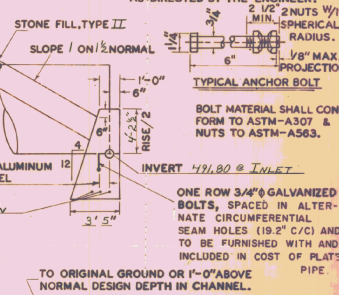


TYPICAL CHANNEL SECTION


STATE OF VERMONT
DEPARTMENT OF HIGHWAYS

TOWN OF	GRAFTON	Bridge No.	31
HIGHWAY NO.	T.H. 38 CLASS 3	Log Sta.	
		Surv. Sta.	10+87.50
T.H. # 38 OVER BROOK			
13'-5" x 8'-5" x 44" LONG CGMPPA DETAILS			
Designed by	DAVE WILLEY	Drawn by	DAVE WILLEY
Checked by	M. CERUTTI	Bridge Design Supervisor	
PROJECT	GRAFTON	date	3-79
		EL. COPY	date 4/79
		PROJECT NO.	T.H. 3903
		Bridge Sheet No.	Sheet 4 of 12


* WINGWALL NO. 2 SHOWN, WINGWALL NO. 1 IS THE SAME ONLY REVERSED.

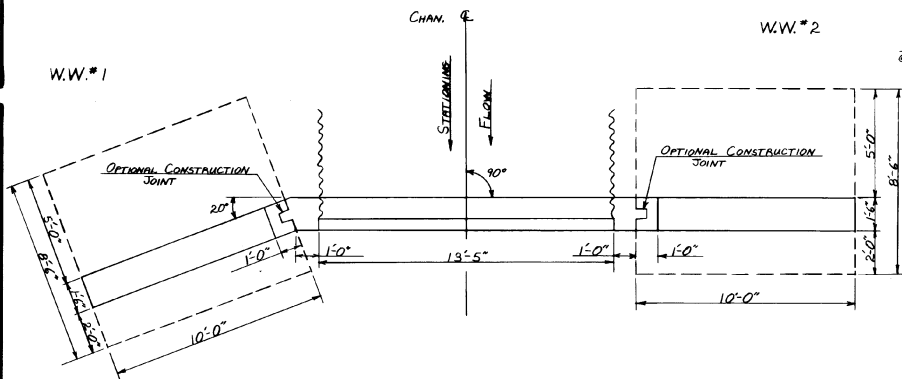

OUTLET HEADWALL PLAN
SCALE $\frac{3}{8}'' = 1'-0''$

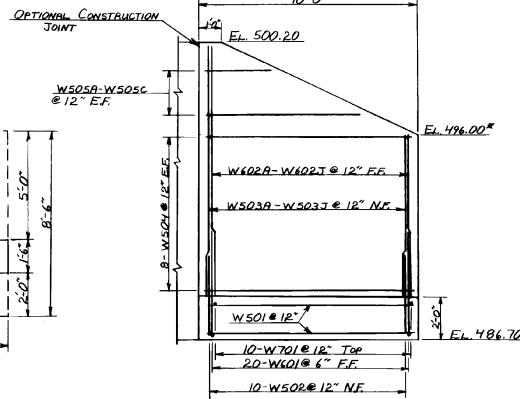










TYPICAL WINGWALL ELEVATION
SCALE $\frac{3}{8}'' = 1'-0''$

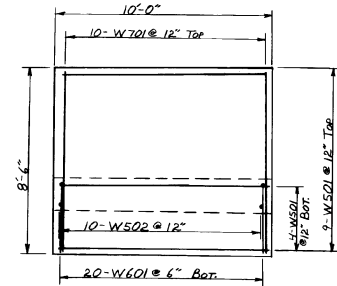

TYPICAL PLAN
FOOTING REINFORCING STEEL
SCALE $\frac{3}{8}'' = 1'-0''$












* WINGWALL END ELEVATIONS MAY BE CHANGED IN THE FIELD BY THE ENGINEER TO MEET EXISTING SLOPE CONDITIONS.

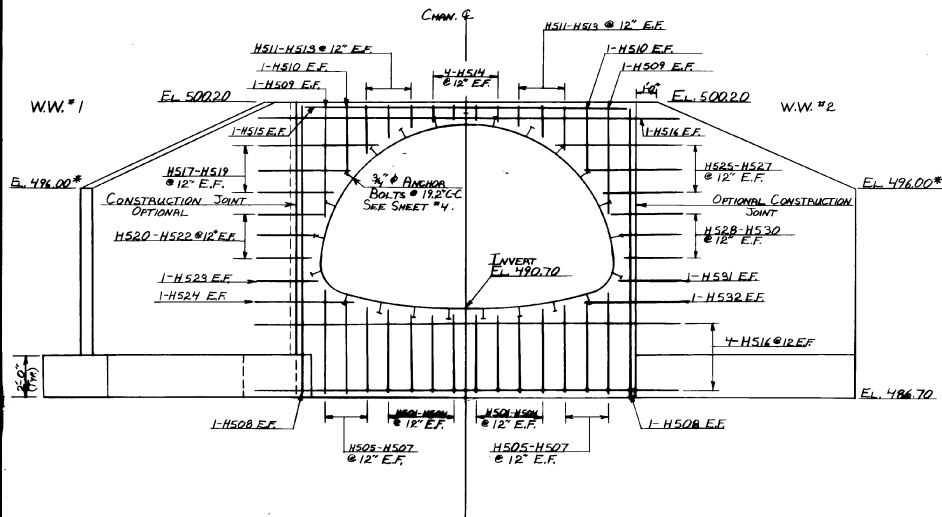

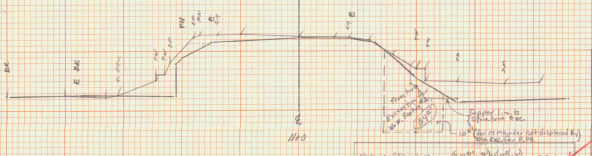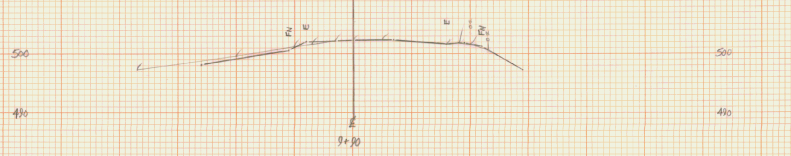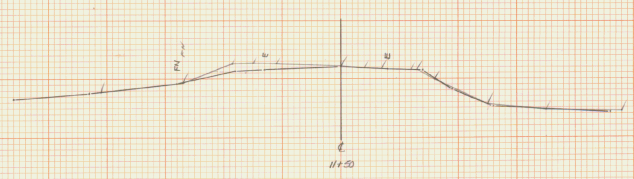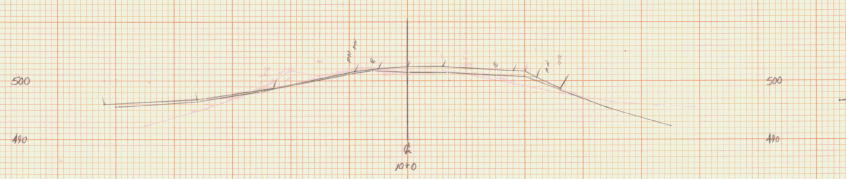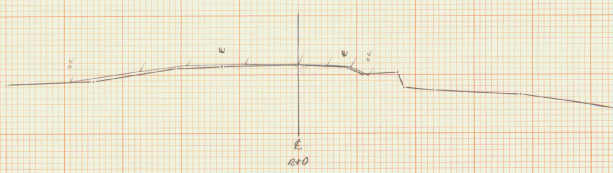
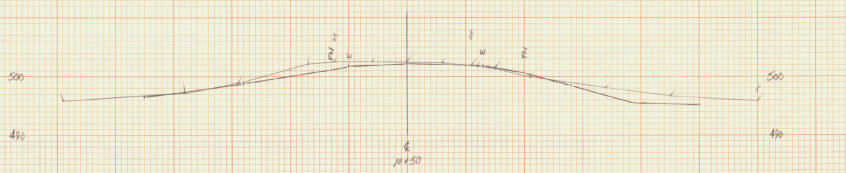
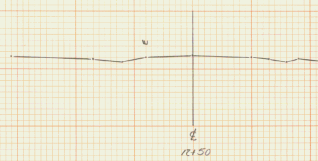
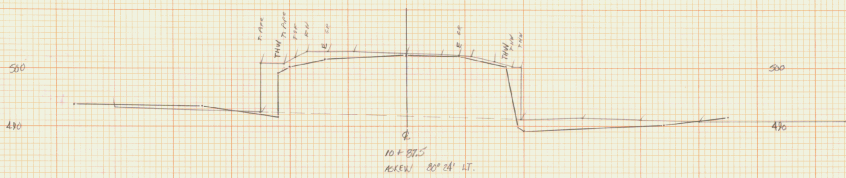


Volume of Spillway
 Volume of Embankment
 Volume of Cut
 Volume of Fill

SHEET #1
 GRANTON TH 3108
 BROADWAY SECTION
 SECTION 1000 111-11
 PLOTTED 8-1-79
 FINAL BOARD 8-1-79

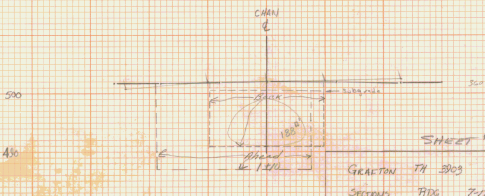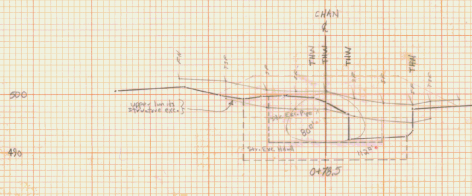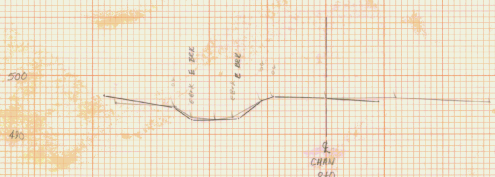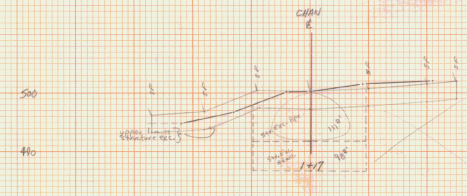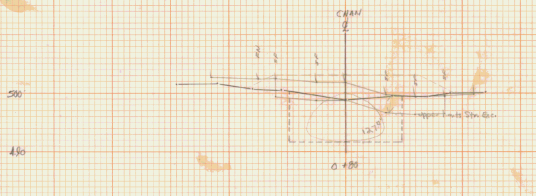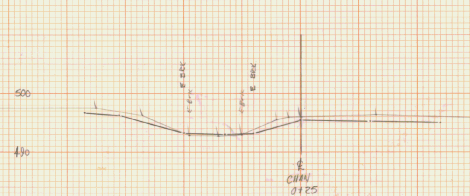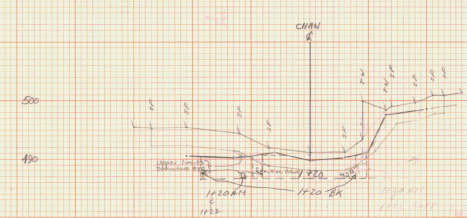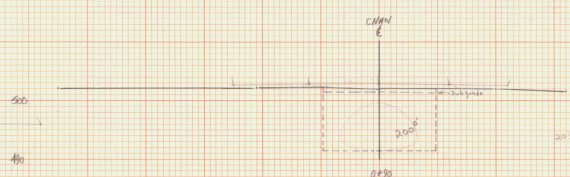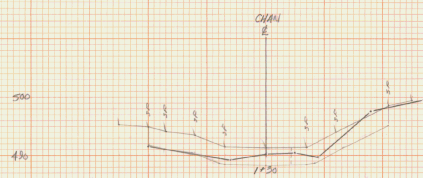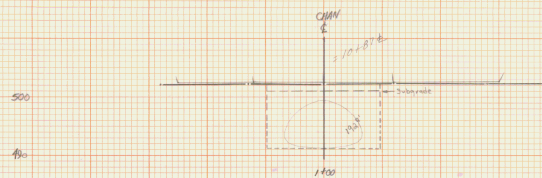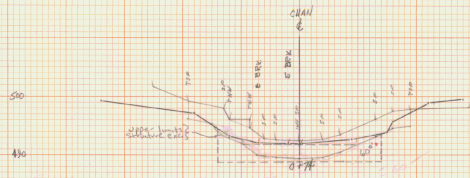

SHEET #2
 GRAYTON TR 3003
 SECTION #10
 PLOTTED 8-1-75
 CHANNEL SECTIONS

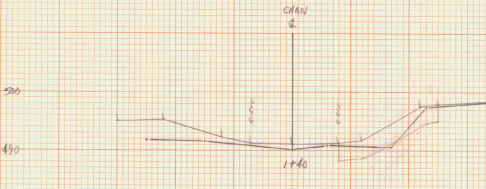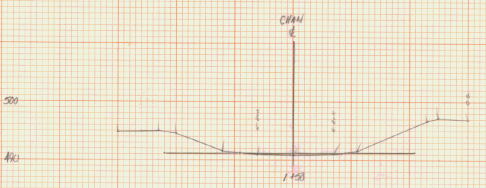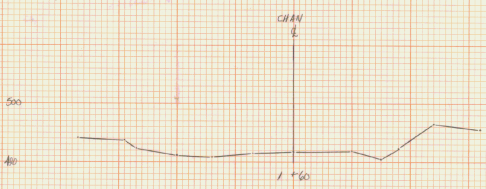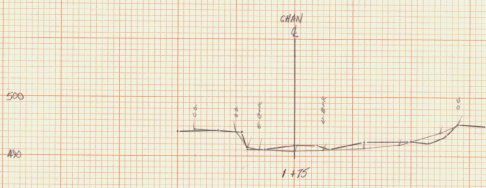

STRUCTURE EXCAVATIONS

STATION	DISTANCE	Exc. AREA	Area. Area	VOLUME
WING WALL FOOTING #1 (Sheet #1)				29.7
WING WALL FOOTING #1 (Sheet #2)				46.1
OUTLET HEADWALL (Sheet #3)				
1+16.5 (Station 1+17)	3.5'	72.0'	70.0'	9.1
INLET HEADWALL (Sheet #4)				
0+74	5.4'	60.0'	66.0'	17.2
0+74	0	0	0	0
0+74	4.0'	80.0'	90.0'	6.7
0+78.5	1.5'	127.0'	183.0'	5.8
0+85	10'	127.0'	167.5'	60.6
0+90	10'	127.0'	196.0'	72.6
1+00	10'	127.0'	178.0'	70.4
1+10	7'	186.0'	148.5'	38.8
1+17	3'	0	0	0
1+20	0	0	0	0
9-20-79 FOR				348.5 cu


Book #3, Page #48

Graveling Concrete

STATION	DISTANCE	Exc. AREA	Area. Area	VOLUME
0+78.5	3'	0	0	0
0+78.5	0	0	0	0
0+78.5	1.5'	36.0'	46.0'	4.2
0+80	10'	127.0'	129.2'	29.2
0+90	10'	127.0'	138.0'	38.0
1+00	10'	127.0'	160.0'	57.0
1+10	10'	127.0'	120.0'	33.0
1+17	0	0	0	0
1+20	0	0	0	0
1+20	0	0	0	0
1+20	0	0	0	0
1+20	0	0	0	0
9-20-79 FOR				73.0 cu

Book #3, Page #48

STRUCTURE EXCAVATIONS WING WALL FOOTING #1 (N.T.S.)

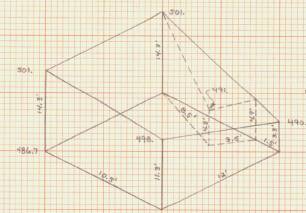

$$\frac{10 \times 10 \times 5 + 10 \times 6 \times 5}{2 \times 5} = 50.4$$

$$\frac{(4.5 \times 3 + 10 \times 3)}{2} \times 2.7 = 4.3$$

9-20-79 FOR 46.1 cu

Station	Dist. (ft)	Exc. Area	Area. Area	Volume (cu)
9+70	0	0	0	0
10+0	10	24	12	4.4
10+20	50	25	25	46.5
10+70 (200)	27.5	25	25	20.4
10+95 (200)	17	17	17	16.1
11+0	2.5	17	18	5.2
11+20	10	17	18	16.1
11+30	40	0	0	0
9-20-79 FOR				120.5 cu

Dist. from Center of Excavation

Station	DISTANCE	Exc. AREA	Area. Area	VOLUME
0+74	2.0'	36.0'	42.0'	4.2
0+78.5	1.5'	36.0'	45.0'	7.0
0+90	11.5'	36.0'	43.0'	2.7
1+17	3'	12.0'	16.0'	11.1
1+20	10'	0	0	0
1+20	0	0	0	0
1+20	0	0	0	0
9-20-79 FOR				105.4 cu

Sta. 10+77.5 to 10+75

$$\frac{(26 \text{ cu} + 20.5 \text{ cu})}{2} (1.5 \text{ ft}) = 31.9 \text{ cu}$$

Total = 154.4 cu to Book #3, Page #48

9-20-79 FOR

SHEET #3

GRATON 74 380
 SECTIONS 7-25-78
 PLOTTED 7-25-78
 CHANNEL SECTIONS