

INDEX OF SHEETS

RECORD PLANS-MATERIAL SUPPLIERS

1. Title, Typical
2. Quantity
3. Plan & Profile
4. E.O.M. Detail Sheet
- 5-6. Blank
7. A-61 Solid Rock Excavation
8. B-5 Rounding of Slopes
9. E-3 Bridge Construction Approach Signs
10. E-4 On Project Construction Signs
11. C-1 Guard Rail, Heavy Duty Steel Beam with Wood Posts, Type II and Anchors
12. C-1a Guard Rail, Heavy Duty Steel Beam with Wood Posts, Type II
13. C-1 Boundary Markers
14. SCB-01-75 Details of W Beam Bridges
15. SCB-06-73 Details of W Beam Bridges
16. SB-46-76 Bridge Rail Mountings
17. Blank
- 18-20. Cross Sections
- 25-30. Bridge Sheets (Includes Grades and Earthworks)

CONTRACTOR-STEPHEN E. AUSTIN, CONCORD, VT.
 CONTRACT DATED - 21 NOVEMBER 1979
 CONSTRUCTION BEGAN - 30 APRIL 1979

STATE OF VERMONT
 AGENCY OF TRANSPORTATION

CONSTRUCTION COMPLETED - 6 SEPTEMBER 1979 ACCEPTED - 19 SEPTEMBER 1979
 RESIDENT ENGINEER - ROBERT A. STEVENS RECORD PLANS - GEORGE J. ABAIR
 GRANULAR BACKFILL FOR STRUCTURES - COOLEY PIT, EAST MONTPELIER, VT.
 SUB-BASE OF GRAVEL - McCULLOUGH PIT, WOODBURY, VT.
 CONCRETE - HUTCH CONCRETE CONTRACTING CORP., MONTPELIER, VT.
 REINFORCING STEEL, WATER REPELLENT - K-ROSS BUILDING SUPPLY CENTER
 LEBANON, N.H.
 EPOXY BONDING COMPOUND - RAMCHEM, MONTPELIER, VT.



BRIDGE RAILING, GUARD RAIL, ANCHORS FOR GUARD RAIL - LAFAYETTE-SHELDON INC., ESSEX JCT., VT.
 SEED - AGWAY, SYRACUSE, N.Y.
 FERTILIZER - AGRICO CHEMICAL CO., BRADFORD, VT.
 AGRICULTURAL LIMESTONE - SWANTON LIME WORKS, SWANTON, VT.

**PROPOSED IMPROVEMENT
 BRIDGE PROJECT**



TOWN OF PLAINFIELD
 COUNTY OF WASHINGTON

ROUTE NO: TH.2, CL. II BRIDGE NO: 12

PROJECT LOCATION: BEGINNING AT A POINT 3.34 MILES NORTHERLY OF THE
 PLAINFIELD/ ORANGE TOWN LINE, AND EXTENDING NORTHERLY 0.038 MILES.


PROJECT DESCRIPTION: Consists of widening the existing Bridge with a P.O. Slab
 Bridge addition on the upstream side, also related roadway and channel work.

LENGTH OF STRUCTURE:	19.4	FEET
LENGTH OF PARTICIPATION ROADWAY:	180.6	FEET
LENGTH OF PROJECT:	200	FEET

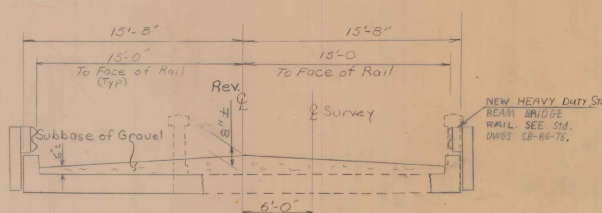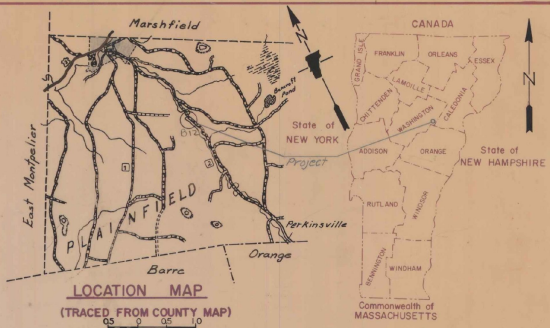

TYPICAL BRIDGE SECTION
 Scale: N7S

BUILT AS DESIGNED

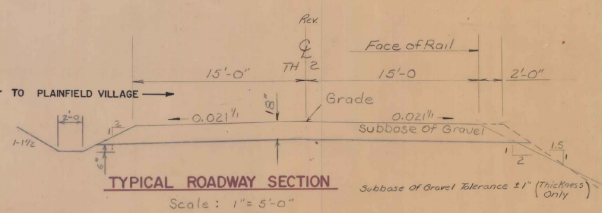


TYPICAL ROADWAY SECTION
 Scale: 1" = 5'-0"

GENERAL NOTES:

1. THE GENERAL NOTE PERTAINING TO SPECIFICATIONS, MATERIALS AND CONSTRUCTION IS SHOWN ON STD. DWG. SCB-DI-75, MODIFIED FOR AN H2O LIVE LOADING AND INCLUDING AN ALLOWANCE FOR 8" OF GRAVEL AND 3" OF FUTURE FRICTION QUOTE THE DECK SURFACE. OTHER NOTES SHOWN ON THE STANDARD THAT ARE NOT OTHERWISE SHOWN OR MODIFIED ARE NOTE 14.
2. ALL MATERIALS AND CONSTRUCTION SHALL CONFORM TO STATE OF VERMONT DEPARTMENT OF HIGHWAYS, STANDARD SPECIFICATIONS FOR HIGHWAY AND BRIDGE CONSTRUCTION, DATED MARCH 1974 AND ITS LATEST REVISIONS AND THE AASHTO STANDARD SPECS FOR HWY. BRIDGES DATED 1977 AND ITS LATEST REVISIONS.
3. ALL CRACKS AND SPALLED AREAS SHALL BE PATCHED WITH MORTAR. SPALLED AREAS DEEPER THAN 1/4" DEPTH SHALL BE FILLED WITH MORTAR. IF DEPTH IS GREATER THAN 1/4" FILL WITH CONCRETE, CLASS A. WHEN CONCRETE IS USED FOR PATCHES, CUT THE EDGES TO PROVIDE A MINIMUM DEPTH OF 1/4". THE ENGINEER SHALL DETERMINE IF PATCHES ARE REQUIRED. AREAS TO BE PATCHED WILL BE KEPT MOIST FOR 24 HOURS MINIMUM BEFORE THE PATCH IS APPLIED. MORTAR AND / OR CONCRETE CLASS A USED FOR THIS PURPOSE SHALL BE MADE SUBSIDIARY TO CONCRETE, CLASS B. AN ESTIMATED 1/2 CUBIC YARD OF CONCRETE, CLASS B IS INCLUDED FOR THIS PURPOSE.
4. REMOVAL OF ALL DISINTEGRATED, SPALLED, AND UNSOUND CONCRETE FOUND IN THE AREAS INDICATED IN NOTE 4, AND ANY NECESSARY REMOVAL OF EXISTING CONCRETE BEYOND THE CUT LINES INDICATED ON THE PLANS SHALL BE PAID FOR AS REMOVAL OF EXISTING CONCRETE OR MASONRY. AN ADDITIONAL QUANTITY OF 1/2 CUBIC YARD HAS BEEN ADDED TO THE QUANTITIES FOR THIS PURPOSE.

CONVENTIONAL SIGNS

- COUNTY LINE
- TOWN LINE
- LIMITS OF ACCESS
- POINT OF ACCESS
- FENCE LINE
- STONE WALL
- TRAVELED WAY
- GUARD RAIL
- RAILROAD
- SURVEY LINE
- CULVERT
- POWER POLE
- TELEPHONE POLE
- TREES
- PROPERTY LINE
- ROW TAKING LINE
- SLOPE SIGNS
- TOP OF CUT
- TOE OF SLOPE

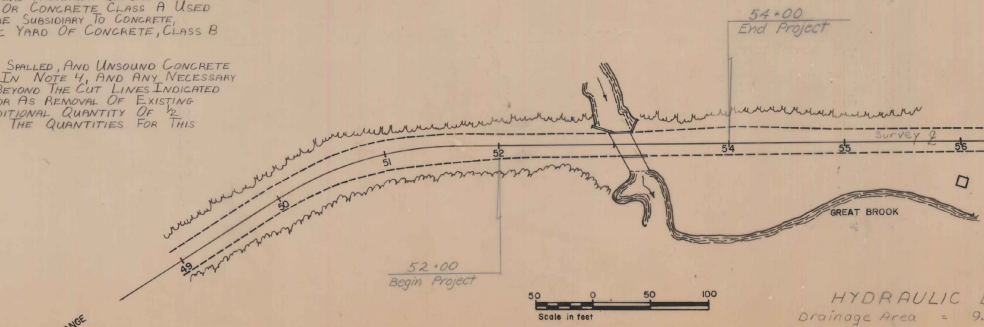

HYDRAULIC DATA

Drainage Area = 9.9 sq. mi.
 Q10 = 1000 cfs HW = 8.8'
 Q25 = 1300 cfs HW = 11.0'
 Q50 = 1600 cfs HW = 11.7'
 Q100 = 1900 cfs HW = 12.1'
 CHW = 38 cfs; depth of flow = 1.5'
 CLW = 10 cfs; depth of flow = 1.0'

Traffic Count

1975 ADT	230
1975 DHV	50
D	53
T	6
1985 ADT	295
1985 DHV	65
Design Speed	25 M.P.H.
5 Year Accidents	- 4

These plans are subject to such engineering changes as may be required by the Federal Highway Administration or the Director of Engineering and Construction.
 Construction is to be carried on in accordance with these plans and the Standard Specifications for Highway and Bridge Construction dated March, 1976, as approved by the Federal Highway Administration on a project to project basis including all subsequent revisions and such revised specification and special provisions as are incorporated in these plans.

SUBMITTED BY ORDER OF THE STATE TRANS. BOARD
 APPROVED: *S. J. Pope* DATE: 8-29-78
 DIRECTOR OF ENGINEERING AND CONSTRUCTION
 DEPARTMENT OF TRANSPORTATION
 FEDERAL HIGHWAY ADMINISTRATION
 APPROVED: _____ DATE: _____
 DIVISION ENGINEER
 PROJECT: SRS NO 2302 (2)
 SHEET 1 OF 30 SHEETS
 DHD SRS 12/17/70

DRAINAGE AND ITEM QUANTITY SHEET

STATE OF VERMONT DEPARTMENT OF HIGHWAYS
PROJECT SRS NO. 2302 (2)

APPROXIMATE SUMMARY OF QUANTITIES						DETAILED SUMMARY OF QUANTITIES				DRAINAGE STRUCTURES																		
BRIDGE	ROADWAY	GRAND TOTAL	UNIT	ITEM	ITEM NO.	QUANTITY	UNIT	ITEM	STA.	POS.	OLD CULVERT	TYPE	ACC.G.M.P.	G.M.P.	C.A.A.C.P.	R.C.P.	CR.M.	TRENCH	EXCAV.	MARKER	ASKEW	CONC.	REINF.	DI.	DEPTH	DITCHES	REMARKS	
																			EARTH	ROCK	LT.	RT.	IN	OUT	IN	OUT		
	1	1	L.S.	Clearing & Grubbing	201.10																							
	24	24	C.Y.	Removal of Existing Concrete or Masonry	202.35																							
	730	730	C.Y.	Common Excavation	202.45																							
	50	50	C.Y.	Unclassified Channel Excavation	203.27																							
	50	50	C.Y.	Earth Borrow	Est. 201.30																							
	200	200	C.Y.	Seed Borrow	Est. 201.31																							
	78	78	C.Y.	Trench Excavation of Earth	Est. 204.00																							
	200	200	C.Y.	Structure Excavation	204.25																							
	280	280	C.Y.	Granular Backfill for Structures	204.30																							
	500	520	C.Y.	Subbase of Gravel	1	301.15																						
	2150	3300	CU/M	Overhaul (7.5 Miles)	306.10																							
	100	100	C.Y.	Stripping of Pits	Est. 307.10																							
	118	118	C.Y.	Concrete, Class B.	501.25																							
	10,670	10,670	lb.	Reinforcing Steel	507.15																							
	9	9	Gal.	Motor Repliment	515.10																							
	100	100	L.F.	6" Underdrain	Est. 609.00																							
	2	2	Hr.	Bulldozer Rental, Type I	Est. 608.10																							
	2	2	Hr.	All Purpose Excavator Rental	Est. 608.25																							
	2	2	Hr.	Truck Rental	Est. 608.37																							
	90	90	N/Gal.	Dust Control w/ Water	Est. 609.10																							
	40	40	C.Y.	Stone Fill, Type II	613.11																							
	2	2	Gal.	Epoxy Bonding Compound	615.30																							
	40	40	L.F.	Bridge Railing - Heavy Duty Steel Beam	617.35																							
	5	5	Eq.	Boundary Markers	Est. 619.10																							
	300	350	L.F.	Guard Rail Heavy Duty Steel Beam w/ Wood Post Type II	621.38																							
	108	108	L.F.	Temporary Barrier Rail	621.56																							
	4	4	Eq.	Anchor for St. Beam G.R. w/ St. or Wood Post @ Openings	621.70																							
	1	1	L.S.	Maintenance of Traffic for Bridge Project	627.10																							
	Erosion Control	40	C.Y.	Stone Fill, Type I	Est. 3	613.10																						
		15	lb.	Seed	631.10																							
		100	lb.	Fertilizer	631.15																							
		0.4	Ton	Agricultural Limestone	631.20																							
		0.4	Ton	Hay Mulch	631.25																							

Guard Rail, Heavy Duty Steel Beam w/ Wood Posts, Type II									
STA.	STA.	POS.	LENGTH	FACT.	SPACING	FACTORED LENGTH	TERMINAL SECTION	ANCHOR	ITEM 621.70
52+40	52+91	LA.	78'	1.2	6'-3"	93.6'	2'	1	
			12.5'	1.6	4'-2"	19.5'			
			12.5'	1.6	3'-11"	20.0'			
52+17	53+06	RA.	89'	1.2	6'-3"	75.8'	2'	1	
			12.5'	1.6	4'-2"	19.5'			
			12.5'	1.6	3'-11"	20.0'			
53+10	53+73	LA.	47'	1.2	6'-3"	45.4'	2'	1	
			12.5'	1.6	4'-2"	17.5'			
			12.5'	1.6	3'-11"	20.0'			
53+25	53+77	RA.	78'	1.2	6'-3"	58.6'	2'	1	
			12.5'	1.6	4'-2"	17.5'			
			12.5'	1.6	3'-11"	20.0'			
			Sub-Total			342.0	8	4	
			Total			350.0			

TYPE OF CONSTRUCTION: Bridge Widening and Related Roadway and Channel Work									
STATIONS		GRAVEL WIDTHS		EQUATIONS		REMARKS		LENGTH OF PROJECT	
FROM	TO	15'	20'	+	-			STA.	STA.
52+00	54+00	30'	200'					52+00	54+00
								FEET	MILES
								200	.038

PLAINFIELD	PROJECT SRS NO. 2302(2) SHEET 2 OF 30
------------	--

GUARD RAIL, HEAVY DUTY STEEL BEAM
 WOOD POSTS, TYPE II (6'-3" Spacing)


52+46.39	52+91.17
52+17	53+05.17
53+10	53+50.00
53+25	53+95.00
	30

CONSTRUCT DRIVE
 54+00 LT.

SPECIAL DITCH
 52+50 - 50+80
 STONE FILL TYPE I


BM #4
 S.I.T. 12" M
 ASSUMED
 Elev. 500.00

REV. PI 54+00
 $\Delta 1^\circ 20'$ RT.

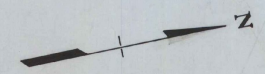

Rev PI 50+94.49 =
 50+88.91
 P.I. 50+83.3 =
 50+78.2

Use G1-d Std. End Sections
 At All Guard Rail Ends

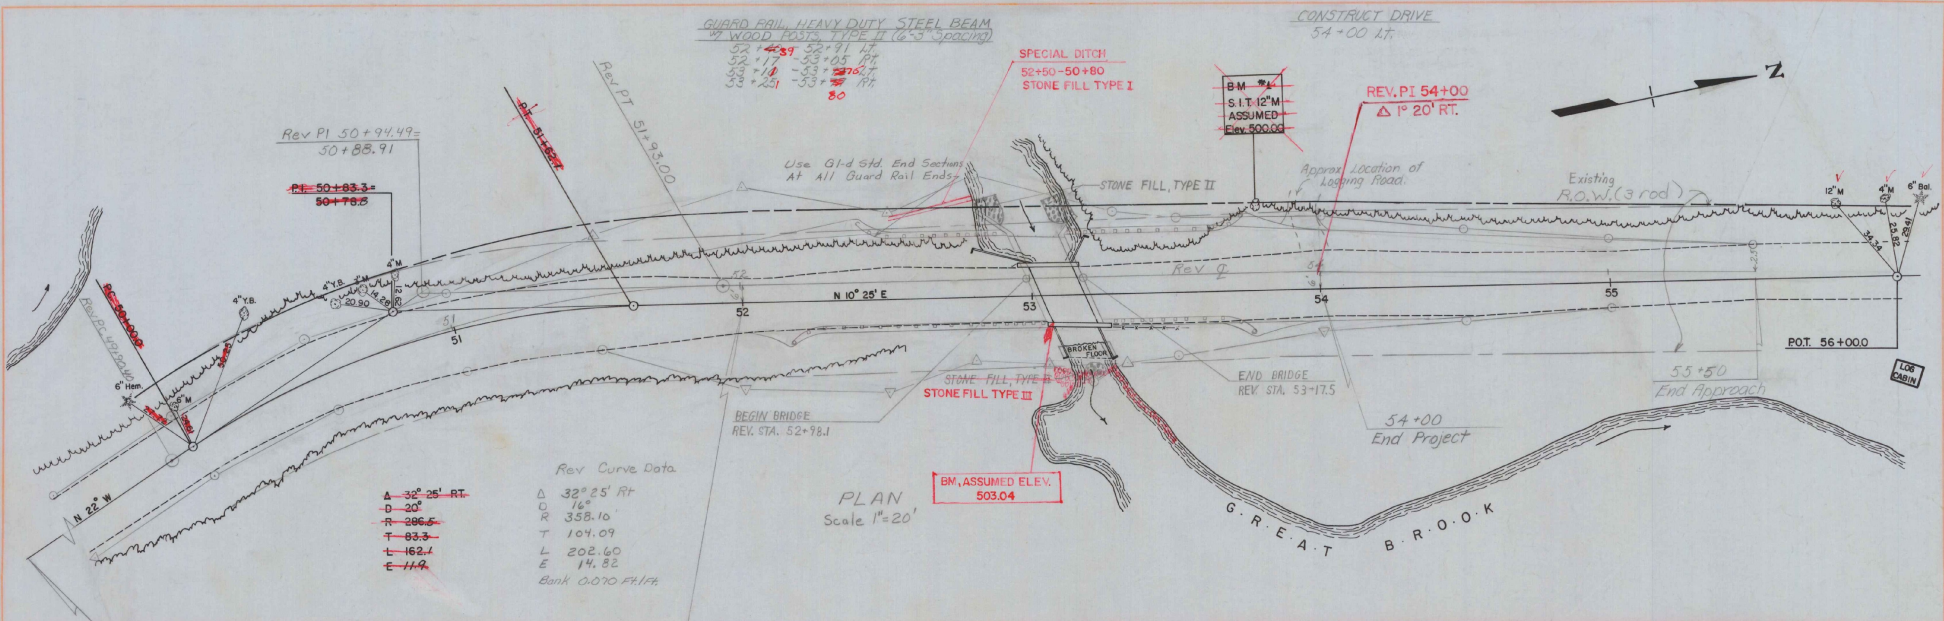

Δ -32' 25" RT.
 D -20'
 R -386.5'
 T -83.3'
 L -162.1'
 E -11.9'


Rev Curve Data
 Δ 32' 25" Rt
 D 16'
 R 358.10'
 T 104.09'
 L 202.60'
 E 14.82'
 Bank 0.070 FH/FH

PLAN
 Scale 1"=20'

SEED, ITEM 65110		NAME	PUR%	Germ%
% Wt	Lbs/A			
3.33	2	CROWN VETCH	97	75
50.00	30	CREeping RED FESCUE	98	85
8.33	5	TIMOTHY	99	85
16.67	10	PERENNIAL RYE GRASS (var. Pennfine)	95	85
8.34	5	ALFALFA (var. Sorenac)	99	85
8.33	5	BIRDFOOT TREFOL (var. Empire)	98	85
5.00	3	HIGHLAND BENT GRASS	92	85
100.00	60			

The seed mixture shall not have a weed content exceeding 0.40% by weight and shall be free from all noxious weed seed.

FOR ROUNDING OF SLOPES, SEE STANDARD SHEET B-5
 HAY MULCH, ITEM 651.25 TO BE PLACED ON ALL EARTH SLOPES, AT THE RATE OF TWO TONS PER ACRE.
 FERTILIZER, ITEM 651.15 SHALL BE MIXED AS FOLLOWS, AND APPLIED TO ALL EARTH SLOPES.
 NITROGEN 10 %
 PHOSPHORUS 20 %
 POTASH 10 % (20% IN SANDY SOIL)
 FERTILIZER SHALL BE DELIVERED IN BAGS NOT TO EXCEED 100 LBS EA. AND IS TO BE APPLIED AT THE RATE OF 500 LBS. PER ACRE.
 AGRICULTURAL LIMESTONE, ITEM 651.20, TO BE APPLIED TO ALL EARTH SLOPES AT THE RATE OF TWO TONS PER ACRE OR AS DIRECTED BY THE ENGINEER.

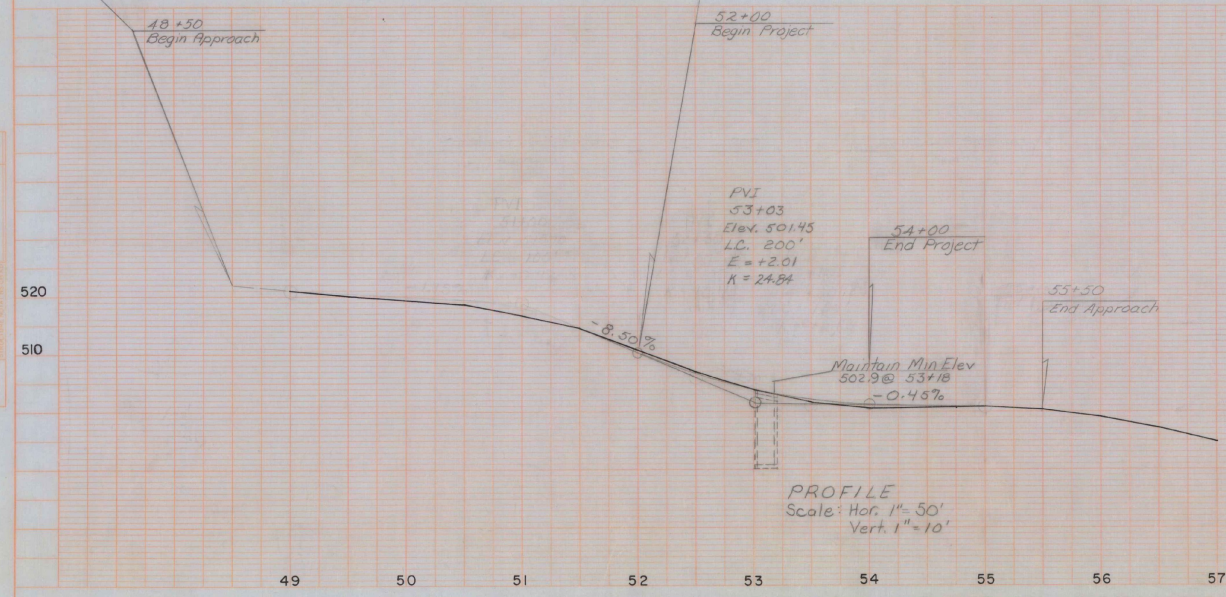

PROFILE
 Scale: Hor. 1"=50'
 Vert. 1"=10'

PLAINFIELD
 SRS 2302 (2)

Sheet 3 of 30

STATE OF VERMONT
DEPARTMENT OF HIGHWAYS
RIGHT-OF-WAY PLANS
DETAIL SHEET

TABLE OF PROJECT PROPERTY ACQUISITION

PARCEL NO.	GRANTOR	SHEET NO.	BEGINNING STATION	ENDING STATION	TAKING	REM.	RIGHTS	TITLE TAKEN	DATE	TOWN OR CITY RECORDED	BK.	PG.	REMARKS
1	SAMAN, PETER S	3	50+73 LT. 51+70 LT. 53+05 LT.	55+50 LT. 53+25 LT. 53+15 LT.	0.06A ±	202.94A ±	SLOPE (P) (700 S.F. ±) CHANNEL (P) (253 S.F. ±)						2450 S.F. ±
2	TOWN OF PLAINFIELD - LESSOR GRIGGS, ALBERT O. & ONDREE S. - LESSEES	3	51+85 RT. 53+07 RT.	52+75 RT. 53+32 RT.			SLOPE (P) (400 S.F. ±) CHANNEL (P) (125 S.F. ±)						
3	DELETED												FORMERLY: LUND, WEBSTER S. & GLADYS I.

TABLE OF REVISIONS

REVISION NO.	SHEET NO.	DESCRIPTION OF REVISION	DATE	MADE BY	APPROVED BY
1	3	Parcel #1 Saman added Construct Drive 54+00 Lt. to Layout Sheet Per C.O. # 3353.	4/26/77	A.G.S.	WEB
2	2	Parcel #1 Saman Reused Slope Right Area from 7253 S.F. to 700 S.F. Per C.O. # 3375	5-19-77	KOP	T.R.M.
3	3	PARCELS 2 & 3 - GRIGGS & LUND. CHANGED P/L & DELETED PARCEL # 3. ADDED CHANNEL RIGHT AREA TO PARCEL # 2. PER C.O. # 3385	5-25-77	NBB	T.R.M.
4	2 & 3	Parcel #1 Saman, Delete Town of Plainfield-Lessor. Per C.O. # 3670	1-27-78	A.G.S.	T.R.M.

MADE BY: A.G.S. DATE 3/21/77
CHECKED BY: W.E.B. DATE 3/21/77

DR. RT - DRAINAGE RIGHT
DIT. RT - DITCHING RIGHT
CH. RT - CHANNEL RIGHT
DRIVE RT - DRIVE RIGHT
CUL. RT - CULVERT RIGHT
D - DEMOLITION OR
REMOVAL
W - WATER SOURCES

PRESENT R.O.W.
--- TAKING WITHOUT ACCESS
--- P --- TAKING WITHOUT ACCESS ALONG PROPERTY LINES
--- TAKING WITH ACCESS
(P) PERMANENT EASEMENT
(T) TEMPORARY EASEMENT

LEGEND


SR - SR - SLOPE RIGHTS
P - P - PROPERTY LINE
- Δ - Δ - TOP OF CUT
- O - O - TOP OF SLOPE

APPROVED: *Thomas P. May* DATE 3-21-77
CHIEF OF PLANS & TITLES

PROJECT PLAINFIELD

NO. SRS 2302 (2)
SHEET 2 OF 3

Sheet 4 of 30

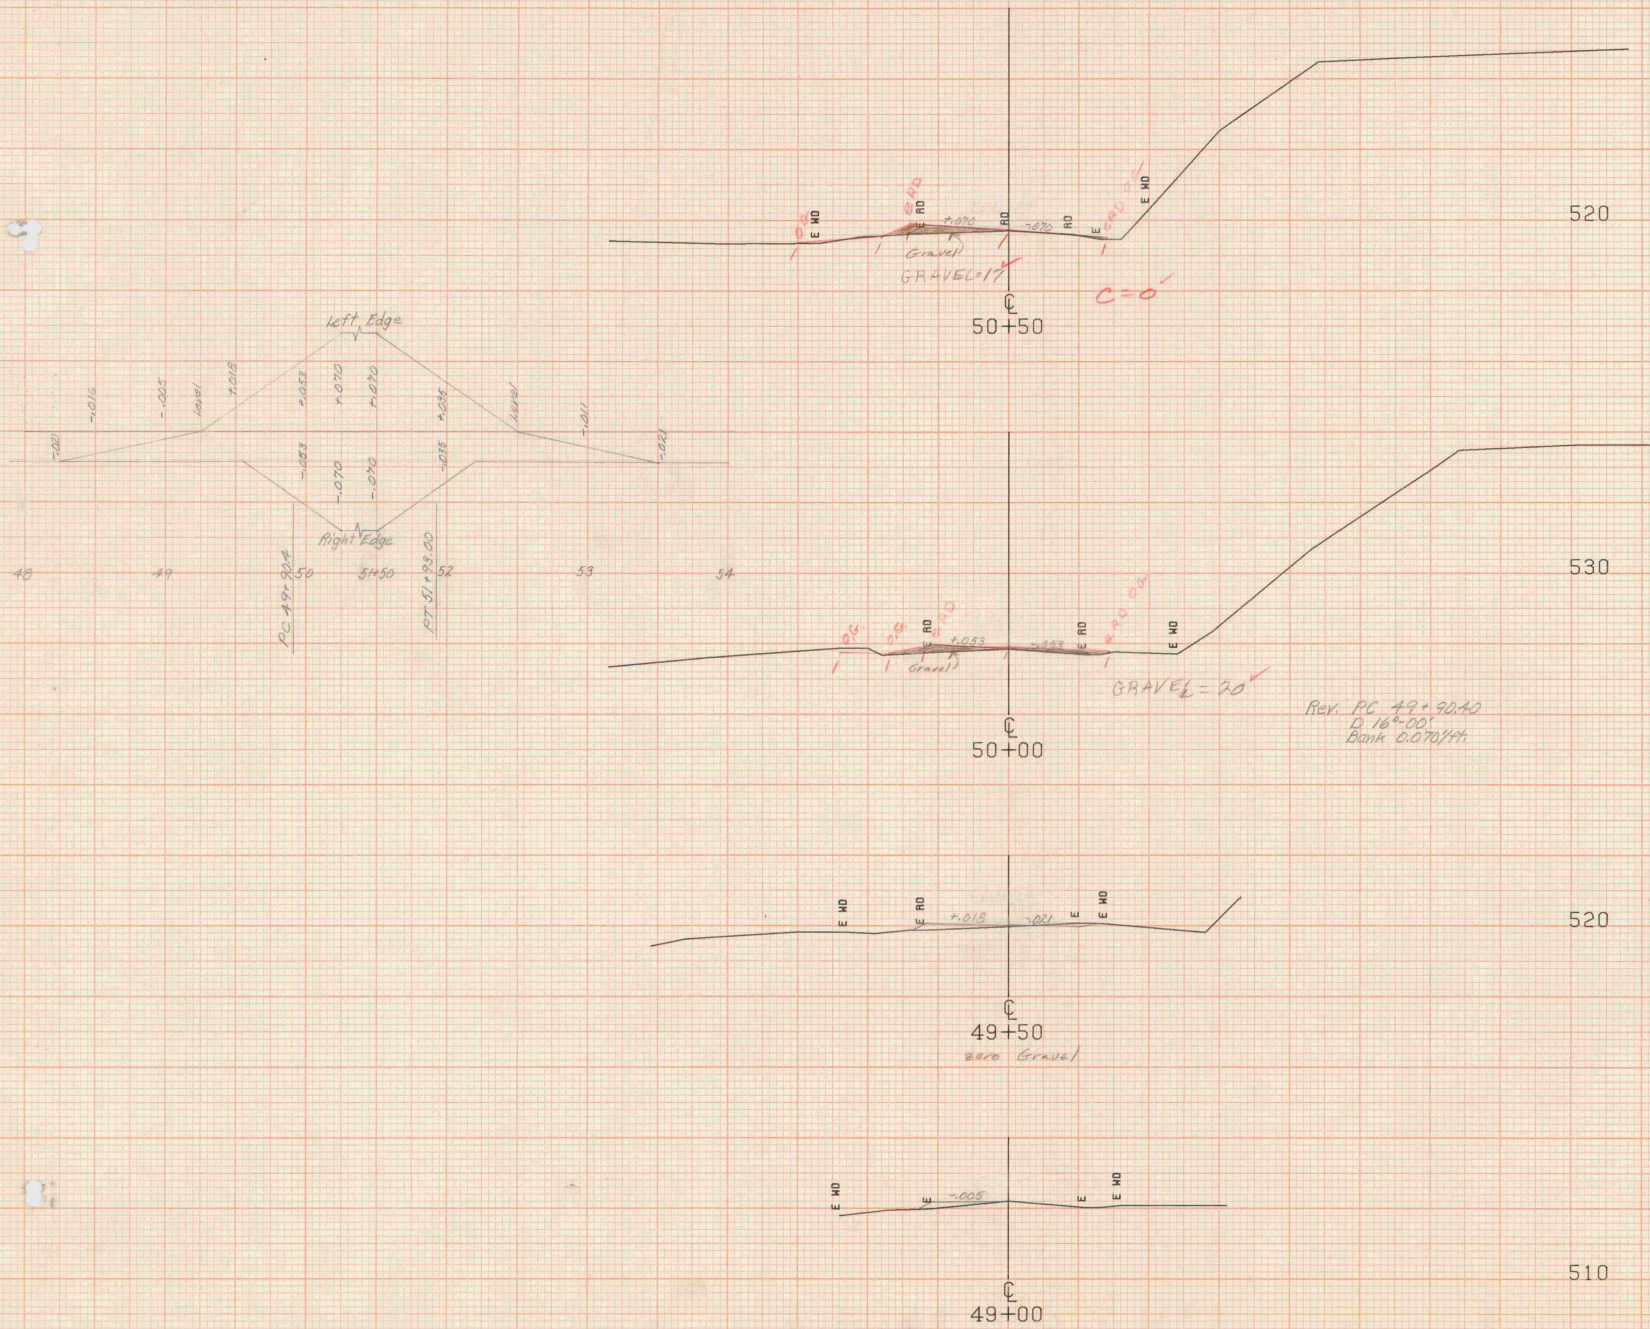


48+50
Begin Approach
Finals DIT at 30 August 1979 P2
Drawn 4 September 1979 P2


Rev. PC 49+90.40
D. 16-005
Bank 0.070/194

SCALE 1" = 10 FEET

FROM STA. 49+00	TO STA. 50+50
PROJECT NAME	PLAINFIELD
NO.	SRS2302 (2)
SURVEYED BY	FANTONI
SHEET 18 OF	SHEETS 30
	PLOTTED 05/15/75
	MAY 1975

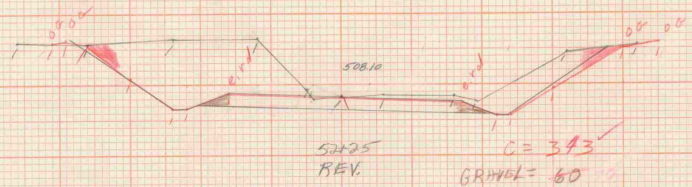


510
 52+17 ~ 53+05 RT
 Guard Rail, Heavy Duty Steel Beam
 w/ Wood Posts, Type II (6'-3" Spacing except
 in transition area. See Detail on Sheet 18 of 30)

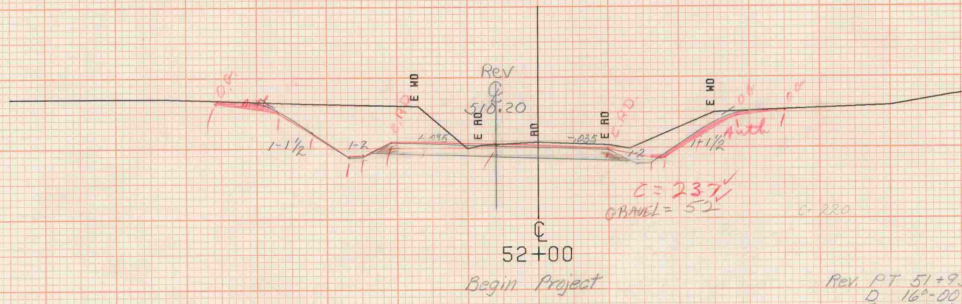


510

Rev. PT 51+93.00
 D. 16'-00"
 Bank 0.070194

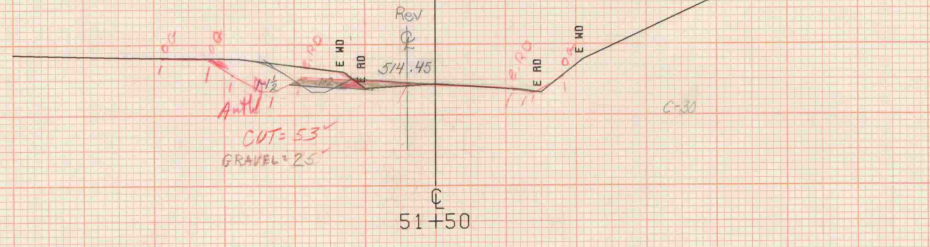

520

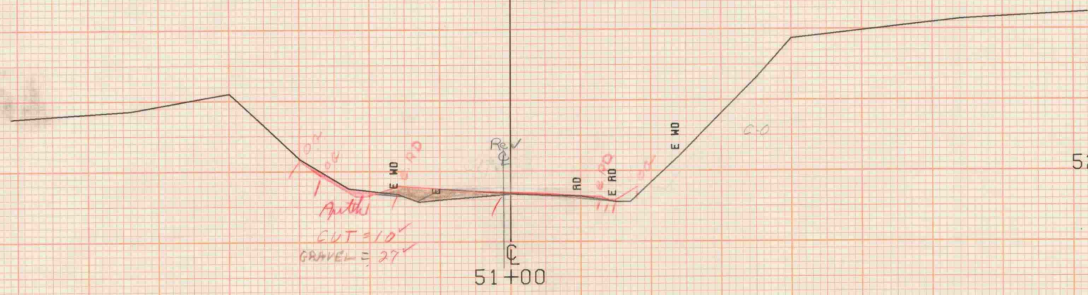

520


FINALS PLATTED 31 August 1977
 PLAN # 4 September 1977

FROM STA. 51+00	TO STA. 52+00
PROJECT NAME	PLAINFIELD
NO.	SRS2802 (2)
SURVEYED BY	FANTONI
SHEET 19 OF	SHEETS 30
	PLOTTED 05/15/75
	MAY 1975

SCALE 1" = 10 FEET

52+91 ~ 53+10 LT
 Bridge Railing - Heavy Duty
 Steel Beam

53+05 ~ 53+25 RT
 Bridge Railing - Heavy Duty
 Steel Beam

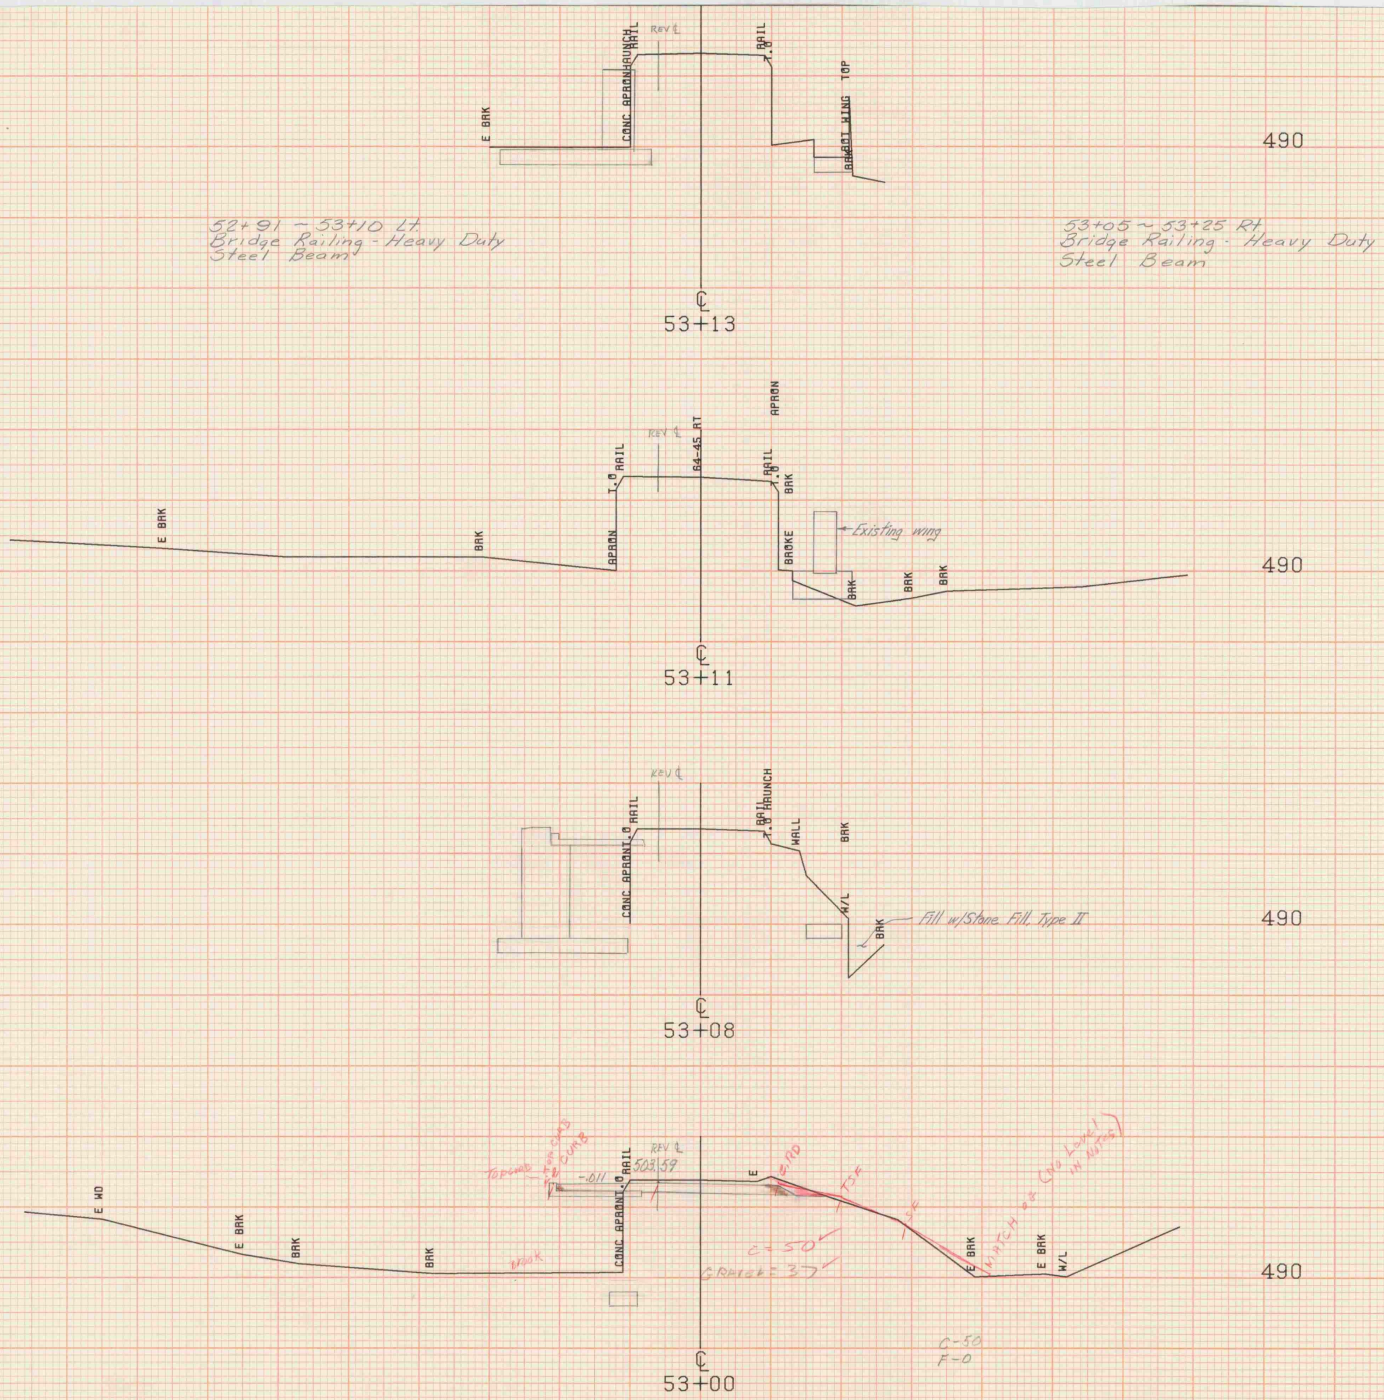

490

53+13

490

53+11

490

53+08


490

53+00

Finals Plotted 31 August 1979 PLS
 PLS 1 2 September 1979 PLS Plan # 9/11/79

FROM STA. 53+00	PLAINFIELD	TO STA. 53+13
PROJECT NAME	SRS2302 (2)	PLOTTED 05/15/75
NO.	FANTONI	MAY 1975
SURVEYED BY		
SHEET 21 OF	SHEETS 30	


SCALE 1" = 10 FEET

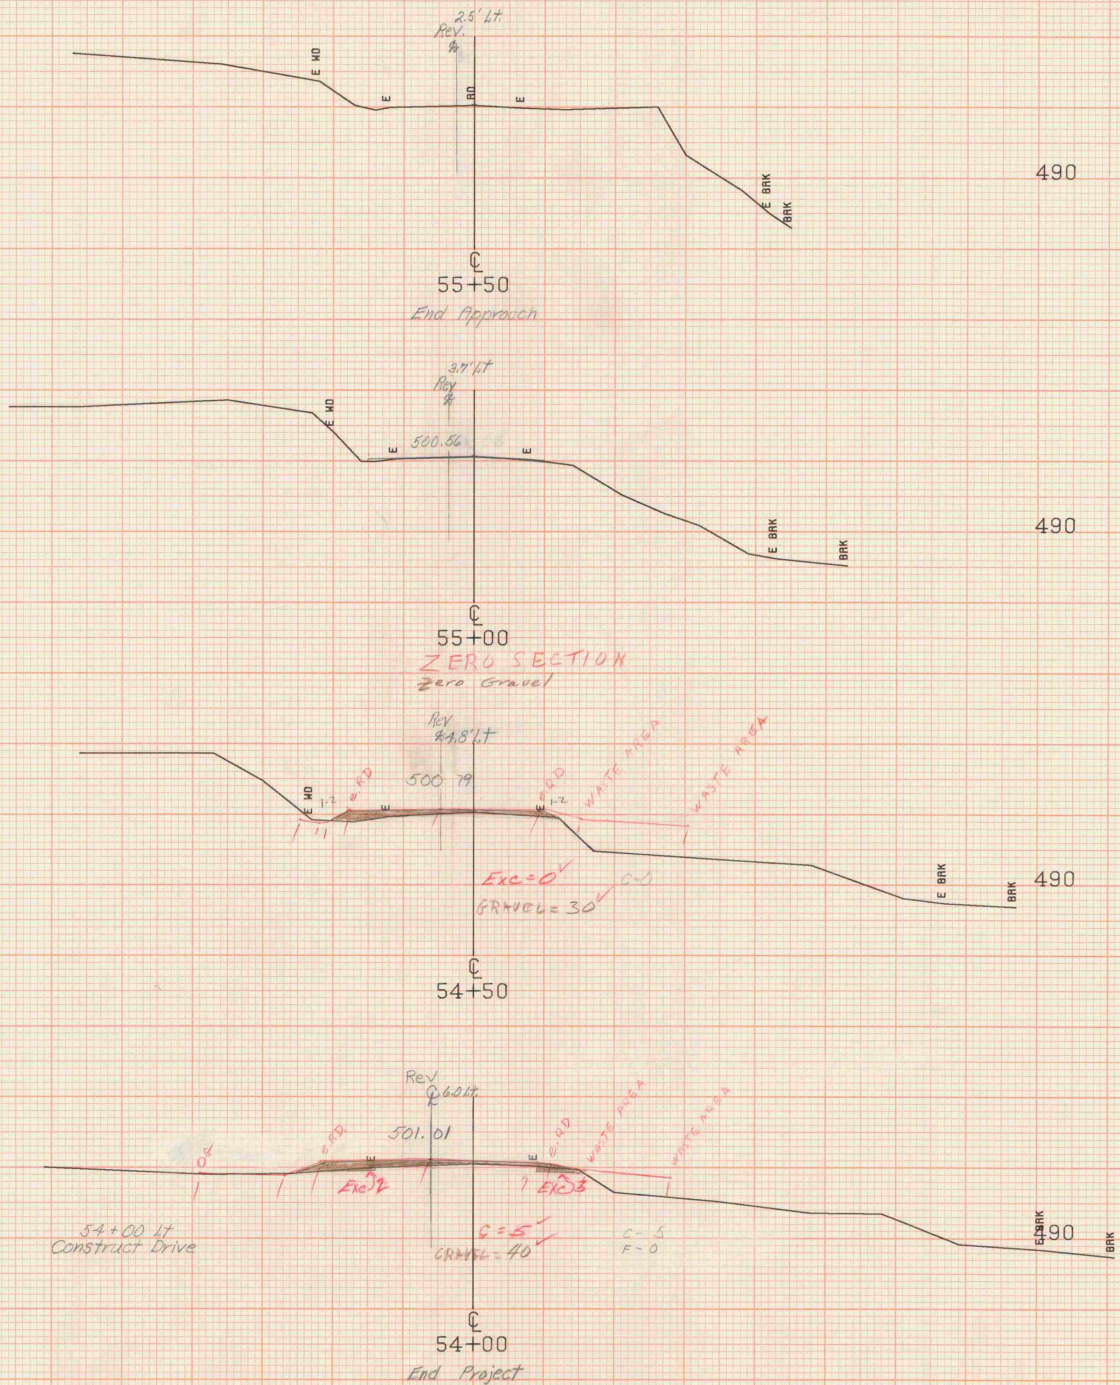

Finals Plotted 31 August 1979 MSJ
 PLAN 4 September 1979 MSJ
 Plan ID 9/4/79

FROM STA. 54+00	TO STA. 55+50
PROJECT NAME	PLAINFIELD
NO.	SRS2302 (2)
SURVEYED BY	FANTONI
SHEET 23 OF	SHEETS 30
	PLOTTED 05/15/75
	MAY 1975

SCALE 1" = 10 FEET

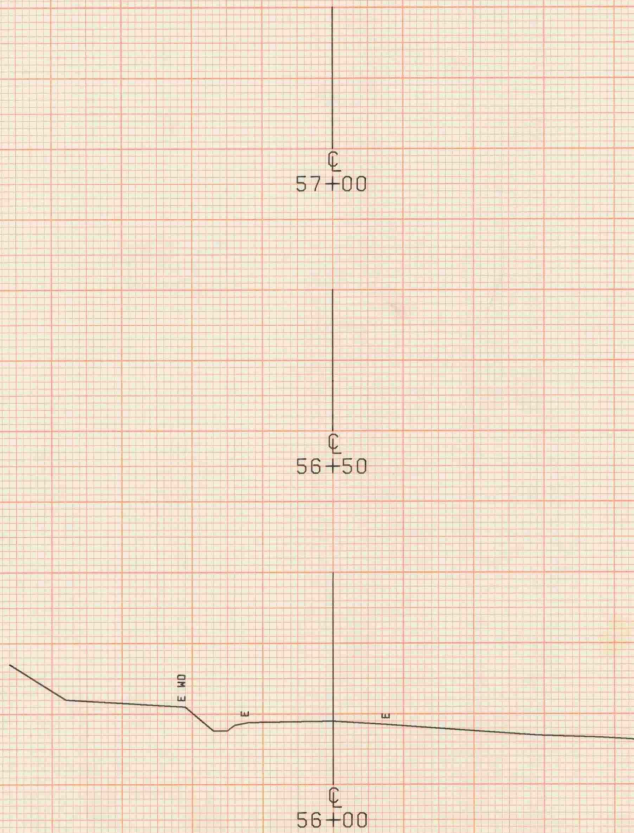

490

C
57+00

490

C
56+50

500

C
56+00

FROM STA. 56+00	TO STA. 57+00
PROJECT NAME	PLAINFIELD
NO.	SR52302 (2)
SURVEYED BY	FANTONI
SHEET 24 OF	SHEETS 30
	PLOTTED 05/15/75
	MAY 1975

SCALE 1" = 10 FEET

EARTHWORK

V.C.	% GRD	STATION	GRADES		CORR. V.C.	DIST.	Cut		Fill	
			ELEVATION ON TAN.	ELEVATION ON V.C.			AREA	CU. YDS.	AREA	CU. YDS.
		51+00					0			
		+50	514.45			50'	30	28		
		52+00	510.20			50'	220	231		
		+03	507.75	507.75	0	50'	292			
		+50	505.75	506.39	+0.44	75'	95			
		+78.1	501.86	503.68	+1.82	78.1'	50	129		117
		53+00	501.70	503.57	+1.87					
		+03	501.45	502.46	+2.01					
		+17.5	501.38	502.85	+1.47	32.5'	50	33		
		+50	501.24	501.81	+0.57	50'	5	9		
		54+00	501.01	501.01	0	50'	5			
		+03	501.00	501.00	0	50'	5			
		+50	500.79							
		55+00	500.56							
						Total	727	127		

BRIDGE QUANTITY SHEET

STATE OF VERMONT
DEPARTMENT OF HIGHWAYS
BRIDGE DIVISION

NO.	ITEM	UNIT	QUANTITY BREAKDOWN				TOTAL	FINAL
			ABUTMENT #1	ABUTMENT #2	SUPERSTR.	CHANNEL		
*301.15	SUBBASE OF GRAVEL				10	11	10	11
202.25	REMOVAL OF EXISTING CONCRETE OR MASONRY	C.Y.	7	18.38	6	16.27	11	12.26
203.27	UNCLASSIFIED CHANNEL EXCAVATION	C.Y.				50	0	
204.25	STRUCTURE EXCAVATION	C.Y.	190	102.8	130	54.5		320
204.30	GRANULAR BACKFILL FOR STRUCTURES	C.Y.	180	121.1	100	67.7		280
306.10	OVERHAUL (7.5 MILES)	%MI.	1350	312	750	167		2100
501.25	CONCRETE, CLASS B	C.Y.	58	55.6	43	41.08	17	16.60
507.15	REINFORCING STEEL	LB	4810		3810	2050		10,670
514.10	WATER REPELLENT	GAL	3		2	4		9
613.11	STONE FILL, TYPE II	CY				40		40
613.12	STONE FILL TYPE III							303.4
615.30	EPOXY BONDING COMPOUND	GAL			2			2
617.35	BRIDGE RAILING-HEAVY DUTY STEEL BEAM	LF			40			40
621.56	TEMPORARY BARRIER RAIL	LF			108			108
637.10	MAINTENANCE OF TRAFFIC FOR BRIDGE PROTECTS	L.S.			1			1
40495	TAH EMULSION				25			25

NOTE: AN ESTIMATED AMOUNT OF 30 CY OF UNCLASSIFIED CHANNEL EXCAVATION HAS BEEN ADDED TO THE QUANTITIES TO BE USED IF DEEMED NECESSARY BY THE ENGINEER.

* INDICATES A ROADWAY QUANTITY

LIST OF SHEETS

- BR-1 BRIDGE QUANTITY SHEET
- BR-2 PLAN & ELEVATION
- BR-3 SLAB DETAILS
- BR-4 ABUTMENT #1 DETAILS
- BR-5 ABUTMENT #2 DETAILS
- BR-6 REINFORCING STEEL SCHEDULE

STANDARDS

- SCB-D1-75 4-3-78 (R)
- SCB-D6-73 4-3-78 (R)
- SB-R6-76 1-8-76

REFERENCE SHEETS



TITLE SHEET WITH LAYOUT AND TYPICAL SECTIONS
ROADWAY LAYOUT AND PROFILE SHEET
ROADWAY CROSS SECTIONS
STA 49+00-56+00

BRIDGE (S) AT STATION (S) 53+07.8
LOCATION (S) TH #2 OVER GREAT BROOK

Prepared by WILLEY Checked by PERKINS
SUPERVISOR: F. BOLKUM


PLAINFIELD PROJECT NO. SRS 2302 (2)
BR 1 OF 6 SHEET NO. 25 OF 30

FINALS 3/14/77 LK

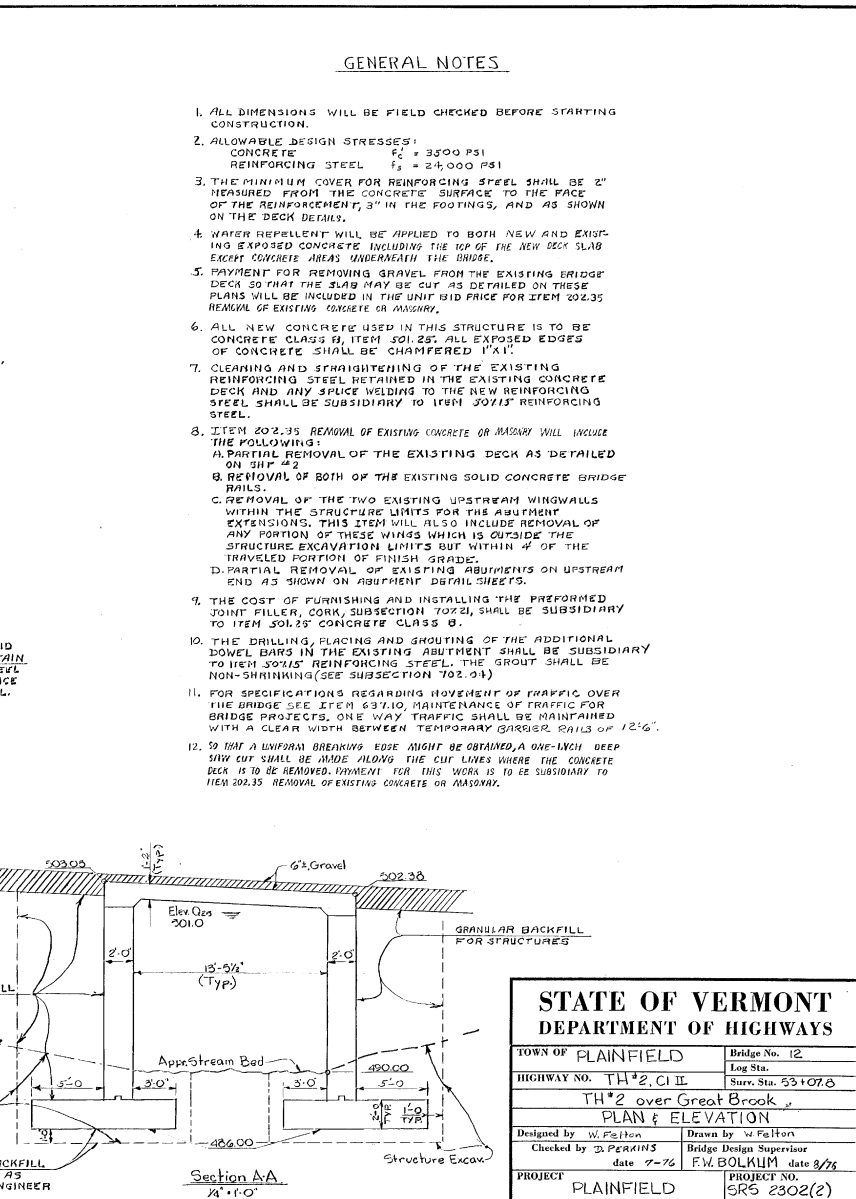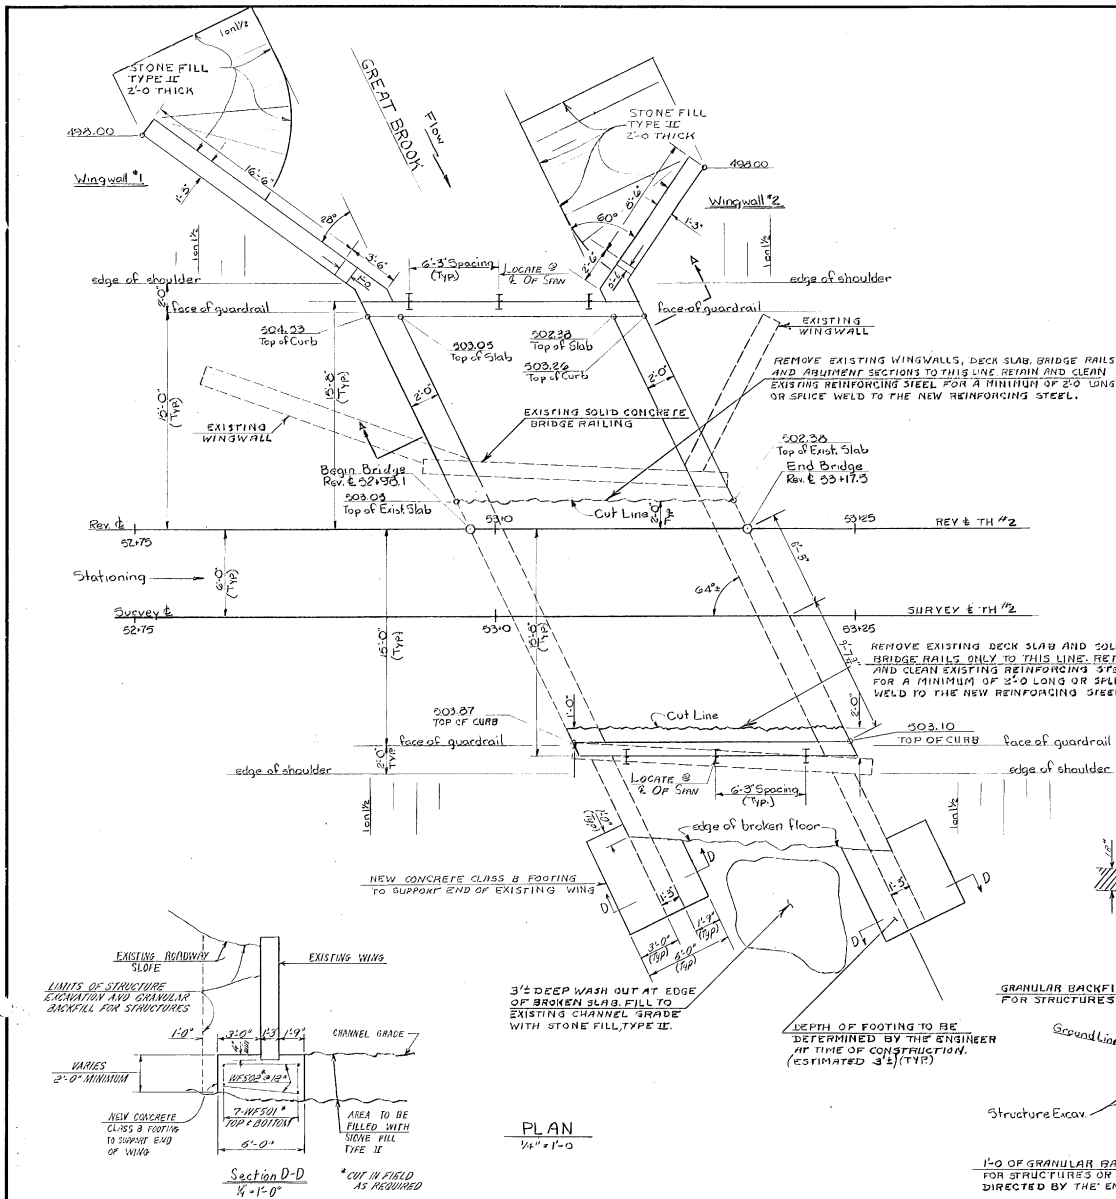

STATE OF VERMONT DEPARTMENT OF HIGHWAYS	
TOWN OF PLAINFIELD	Bridge No. 12
HIGHWAY NO. TH#2 CI II	Log Sta. Surv. Sta. 53+07.0
TH#2 over Great Brook PLAN & ELEVATION	
Designed by W. P. Moran	Drawn by W. Felton
Checked by D. PERKINS	Bridge Design Supervisor
date 7-76	F.W. BOLKUM date 8/76
PROJECT PLAINFIELD	PROJECT NO. SR5 2302(2)
Bridge Sheet No. 2	Sheet 26 of 30

Note: Weld Splice to be used only where bar lap is less than 2'-0"

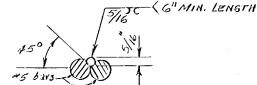


WELD SPICE DETAIL


N.T.S.

NOTE


THE TEMPORARY BARRIER RAIL SHALL BE ANCHORED TO THE EXISTING DECK IN THE LOCATION SHOWN BELOW. ANCHORAGE DETAILS SHALL BE SUBMITTED TO THE ENGINEER FOR APPROVAL PRIOR TO CONSTRUCTION. HOLES IN THE EXISTING DECK SHALL BE FILLED WITH MORTAR UPON REMOVAL OF ANCHOR BOLTS. SEE SPECIAL PROVISIONS.

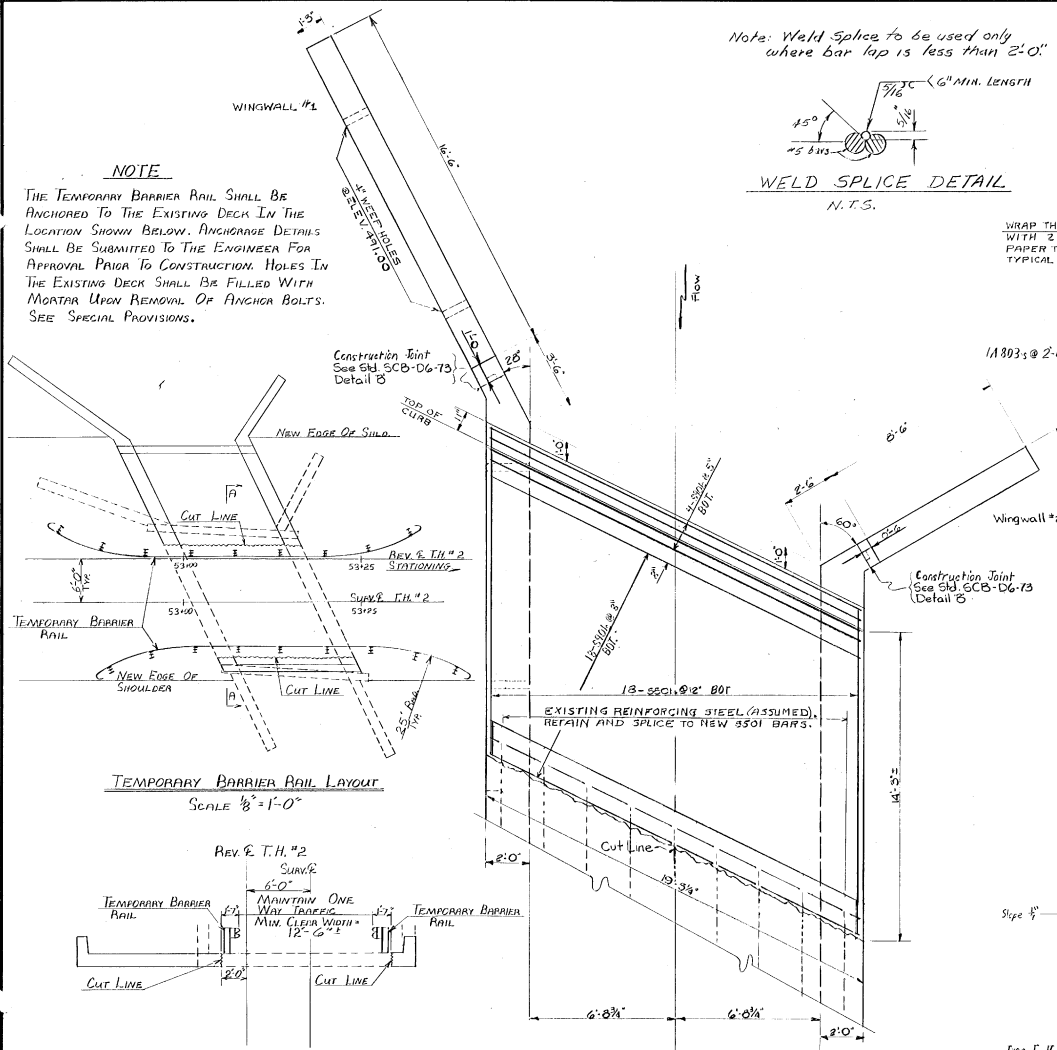


TEMPORARY BARRIER RAIL LAYOUT
SCALE 1/8" = 1'-0"

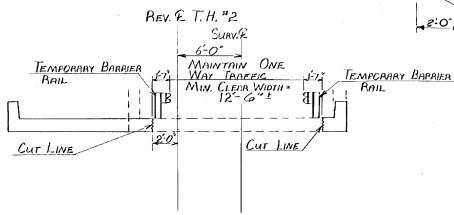

SECTION A-A
SCALE 3/8" = 1'-0"

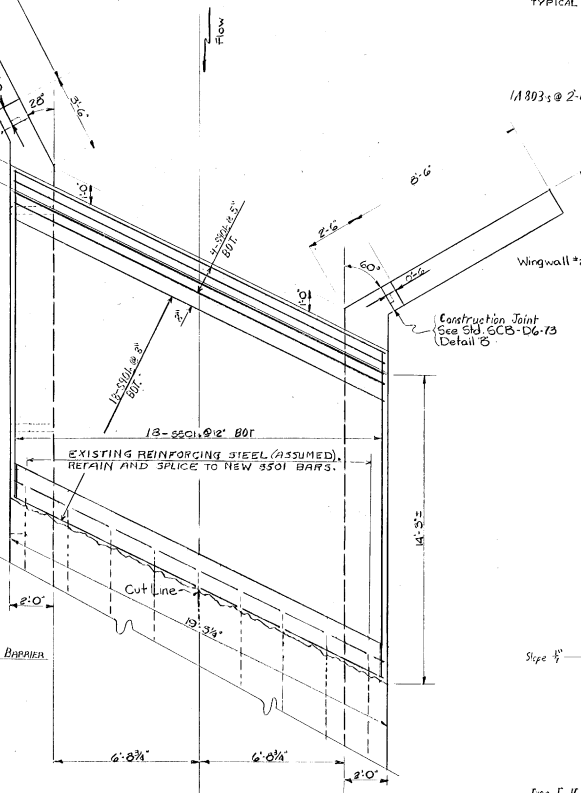


SLAB REINFORCING PLAN
SCALE 3/8" = 1'-0"

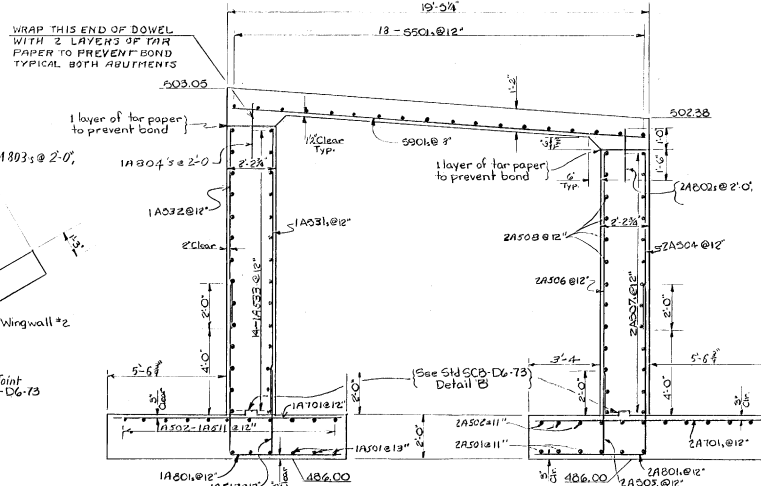

Typical Section Along Skew

3/8" = 1'-0"

Note: All Horizontal Dimensions In This View Are Skewed Dimensions.






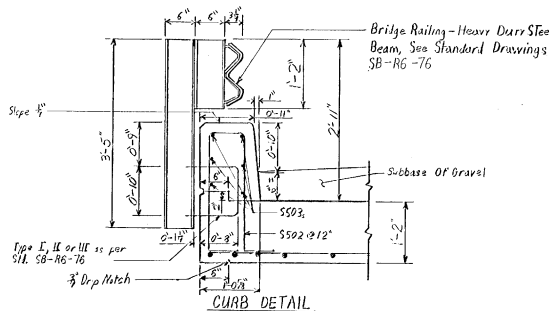


CURB DETAIL


SCALE 1" = 1'-0"

**STATE OF VERMONT
DEPARTMENT OF HIGHWAYS**

TOWN OF	PLAINFIELD	Bridge No.	12
Highway No.	TH #2, C12	Log Sta.	
		Surv. Sta.	53+07.8
TH #2 over Great Brook			
SLAB DETAILS			
Designed by	D. Perkins	Drawn by	W. Felton
Checked by	J. COURFARE	Bridge Design Supervisor	
	date JULY 77	F.W. BOLKUM	date 8/76
PROJECT	PLAINFIELD	PROJECT NO.	SR5 2302(2)
Bridge Sheet No.	3	Sheet	27 of 30

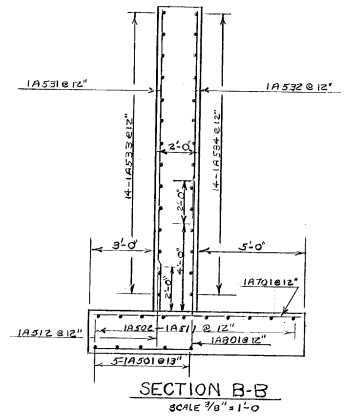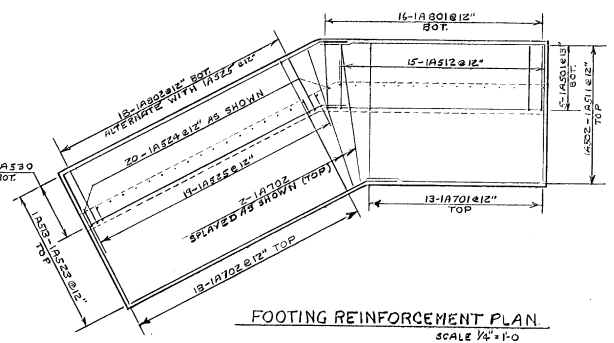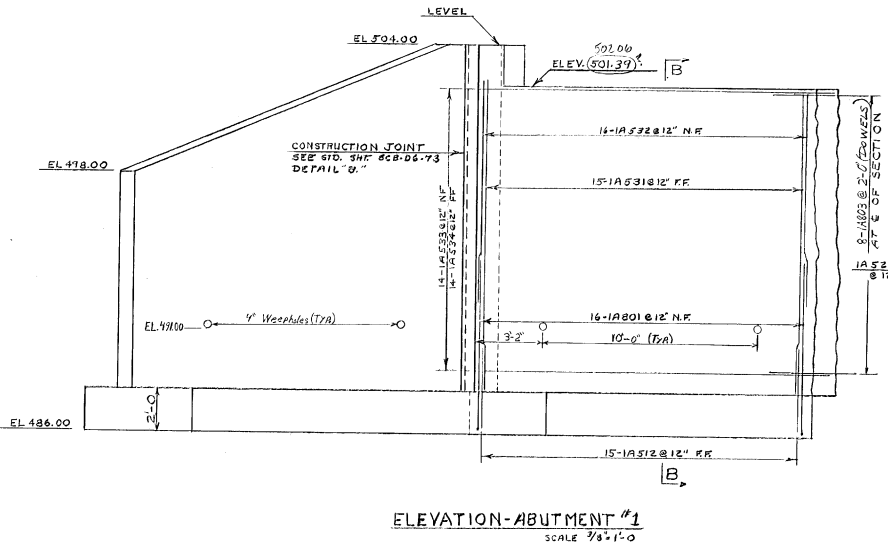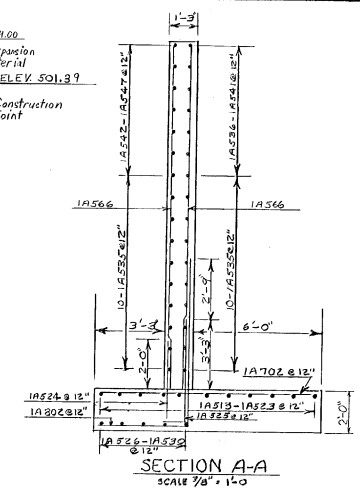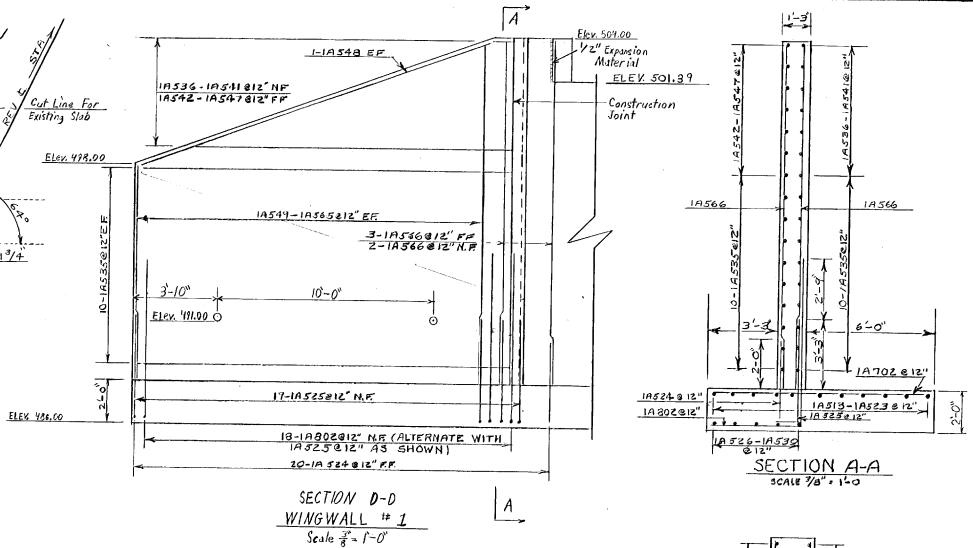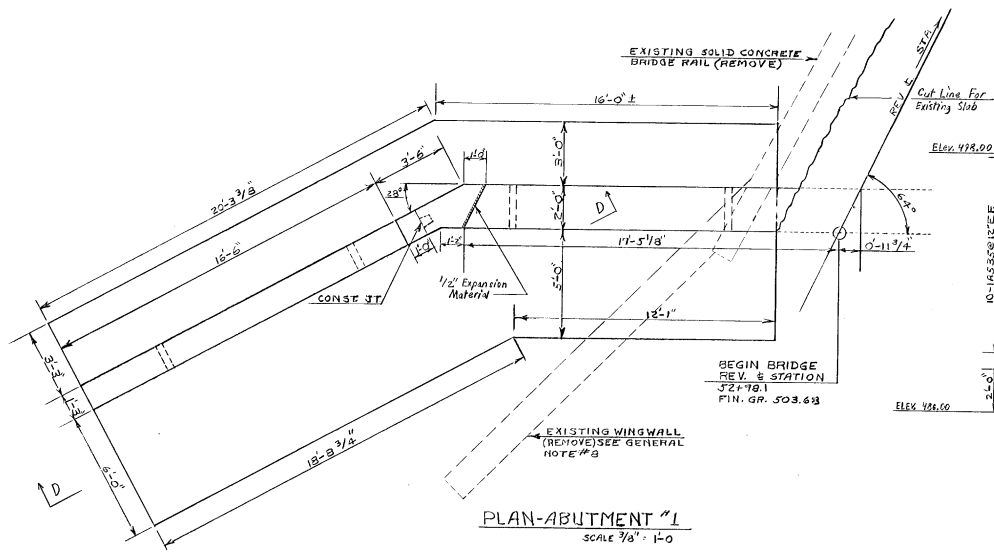

STATE OF VERMONT DEPARTMENT OF HIGHWAYS			
TOWN OF	PLAINFIELD	Bridge No.	12
HIGHWAY NO.	TH. 2 - CL 2	Log Sta.	53+08.7
		Surv. Sta.	
TH. #2 OVER GREAT BROOK ABUTMENT #1 DETAILS			
Designed by	D. PERKINS	Drawn by	D. PERKINS
Checked by	D. Landry	Bridge Design Supervisor	F. BOKLUM
		date	7-76
		date	8/16
PROJECT	PLAINFIELD	PROJECT NO.	SRS 2302(2)
Bridge Sheet No.	4	Sheet	28 of 30

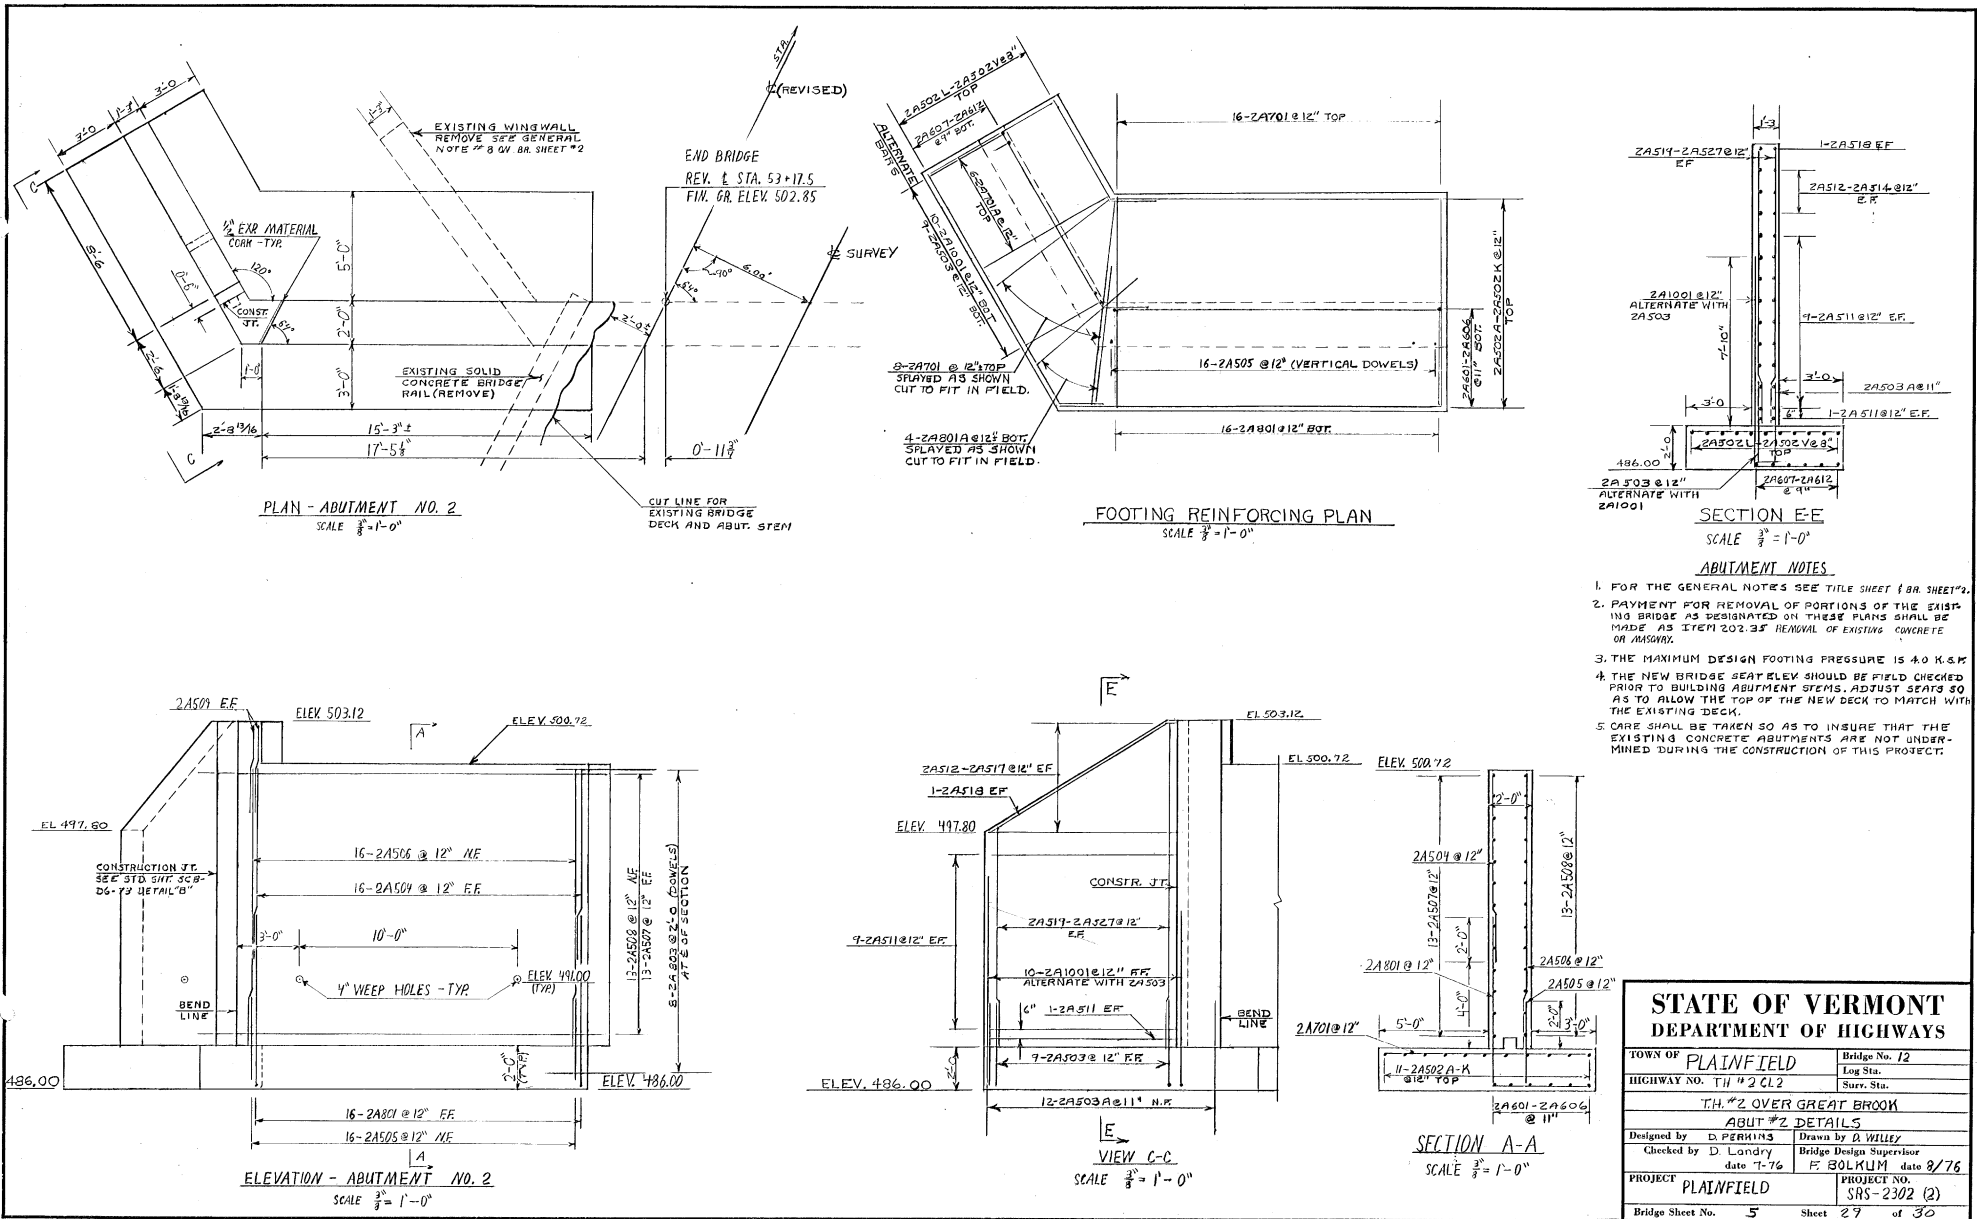

**STATE OF VERMONT
DEPARTMENT OF HIGHWAYS**


TOWN OF PLAINFIELD	Bridge No. 12
HIGHWAY NO. TH #2 CL2	Log Sta. Surr. Sta.
TH #2 OVER GREAT BROOK	
ABUT #2 DETAILS	
Designed by D PERKINS	Drawn by B WILLEY
Checked by D Landry	Bridge Design Supervisor
date 7-76	date 7-76
PROJECT PLAINFIELD	PROJECT NO. SRS-2302 (2)
Bridge Sheet No. 5	Sheet 29 of 30

ABUTMENT 1

Station	Dist	Area	Vol	Area	Vol
91544	0	0	0	115	0
91554	10	23	3784	23	308.8
91603	49	110	14900	101	14900
91732	129	91	14900	130	15900
91772	140	65	310.0	96	860.9
91860	8.8	147	2005	100	1590
9189	3.0	20	10	0	0
9190	1.0	0	0	0	0

ABUTMENT 2

Station	Dist	Area	Vol	Area	Vol
91735	1.5	20	15	19	14.3
91783	5.7	97	325	77	332.0
91801	12.9	123	70.0	107	82.8
91823	2.9	63	50.0	85	57.5
9190	7.0	76	70.0	80	57.0
91924	6.4	149	175.0	80	64.0

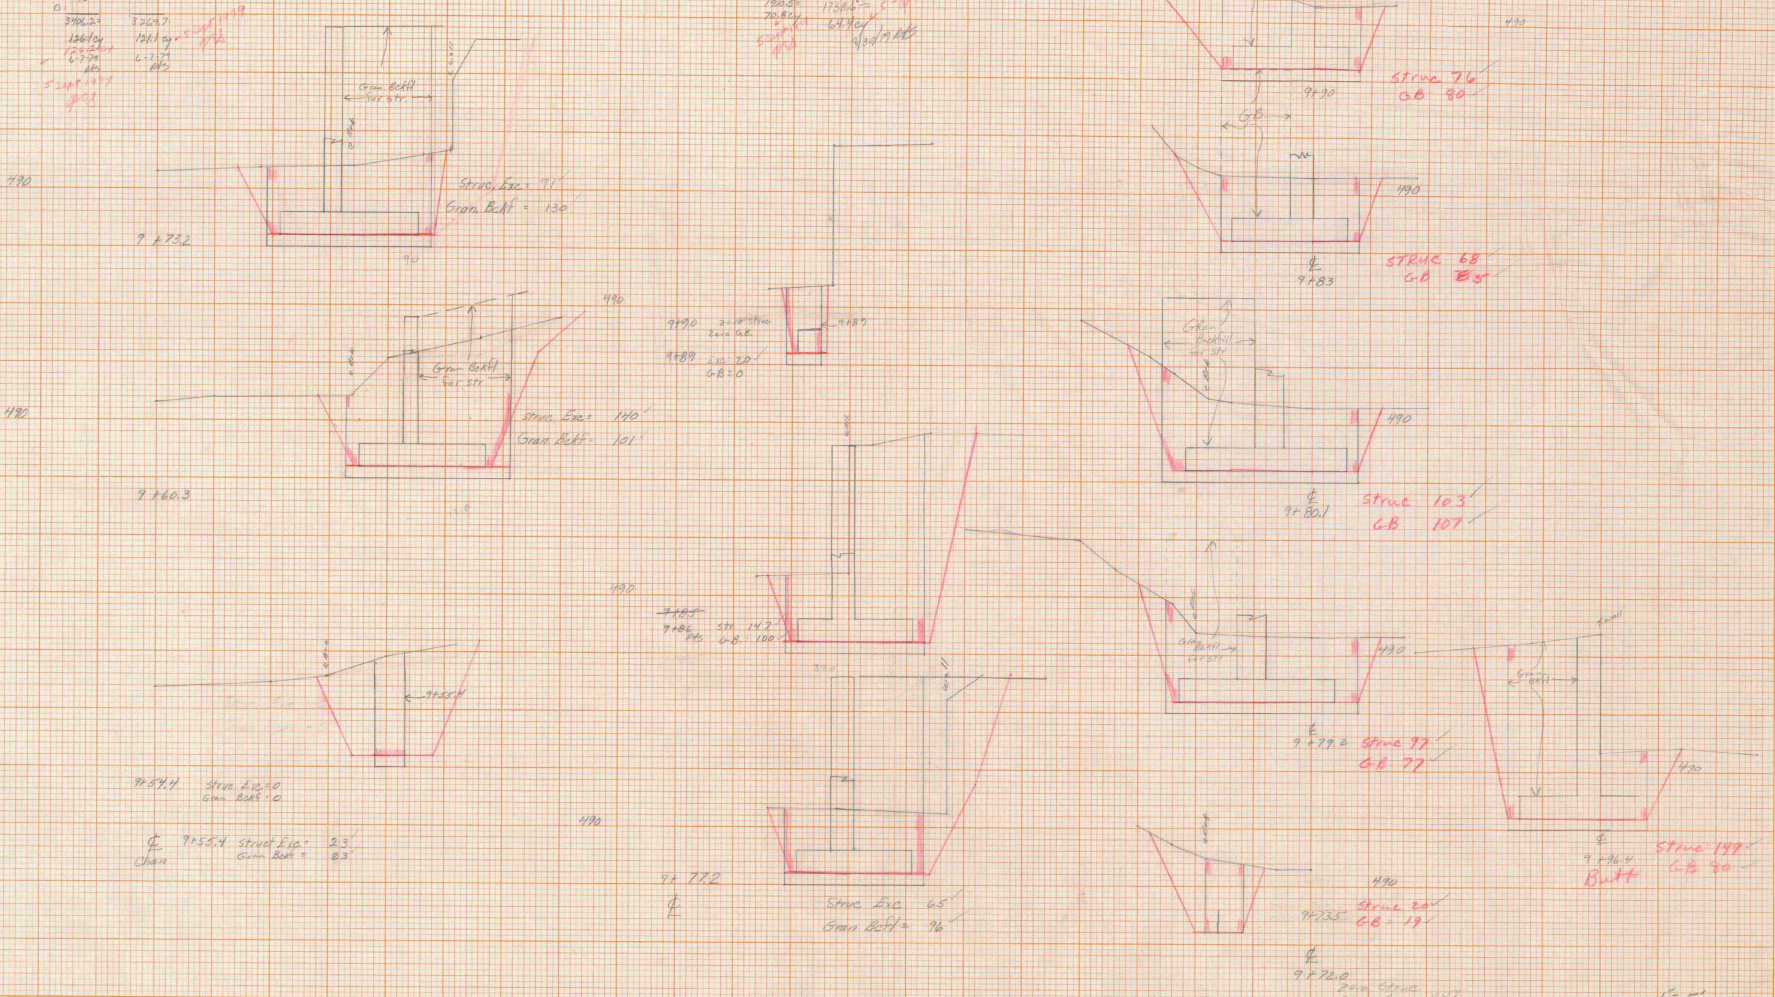


1" = 5'
 4/16/79
 4/16/79
 4/16/79

PLAINFIELD SAS 23020




DATE	BY
APPROVED	DESIGNED
CHECKED	PLANNED
DATE	BY

DATE	BY
APPROVED	DESIGNED
CHECKED	PLANNED
DATE	BY

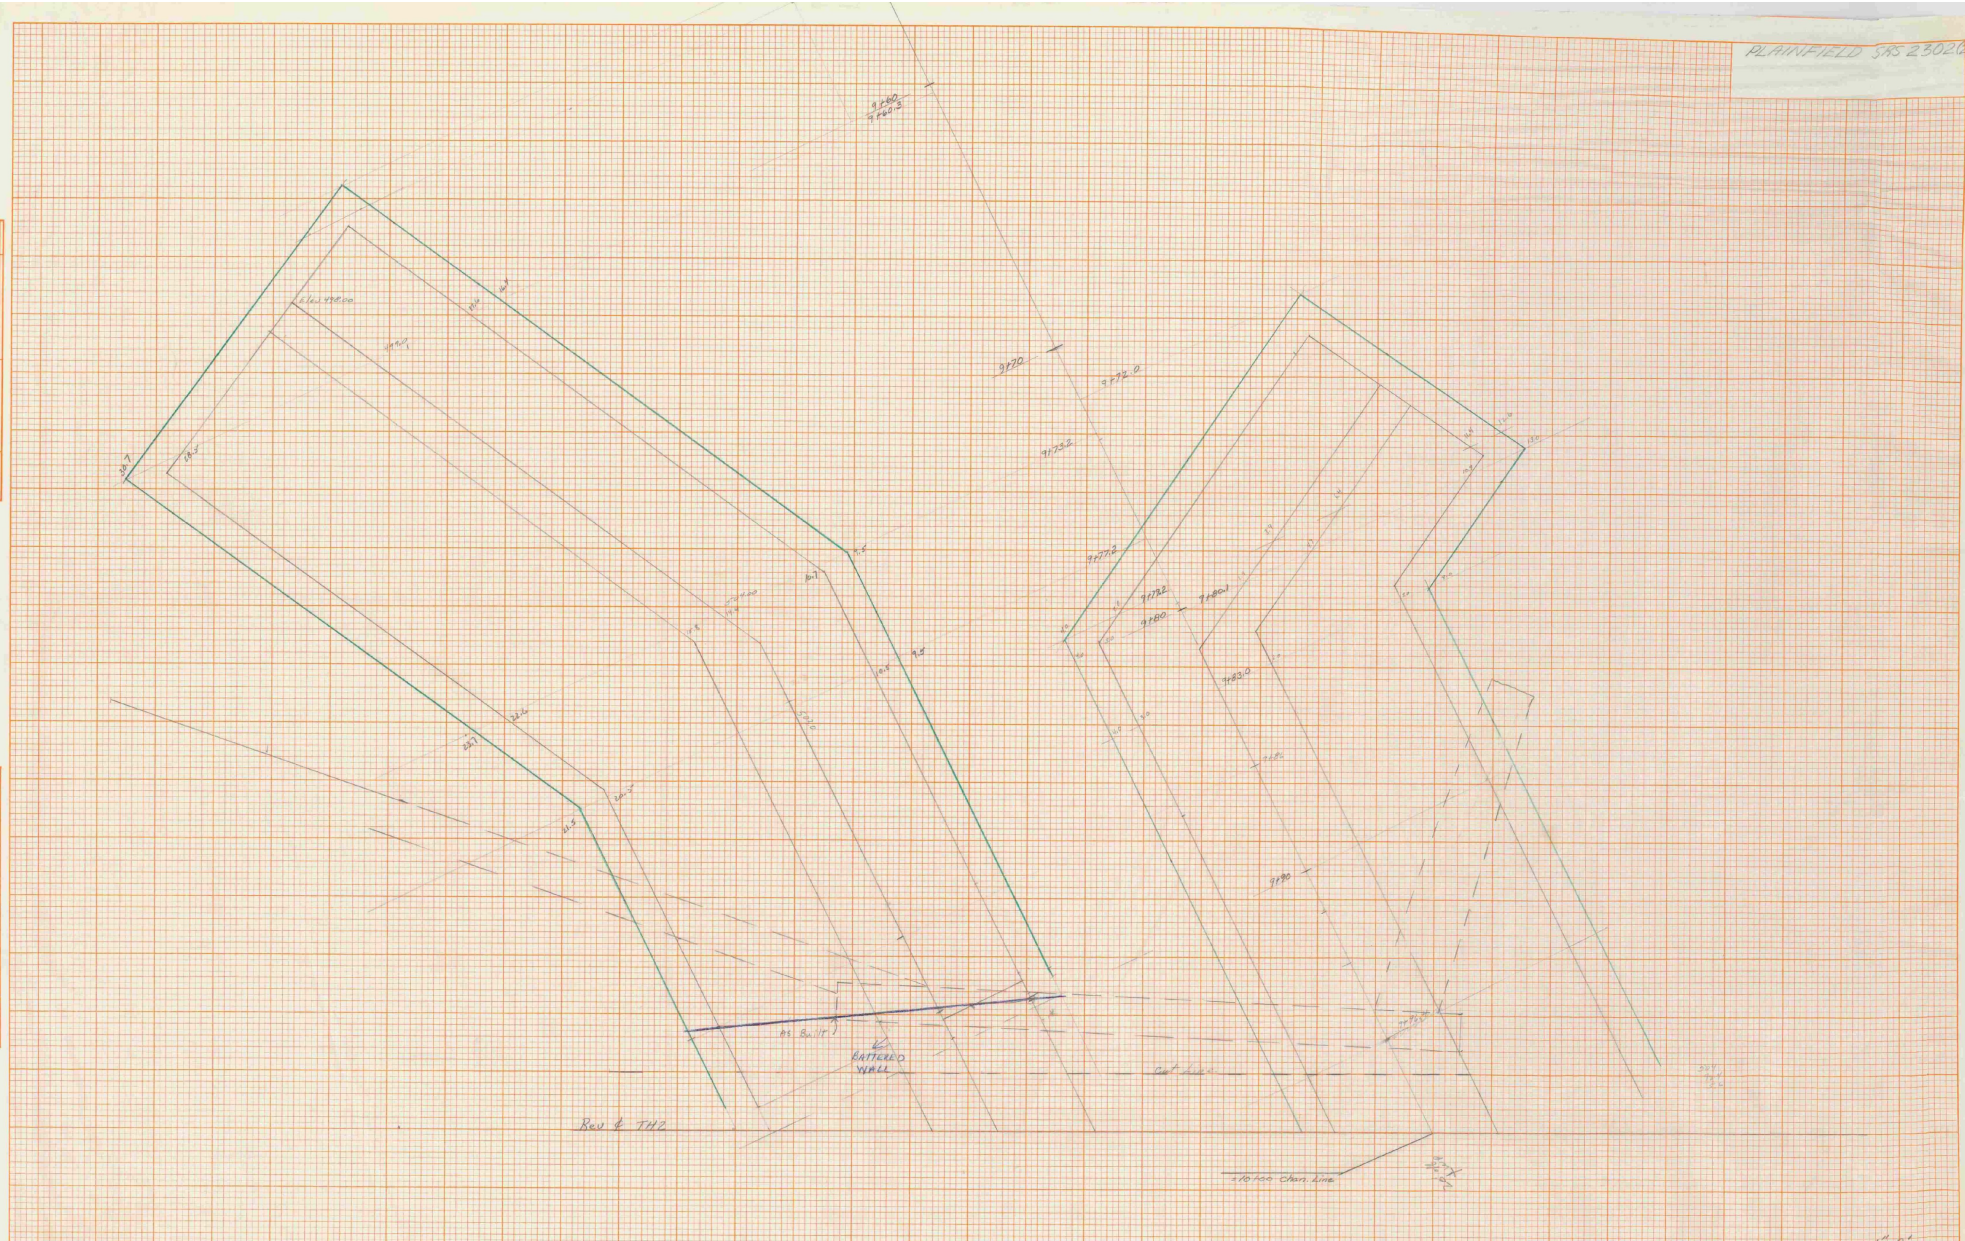

DATE	
BY	
REVISIONS	
NO.	
DATE	
BY	
REVISIONS	
NO.	
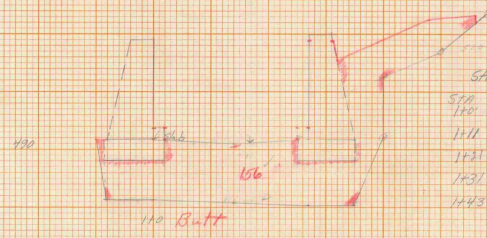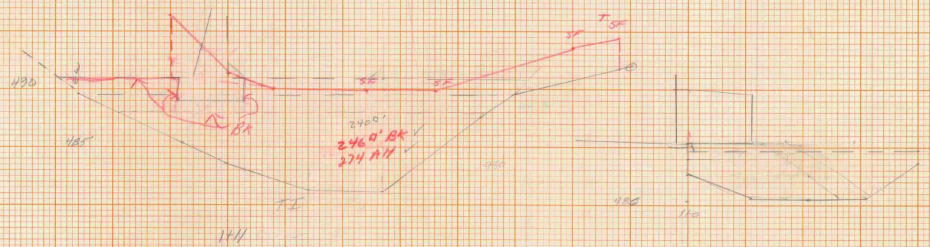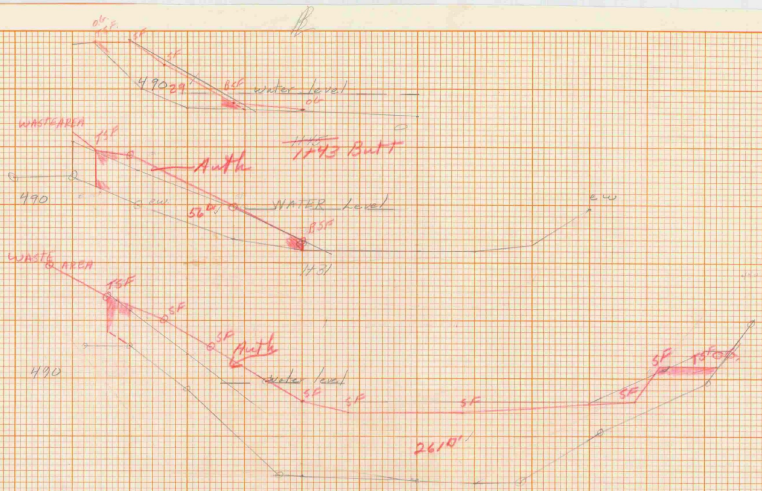

Sta	Dist	Area	Vol
120	11	150.0000	2511
111	10	350.0000	2600
101	10	360	1000
1431	13	570	570
1443	13	2710.0000	2710.0000

orig. plot 4/20/79 RKS
 Print 1/6/80 4/20/79 RKS
 Plan 1/71-1977 RKS

Revised 11/5/85 G.33389
 changed sections
 1/6/80
 1/6/80

QUANTITIES

APPROXIMATE SUMMARY OF QUANTITIES

EROSION CONTROL	TEMP. BRIDGE AT RR MM 4.90	CULVERT AT RR MM 6.49	TRANSPORTATION PATH	QUANTITIES GRAND TOTAL	UNITS	ITEMS	ITEM NO.	ROUNDING
				1	LUMP SUM	CLEARING AND GRUBBING (MODIFIED)	201.10	
				25	EACH	REMOVING SMALL TREES (MODIFIED)	201.15	EST.
				3	EACH	REMOVING LARGE TREES (MODIFIED)	201.16	EST.
				1	ACRES	THINNING AND TRIMMING	201.30	
				6,500	CUBIC YARD	AGGREGATE SURFACE COURSE (MODIFIED)	401.10	
				11	CUBIC YARD	CONCRETE, CLASS B	501.25	
	1			1	LUMP SUM	TEMPORARY FOOT BRIDGE (MOD.)	528.12	
				60	LINEAR FOOT	18" PCCSP (MODIFIED)	601.0416	
				100	HOURL	POWER GRADER RENTAL	608.15	
15				15	CUBIC YARD	STONE FILL, TYPE II	613.11	EST.
				44,000	LINEAR FOOT	WOVEN WIRE FENCE WITH STEEL POSTS (MODIFIED)	620.25	
				13	EACH	DRIVE GATE FOR WOVEN WIRE FENCE (MODIFIED)	620.30	
				85	EACH	STEEL BRACE FOR WOVEN WIRE FENCE	620.40	
				7,500	LINEAR FOOT	REMOVAL OF EXISTING FENCE	620.55	
				66	EACH	GUIDE POSTS (VEHICLE BARRIER POSTS) (MODIFIED)	621.85	
				24	HOURL	UNIFORM TRAFFIC OFFICERS	630.10	
				120	HOURL	FLAGGERS	630.15	
	1			1	LUMP SUM	TESTING EQUIPMENT - CONCRETE	631.16	
				1	LUMP SUM	MOBILIZATION	635.10	
100				100	SQUARE YARD	GEOTEXTILE FABRIC FOR SILT FENCE	649.20	
100				100	POUNDS	SEED	651.15	EST.
750				750	POUNDS	FERTILIZER	651.18	EST.
1				1	TONS	AGRICULTURE LIMESTONE	651.20	EST.
1				1	TONS	HAY MULCH	651.25	EST.
100				100	EACH	HAY BALES FOR EROSION CONTROL	651.26	EST.
				560	SQUARE FEET	TRAFFIC SIGNS, TYPE A	675.20	
				3850	POUNDS	FLANGED CHANNEL SIGN POSTS	675.30	40
				12	EACH	REMOVING SIGNS	675.50	
				12	EACH	ERECTING SALVAGED SIGNS	675.60	
				6	EACH	SETTING SALVAGED POSTS	675.61	
				10	TON	COLLECTION & DISPOSAL OF BULKY METALLIC WASTE (MOD.)	681.10	

REVISED 9/18/95 PLD

PROJECT NAME: ST. ALBANS-SHELDON
TRANSPORTATION PATH
PROJECT NUMBER: STP BIVE (18) S

DRAWN BY: MJD
DESIGN FILE: EX187.DGN

IPARM NAME:
PLOT DATE: 6/28/95
SHEET 4 OF 21

INDEX OF SHEETS

1. Title, Typical Index
2. Quantity
3. Plan & Profile
4. Blank
- Standard Sheets
5. A-4 Solid Rock Excavation 4-20-73 (R)
6. E-2 Road Construction Approach Signs 5-14-74 (R)
7. E-3 Bridge Construction Approach Signs 7-20-76 (R)
8. E-4 On-Project Construction Signs 5-14-74 (R)
9. E-4 Guard Rail, Standard Steel Beam
10. E-4 Guard Rail, Standard Steel Beam
11. SCR-DI-75 Details of W. Beam Bridges 12-15-76 (R)
12. SCR-DI-75 Details of W. Beam Bridges 12-15-76 (R)
13. SA-76-% Bridge Rail Mountings 1-8-76
- 14-15. Blank
- 16-21. Crest Sections
22. Details, Earthworks, Bridge Quantities
- 23-26. Bridge Sheets

GENERAL NOTES:

1. THE GENERAL NOTE PERTAINING TO SPECIFICATIONS, MATERIALS AND CONSTRUCTION IS SHOWN ON SHEETS SCR-DI-75, MODIFIED FOR AN H2O LIVE LOADING AND INCLUDING AN ALLOWANCE FOR 8" OF GRAVEL AND 2" OF FUTURE PAVEMENT OVER THE DECK SURFACE. OTHER NOTES SHOWN ON THE STANDARD THAT ARE NOT DIMENSIONED, DRAWN OR MODIFIED ARE NONE.
2. ALL MATERIALS AND CONSTRUCTION SHALL CONFORM TO STATE OF VERMONT, DEPARTMENT OF HIGHWAYS, STANDARD SPECIFICATIONS FOR HIGHWAY AND BRIDGE CONSTRUCTION, DATED MARCH 1976 AND ITS LATEST REVISIONS AND THE APPROPRIATE STANDARD SPECS FOR HWY. BRIDGES DATED 1973 AND ITS LATEST REVISIONS.

STATE OF VERMONT
DEPARTMENT OF HIGHWAYS



PROPOSED IMPROVEMENT
BRIDGE PROJECT

TOWN OF PLAINFIELD
COUNTY OF WASHINGTON

ROUTE NO: TH.2, CL. II BRIDGE NO: 12

PROJECT LOCATION: BEGINNING AT A POINT 3.34 MILES NORTHERLY OF THE PLAINFIELD/ORANGE TOWN LINE, AND EXTENDING NORTHERLY 0.233 MILES.

PROJECT DESCRIPTION: Consists of widening the existing Bridge with a R.C. Slab Bridge addition on the upstream side. Also related roadway and channel work.


LENGTH OF STRUCTURE: 19.4 FEET
LENGTH OF PARTICIPATION ROADWAY: 180.6 FEET
LENGTH OF PROJECT: 200 FEET
LENGTH OF R.O.W. PROJECT: 700 FEET

R.O.W. PLANS

BEGIN R.O.W. PROJ. SRS 2302(2)
STA. 48+50 C

END R.O.W. PROJ. SRS 2302(2)
STA. 55+50 C

- CONVENTIONAL SIGNS
- COUNTY LINE
 - TOWN LINE
 - LIMITS OF ACCESS
 - POINT OF ACCESS
 - FENCE LINE
 - STONE WALL
 - TRAVELED WAY
 - GUARD RAIL
 - RAILROAD
 - SURVEY LINE
 - CULVERT
 - POWER POLE
 - TELEPHONE POLE
 - TREES
 - F.A. CONST. IDENTIFICATION SIGNS
 - PROPERTY LINE
 - R.O.W. TAKING LINE
 - SLOPE RIGHTS
 - TOP OF CUT
 - TOE OF SLOPE

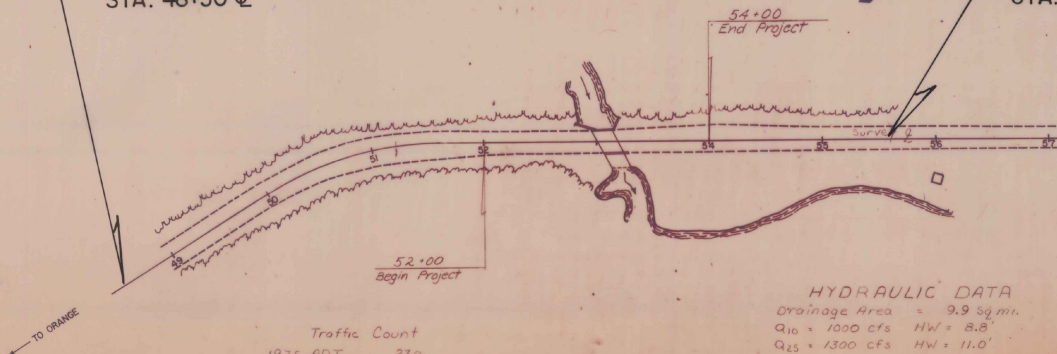




Traffic Count

1975 ADT	230
1975 DHV	50
D	53
T	6
1985 ADT	295
1985 DHV	65
Design Speed	25 M.P.H.
5 Year Accidents	- 4

HYDRAULIC DATA

Drainage Area = 9.9 Sq. mi.

Q ₁₀	= 1000 cfs	HW = 8.8'
Q ₂₅	= 1300 cfs	HW = 11.0'
Q ₅₀	= 1600 cfs	HW = 11.7'
Q ₁₀₀	= 1900 cfs	HW = 12.1'
OHW	= 35 cfs	depth of flow = 1.5'
OLW	= 10 cfs	depth of flow = 1.0'

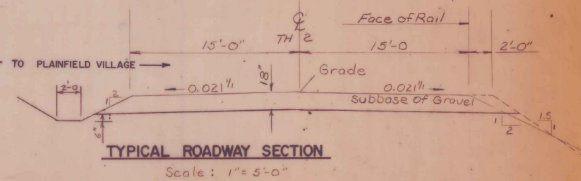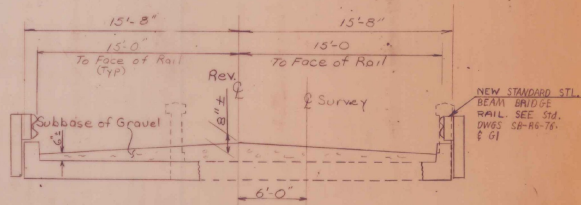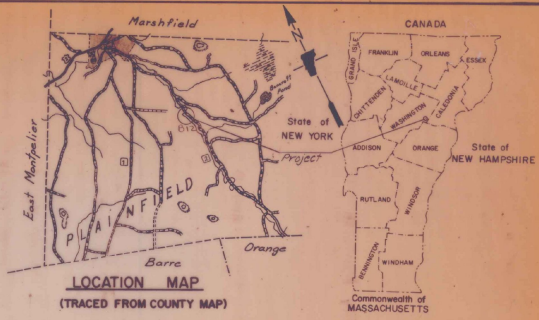

These plans are subject to such engineering changes as may be required by the Federal Highway Administration or the Chief Engineer.

Construction is to be carried on in accordance with these plans and the Standard Specifications for Highway and Bridge Construction dated March, 1976, as approved by the Federal Highway Administration on a project to project basis including all subsequent revisions and such revised specification and special provisions as are incorporated in these plans.

APPROVED *W.R. [Signature]*
RIGHT OF WAY DIRECTOR
DATE 3-21-77

SUBMITTED BY ORDER OF THE STATE HIGHWAY BOARD

APPROVED *R.O. Munn* DATE 2-18-77
Acting CHIEF ENGINEER

DEPARTMENT OF TRANSPORTATION
FEDERAL HIGHWAY ADMINISTRATION

APPROVED _____ DATE _____
DIVISION ENGINEER

PROJECT SRS No 2302 (2)
SHEET 1 OF 3 SHEETS

SRS 92/17/70

STATE OF VERMONT
DEPARTMENT OF HIGHWAYS
RIGHT-OF-WAY PLANS
DETAIL SHEET

TABLE OF PROJECT PROPERTY ACQUISITION

PARCEL NO.	GRANTOR	SHEET NO.	BEGINNING STATION	ENDING STATION	TAKING	REM.	RIGHTS	TITLE TAKEN	DATE	TOWN OR CITY RECORDED	BK.	PG.	REMARKS
1	SAMAN, PETER S	3	50+73 LT.	55+50 LT.	0.06 A ±	20294A ±		OPTION	9/15/78	PLAINFIELD	3	296-7	2450 S.F. ±
			51+70 LT.	53+25 LT.			SLOPE (P) (700 S.F. ±)						
			53+05 LT.	53+15 LT.			CHANNEL (P) (253 S.F. ±)						
2	TOWN OF PLAINFIELD - LESSOR GRIGGS, ALBERT O. & ONDREE S. - LESSEES	3	51+85 RT.	52+75 RT.			SLOPE (P) (400 S.F. ±)	WDOE	7/10/78	PLAINFIELD	24	426-427	
			53+07 RT.	53+32 RT.			CHANNEL (P) (125 S.F. ±)						
3	DELETED												FORMERLY: LUND, WEBSTER S. & GLADYS I.

TABLE OF REVISIONS

REVISION NO.	SHEET NO.	DESCRIPTION OF REVISION	DATE	MADE BY	APPROVED BY
1	3	Parcel #1. Saman added Construct Drive 54+00 Lt. to Layout Sheet Per C.O. # 3353.	4/26/77	A.G.S.	WEB
2	2	Parcel #1 Saman Revised Slope Right Area from 7253 S.F. to 700 S.F. Per C.O. # 3375	5-19-77	AD	T.P.M.
3	3	PARCELS 2 & 3 - GRIGGS & LUND. CHANGED PL & DELETED PARCEL # 3. ADDED CHANNEL RIGHT AREA TO PARCEL # 2. PER C.O. # 3385	5-25-77	NBB	T.P.M.
4	2 & 3	Parcel #1. Saman. Delete Town of Plainfield-Lessor. Per C.O. # 3670	1-27-78	A.G.S.	T.P.M.

LEGEND


MADE BY: A.G.S.	DATE: 3/21/77	DR. RT - DRAINAGE RIGHT	----- PRESENT R.O.W.	SR - SLOPE RIGHTS
CHECKED BY: W.E.B.	DATE: 3/21/77	DT. RT - DITCHING RIGHT	/// - - - - - TAKING WITHOUT ACCESS	P - PROPERTY LINE
		CH. RT - CHANNEL RIGHT	/// P - - - - - TAKING WITHOUT ACCESS ALONG PROPERTY LINES	L - TOP OF CUT
		DRIVE RT - DRIVE RIGHT	--- (P) --- TAKING WITH ACCESS	△ - PERMANENT EASEMENT
		CUL. RT - CULVERT RIGHT	--- (T) --- TEMPORARY EASEMENT	○ - TOE OF SLOPE
		DEMOLITION OR REMOVAL		
		W - WATER SOURCES		

APPROVED: *Theresa P. May* DATE: 3-21-77
CHIEF OF PLANS & TITLES

PROJECT: PLAINFIELD
NO. SRS 2302 (2)
SHEET 2 OF 3

PLAN
 DATE: _____
 BY: _____
 CHECKED: _____
 IN CHARGE: _____
 NO. _____

PROFILE
 DATE: _____
 BY: _____
 CHECKED: _____
 IN CHARGE: _____
 NO. _____

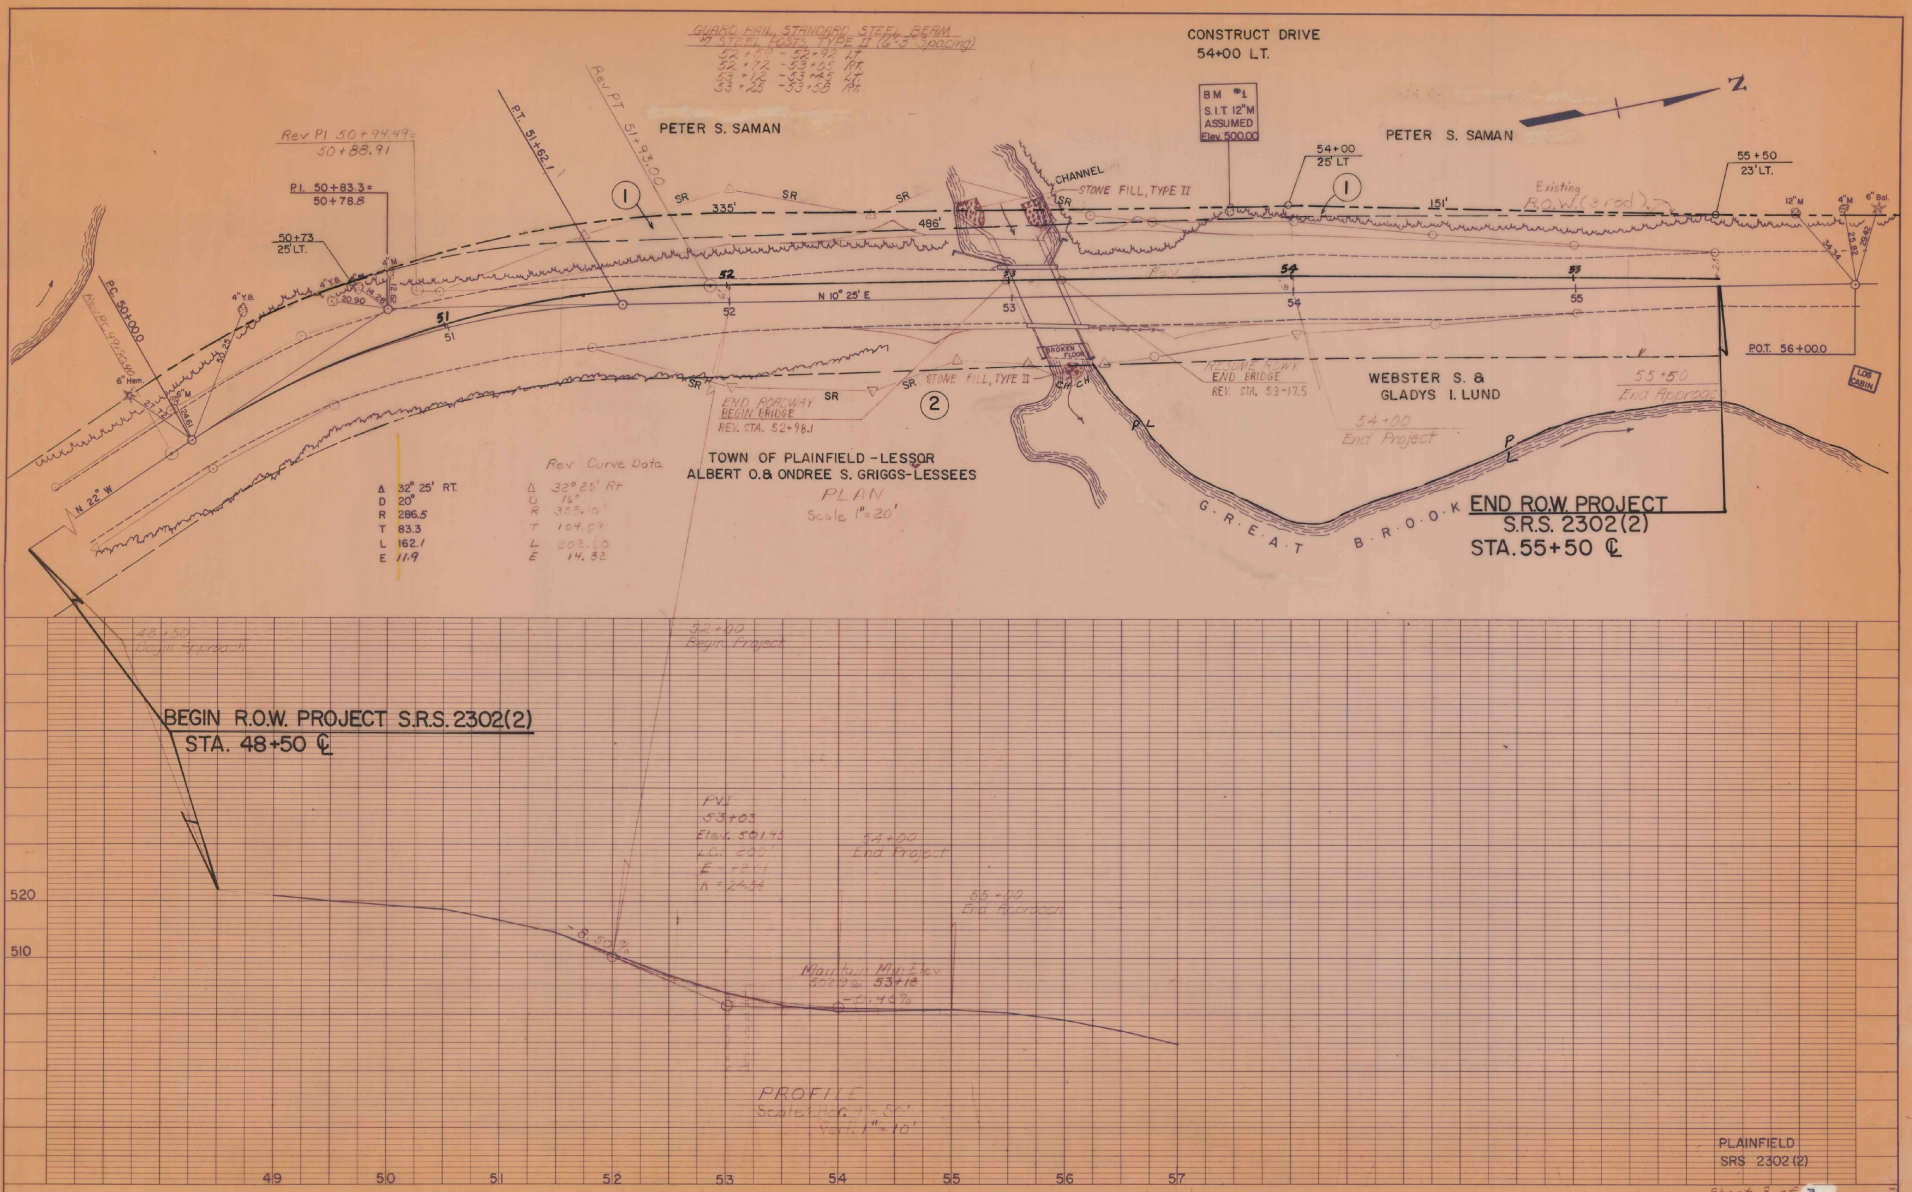

Vermont Agency of
Transportation
PHASE 2-INTERSTATE
#122302-01



INITIALS

Box 3317

DONE

Bridge
1979

Plainfield
S.R.S. 2302 (2)

1979

1977 ROW

PLAINFIELD

SRS 2302 (2)

1977