



PLAN  
 NOTE BOOK  
 NO. 1-83  
 1-83  
 1-83

PROFILE  
 NOTE BOOK  
 NO. 1-83  
 1-83  
 1-83

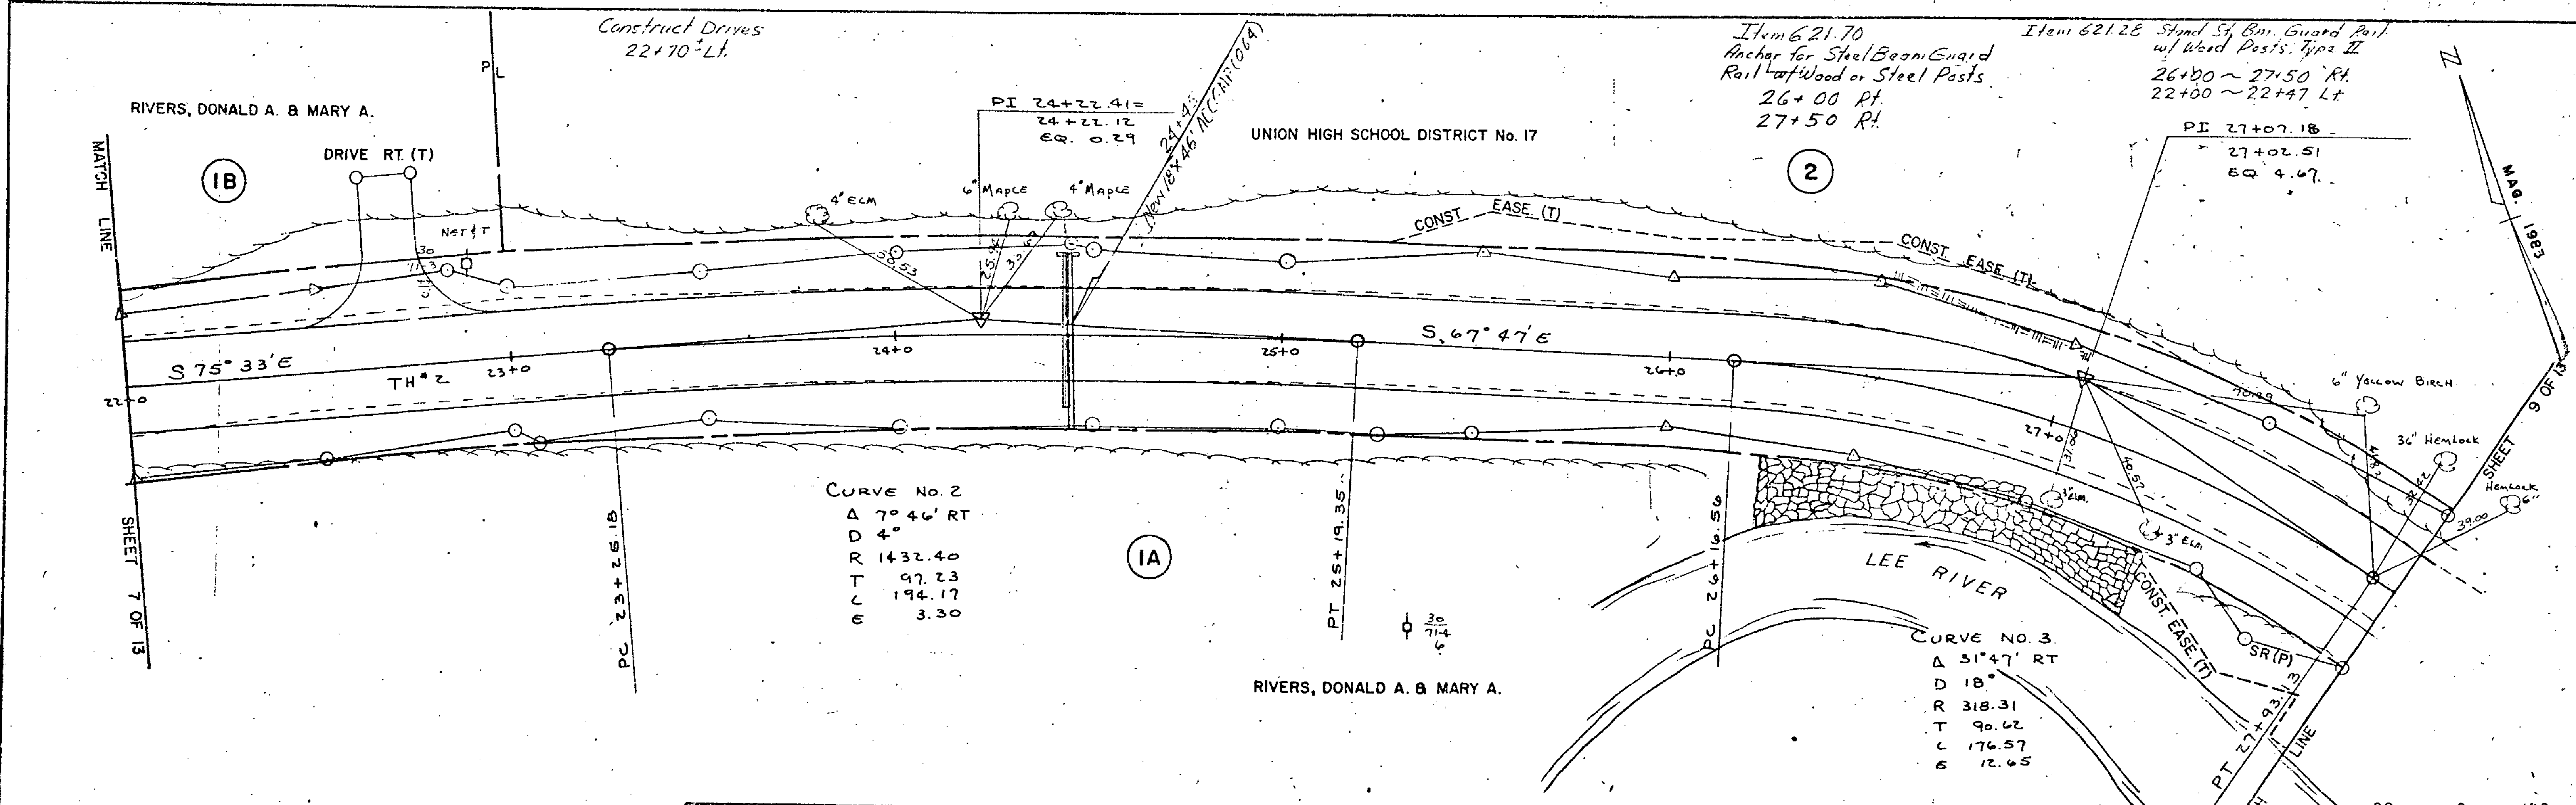

THIS SHEET TO BE USED  
 FOR ROW INFORMATION ONLY

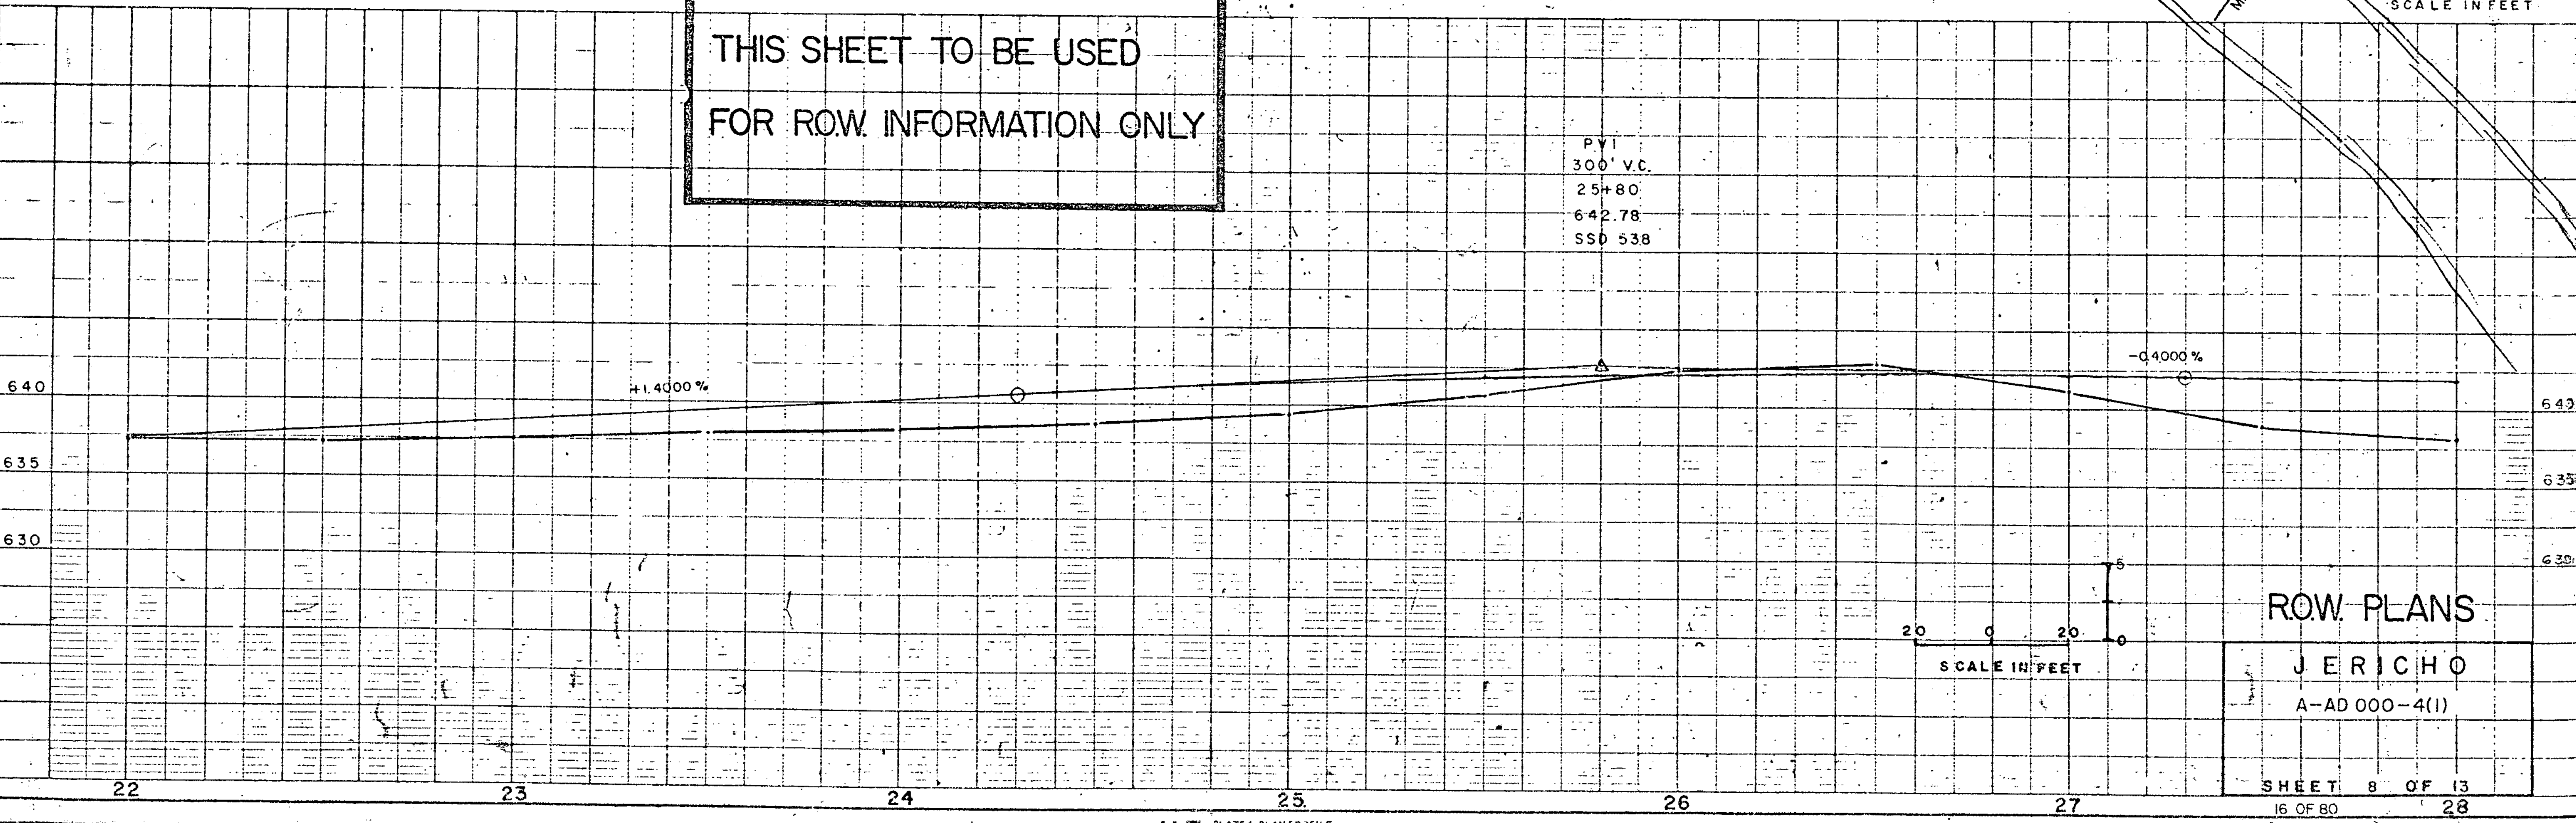

ROW PLANS  
 JERICHO  
 A-AD 000-4(1)

SHEET 8 OF 13  
 16 OF 80 28