
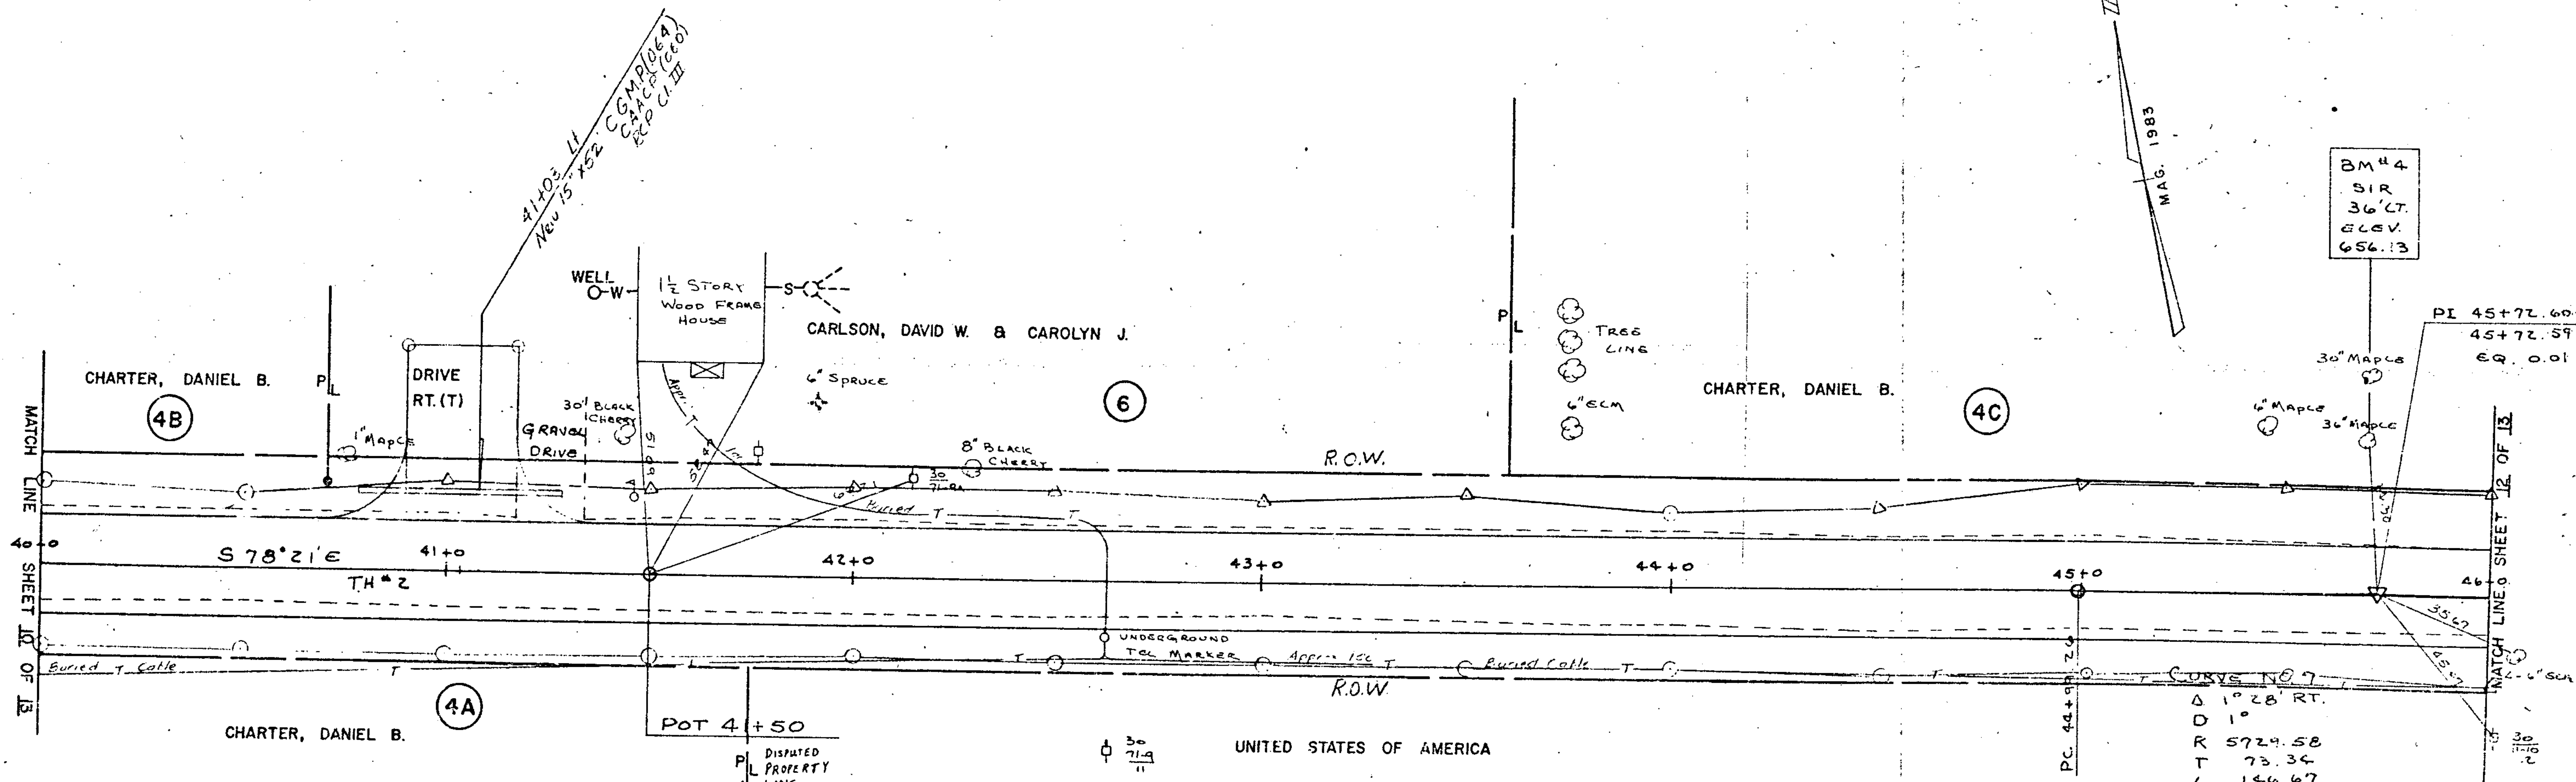


PLAN
 SURVEYED BY
 L. S. C. S.
 DATE
 1-83
 NOTE BOOK
 NO. 1000
 11. OF 111 SHEETS

PROFILE
 SURVEYED BY
 ERNEST
 DATE
 1-83
 NOTE BOOK
 NO. 1000
 11. OF 111 SHEETS

Construct Drive
 41+08 Lt.

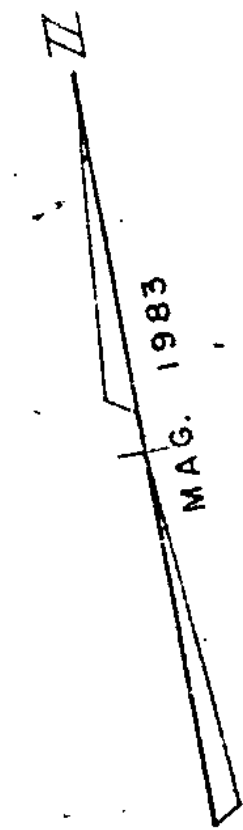


CURVE NO. 7
 Δ 1° 28' RT.
 D 1°
 R 5724.58
 T 73.34
 L 146.67
 S 0.47

20 0 20
 SCALE IN FEET

THIS SHEET TO BE USED
 FOR ROW INFORMATION ONLY

PVI
 40+00
 300' V.C.
 649.25
 SSU = 6.13

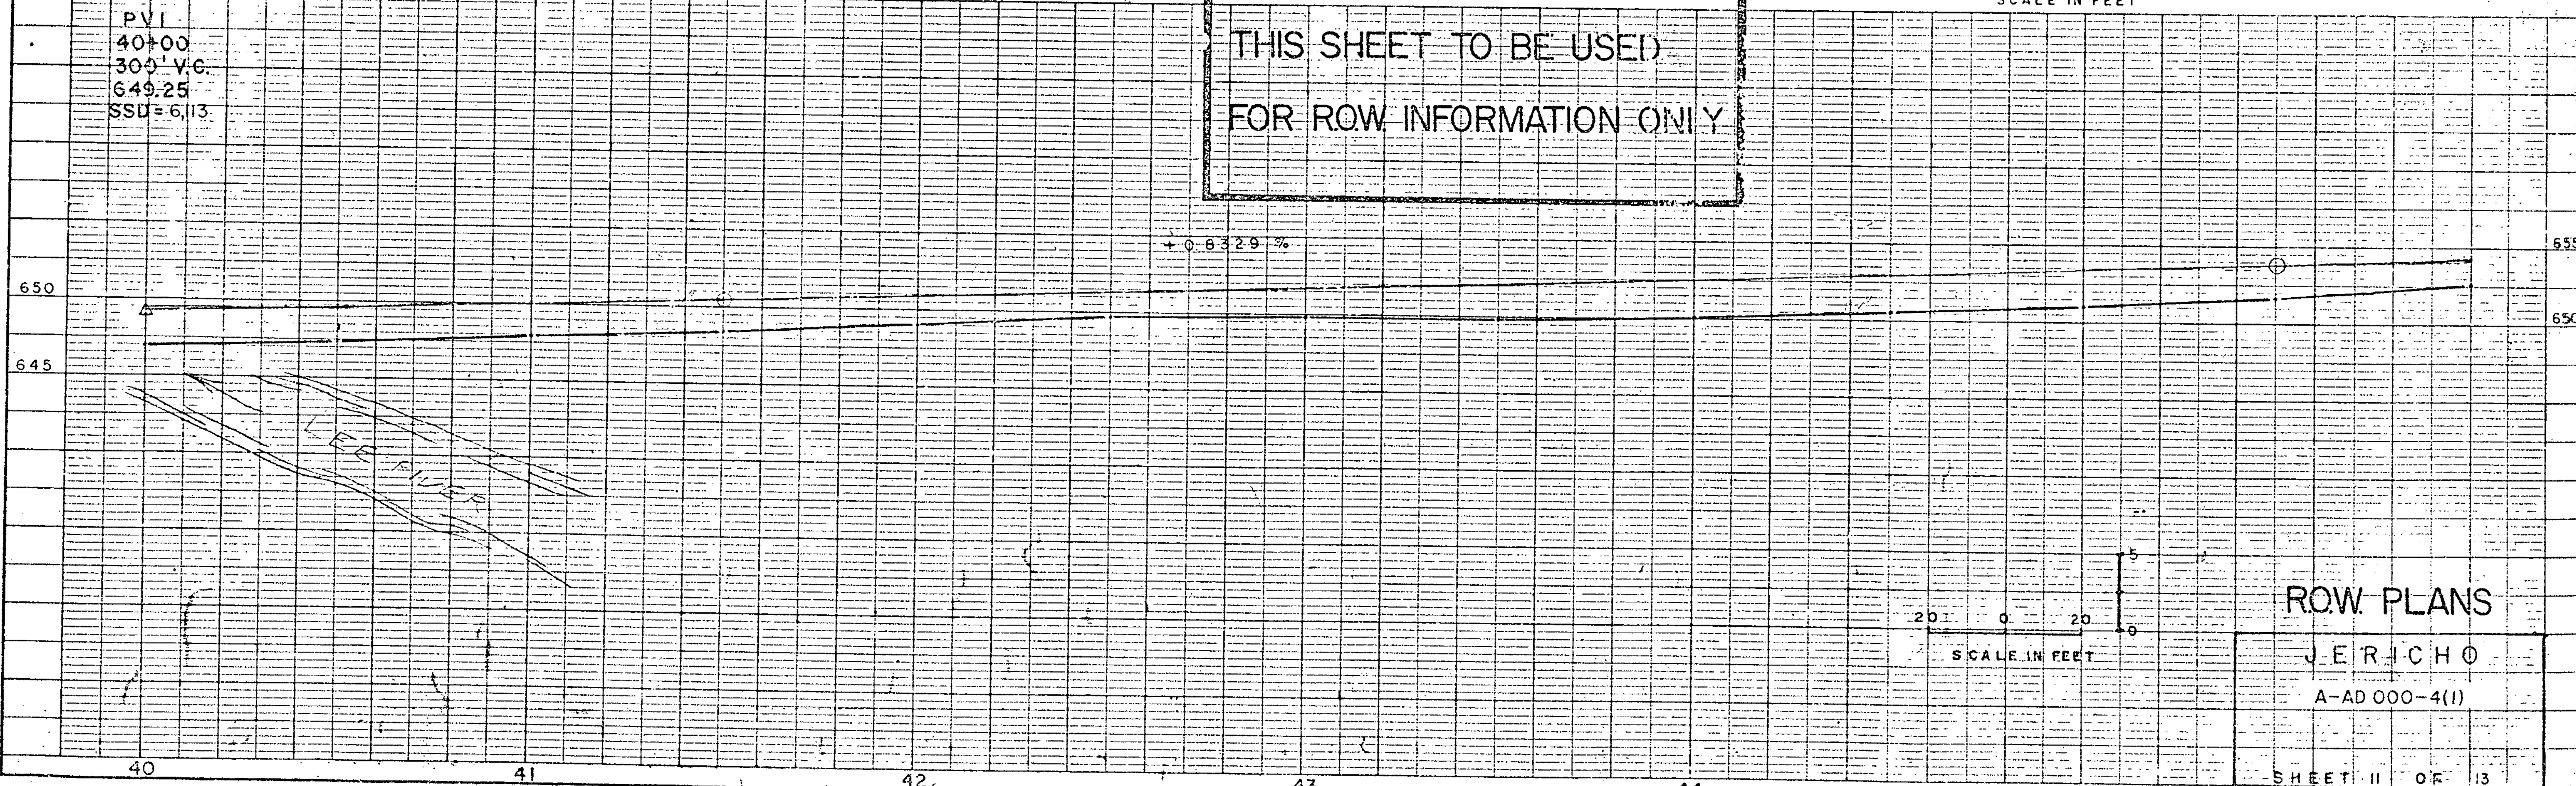

20 0 20
 SCALE IN FEET

ROW PLANS

JERICHO

A-AD 000-4(1)