


PLAN  
 DATE: \_\_\_\_\_  
 DRAWN BY: \_\_\_\_\_  
 CHECKED BY: \_\_\_\_\_  
 NO. OF SHEETS: \_\_\_\_\_

DATUM  
 VERTICAL: NGVD 1929  
 HORIZONTAL: N/A

PROFILE  
 DATE: \_\_\_\_\_  
 DRAWN BY: \_\_\_\_\_  
 CHECKED BY: \_\_\_\_\_  
 NO. OF SHEETS: \_\_\_\_\_

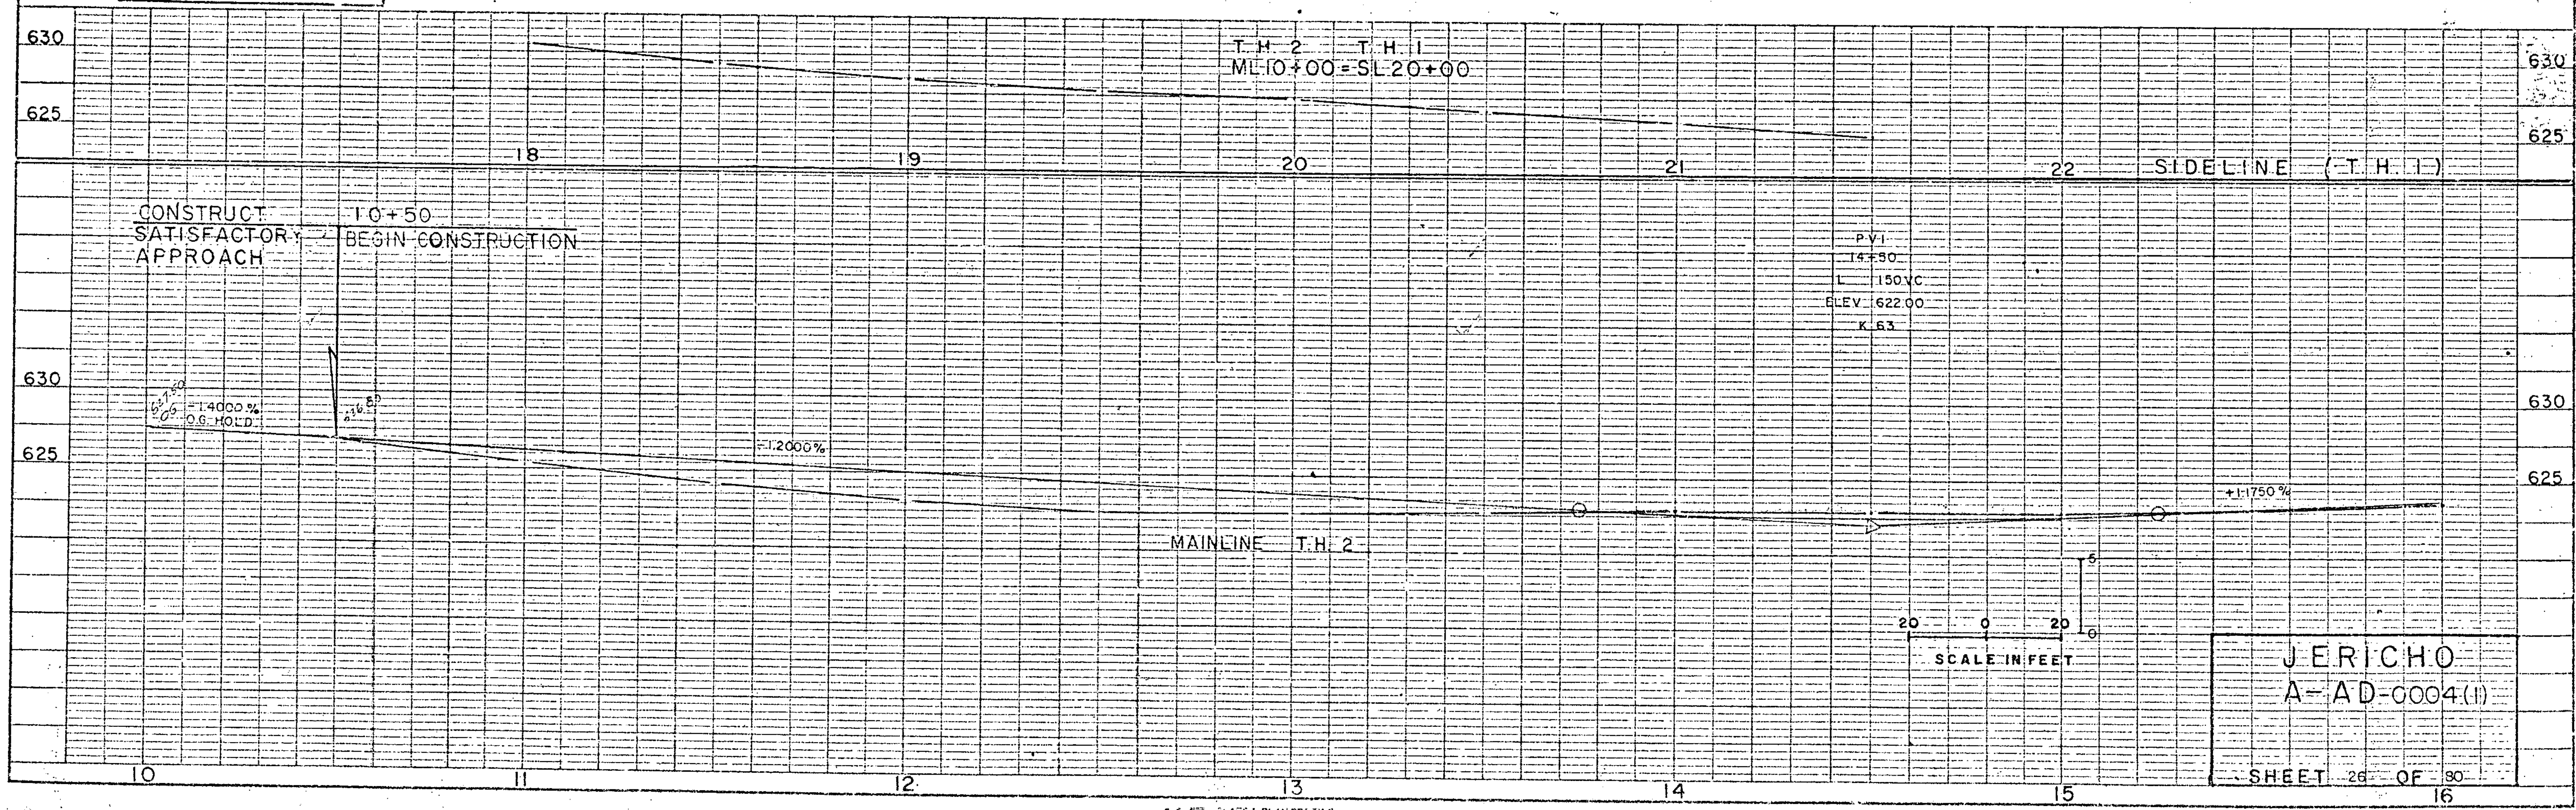

SCALE IN FEET  
 20 0 20

JERICHO  
 A-AD-0004(1)  
 SHEET 26 OF 30