
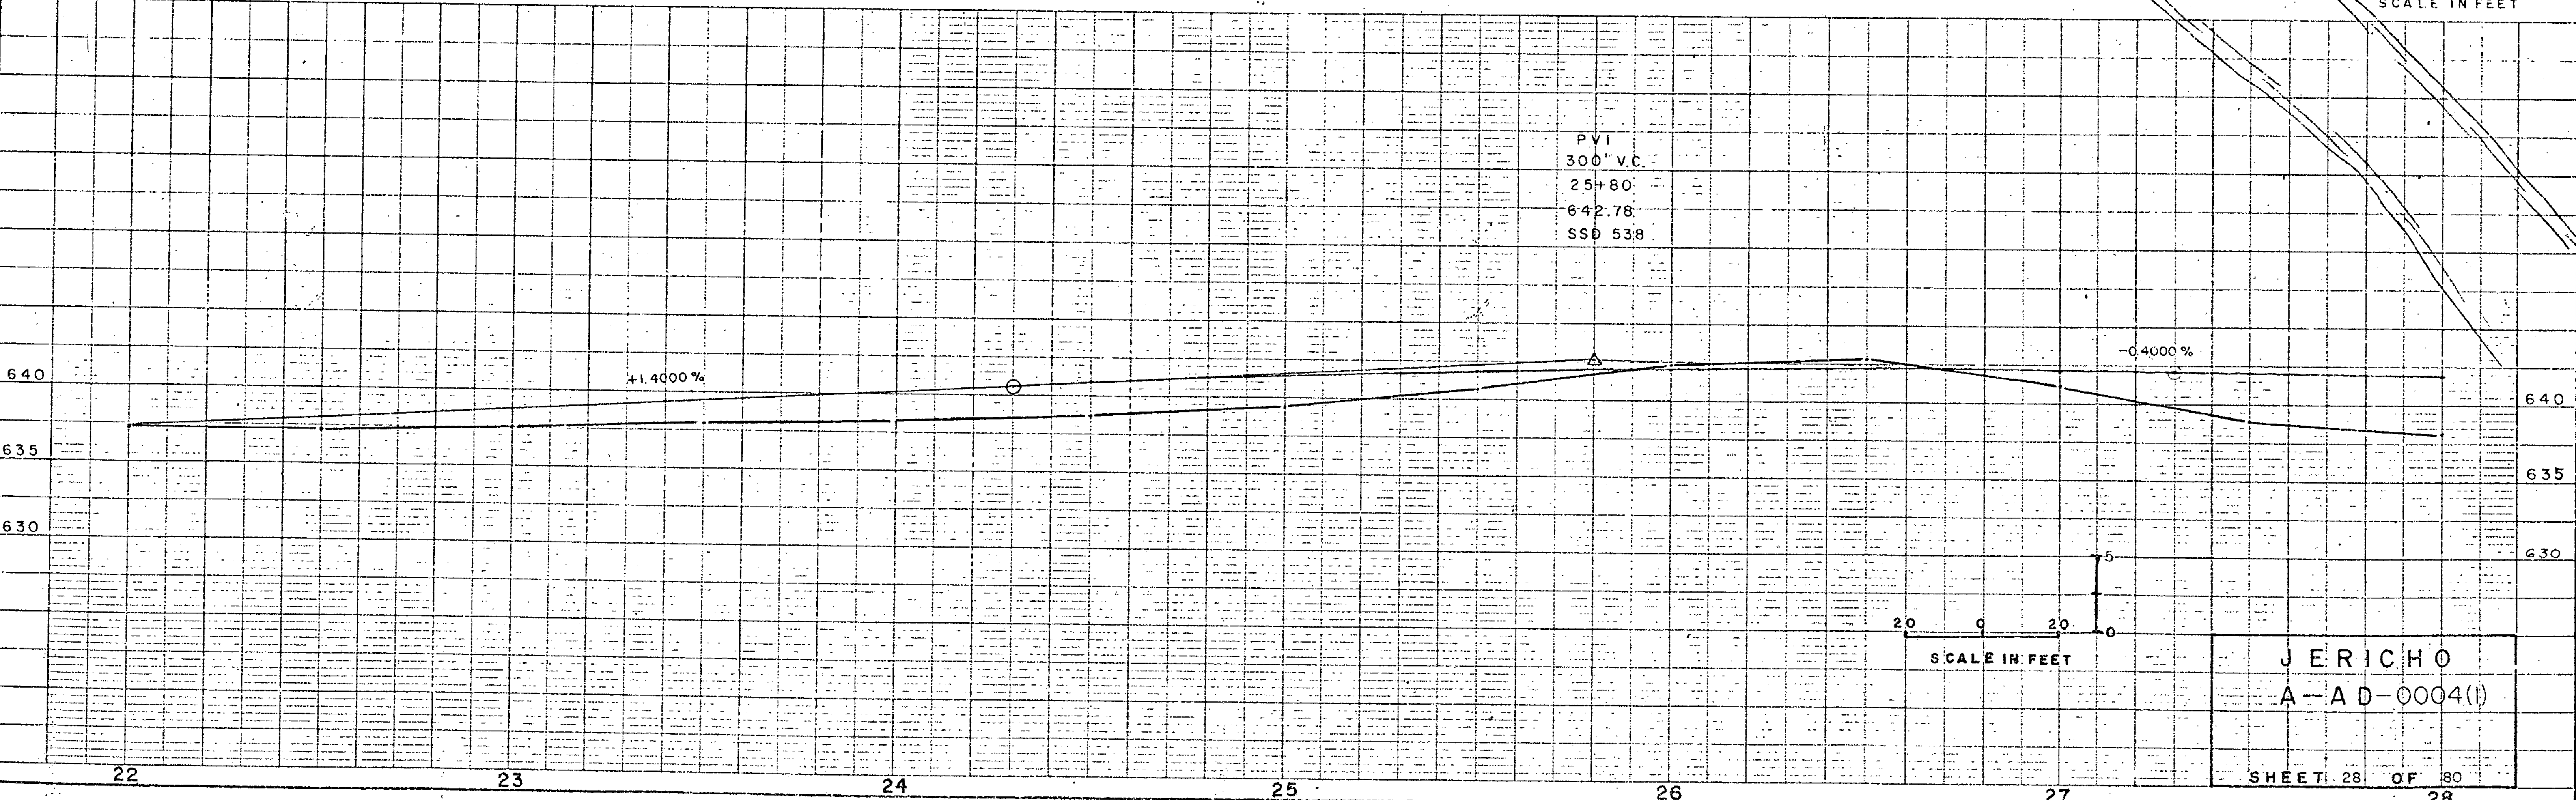


PLAN  
 DATE: 1-1-63  
 DRAWN BY: S. VALLEE  
 CHECKED BY: S. VALLEE  
 NOTE BOOK: 11-10-100-100  
 No. 1

PROFILE  
 DATE: 1-1-63  
 DRAWN BY: S. VALLEE  
 CHECKED BY: S. VALLEE  
 NOTE BOOK: 11-10-100-100  
 No. 1

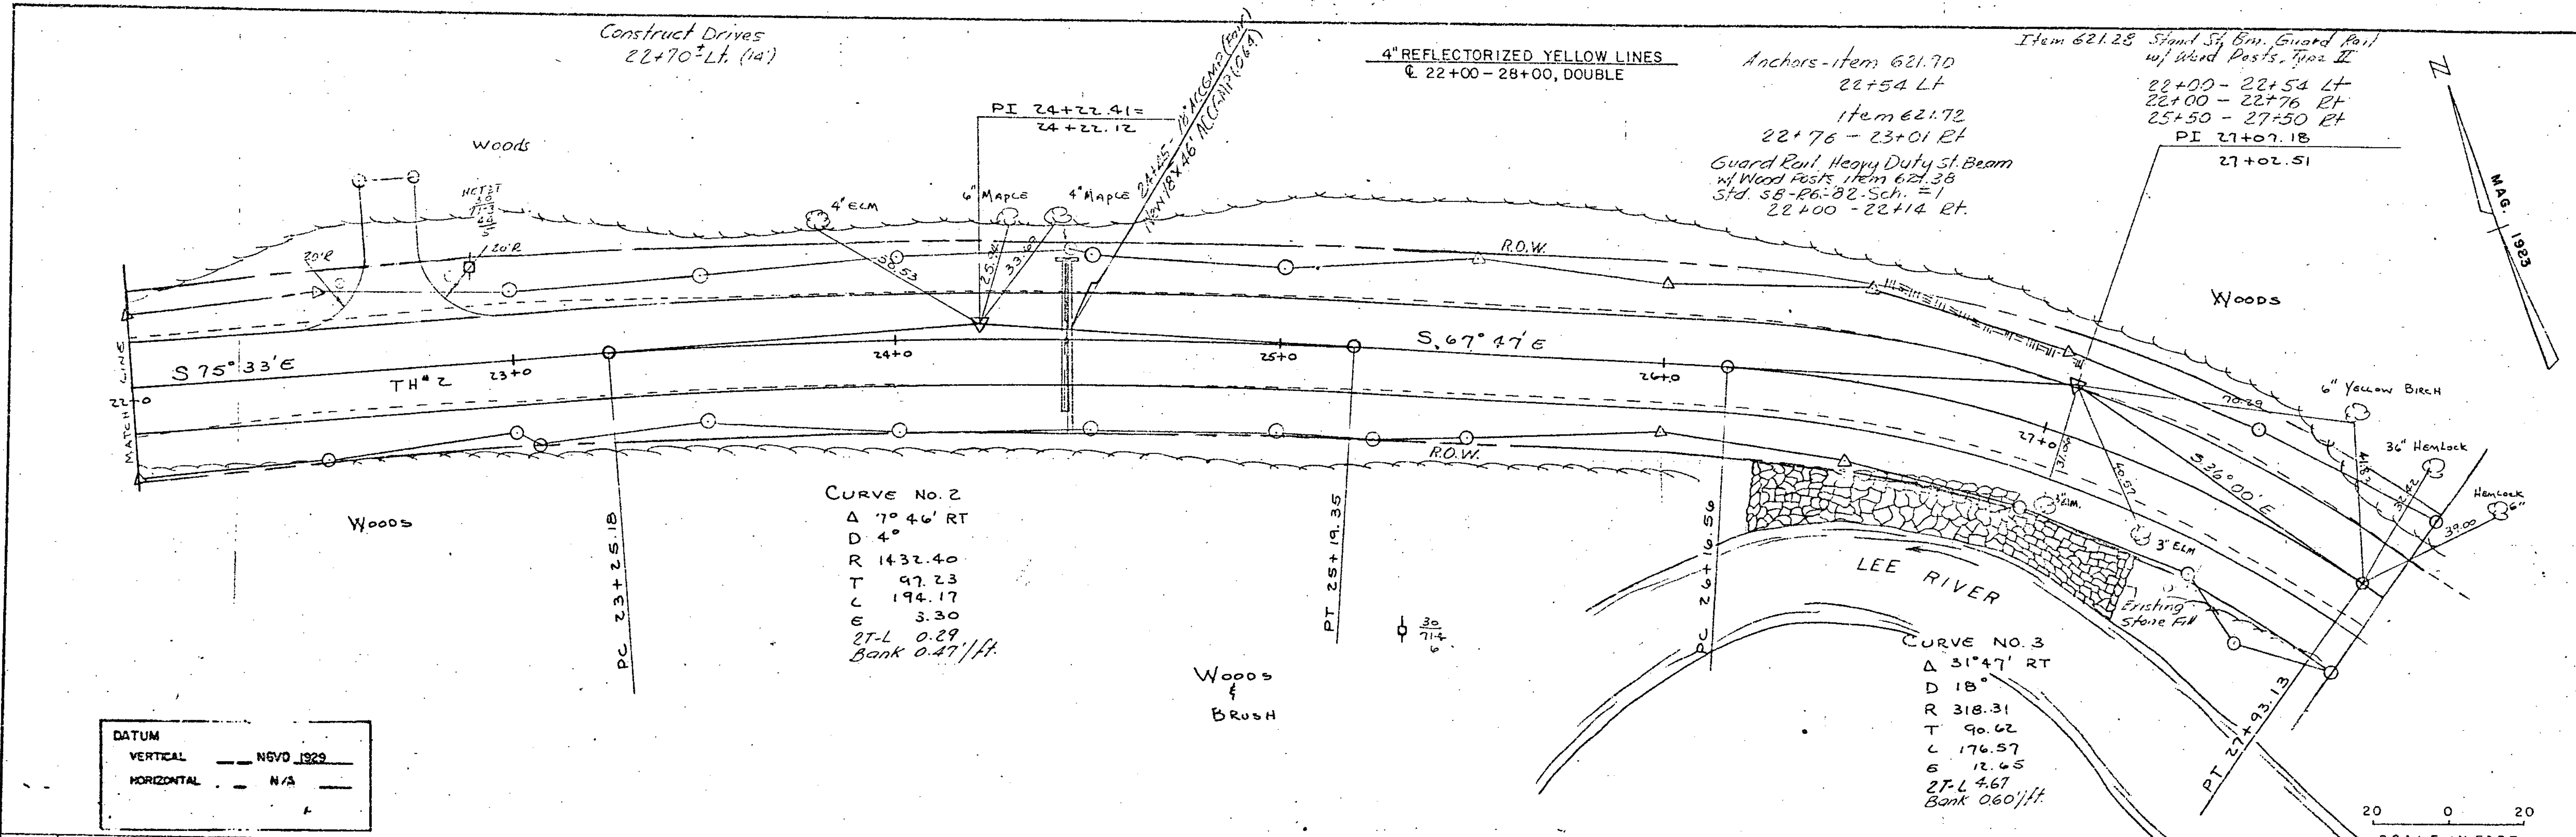

JERICHO  
 A-A D-0004(1)  
 SHEET 28 OF 80