


Construct Drive
 30+25 RT.
 (16') 31+00 LT (Do not disturb gate)

4" REFLECTORIZED YELLOW LINES
 @ 28+00 - 34+00 DOUBLE

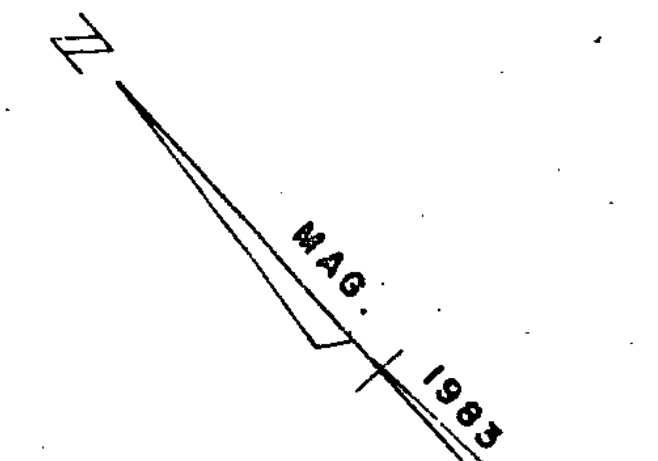

PLAN
 DATE: 1/23/83
 DRAWN BY: J. L. B. / J. L. B.
 CHECKED BY: J. L. B. / J. L. B.
 NO. 1

CURVE NO. 4
 Δ 18° 48' CT.
 D 8°
 R 716.20
 T 118.57
 L 235.0
 E 9.75
 2T-L 2.14
 Bank 060'/ft.

CURVE NO. 5
 Δ 2° 42' RT
 D 2°
 R 2864.79
 T 67.51
 L 135.0
 E 0.80
 2T-L 0.02
 Bank 0.30'/ft.


DATUM
 VERTICAL NGVD 1929
 HORIZONTAL N/A

SCALE IN FEET
 0 20

SCALE IN FEET
 0 20

JERICHO
 A-A D-0004(1)

SHEET 29 OF 80

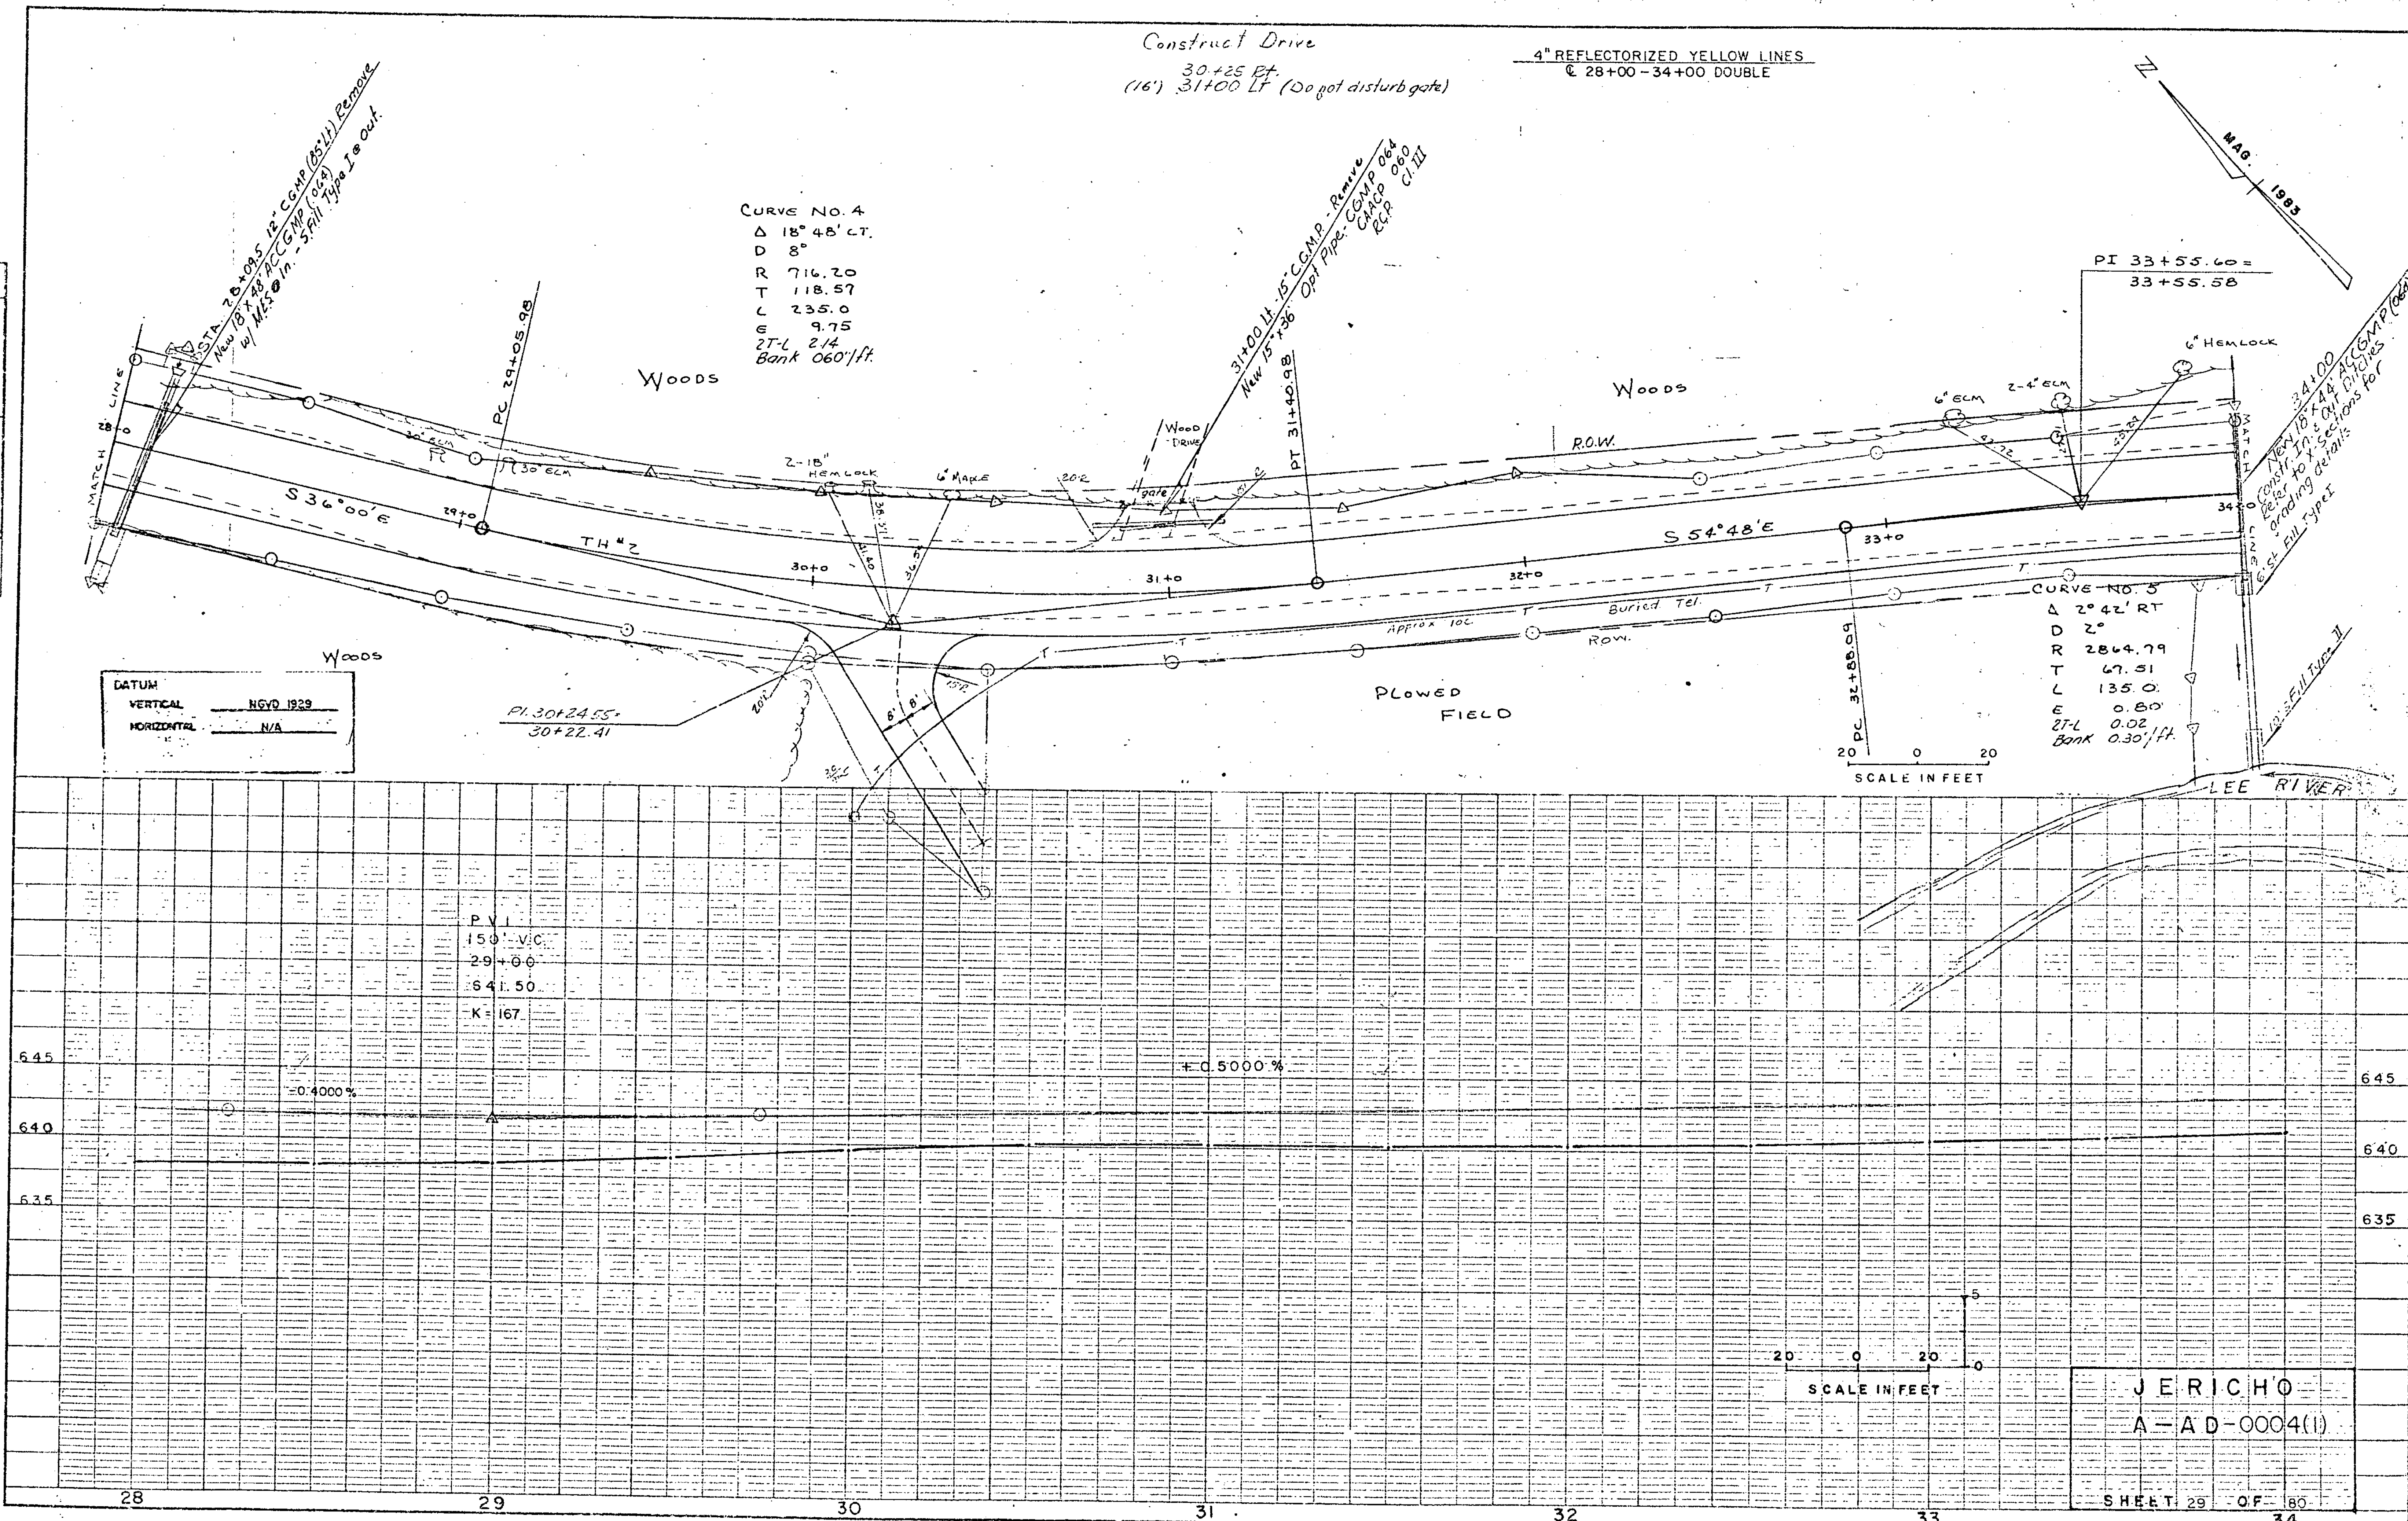

PROFILE
 DATE: 1/23/83
 DRAWN BY: J. L. B. / J. L. B.
 CHECKED BY: J. L. B. / J. L. B.
 NO. 1

PVI
 150' V.C.
 29+00
 641.50
 K=167

-0.4000%

+0.5000%

28

29

30

31

32

33

34