
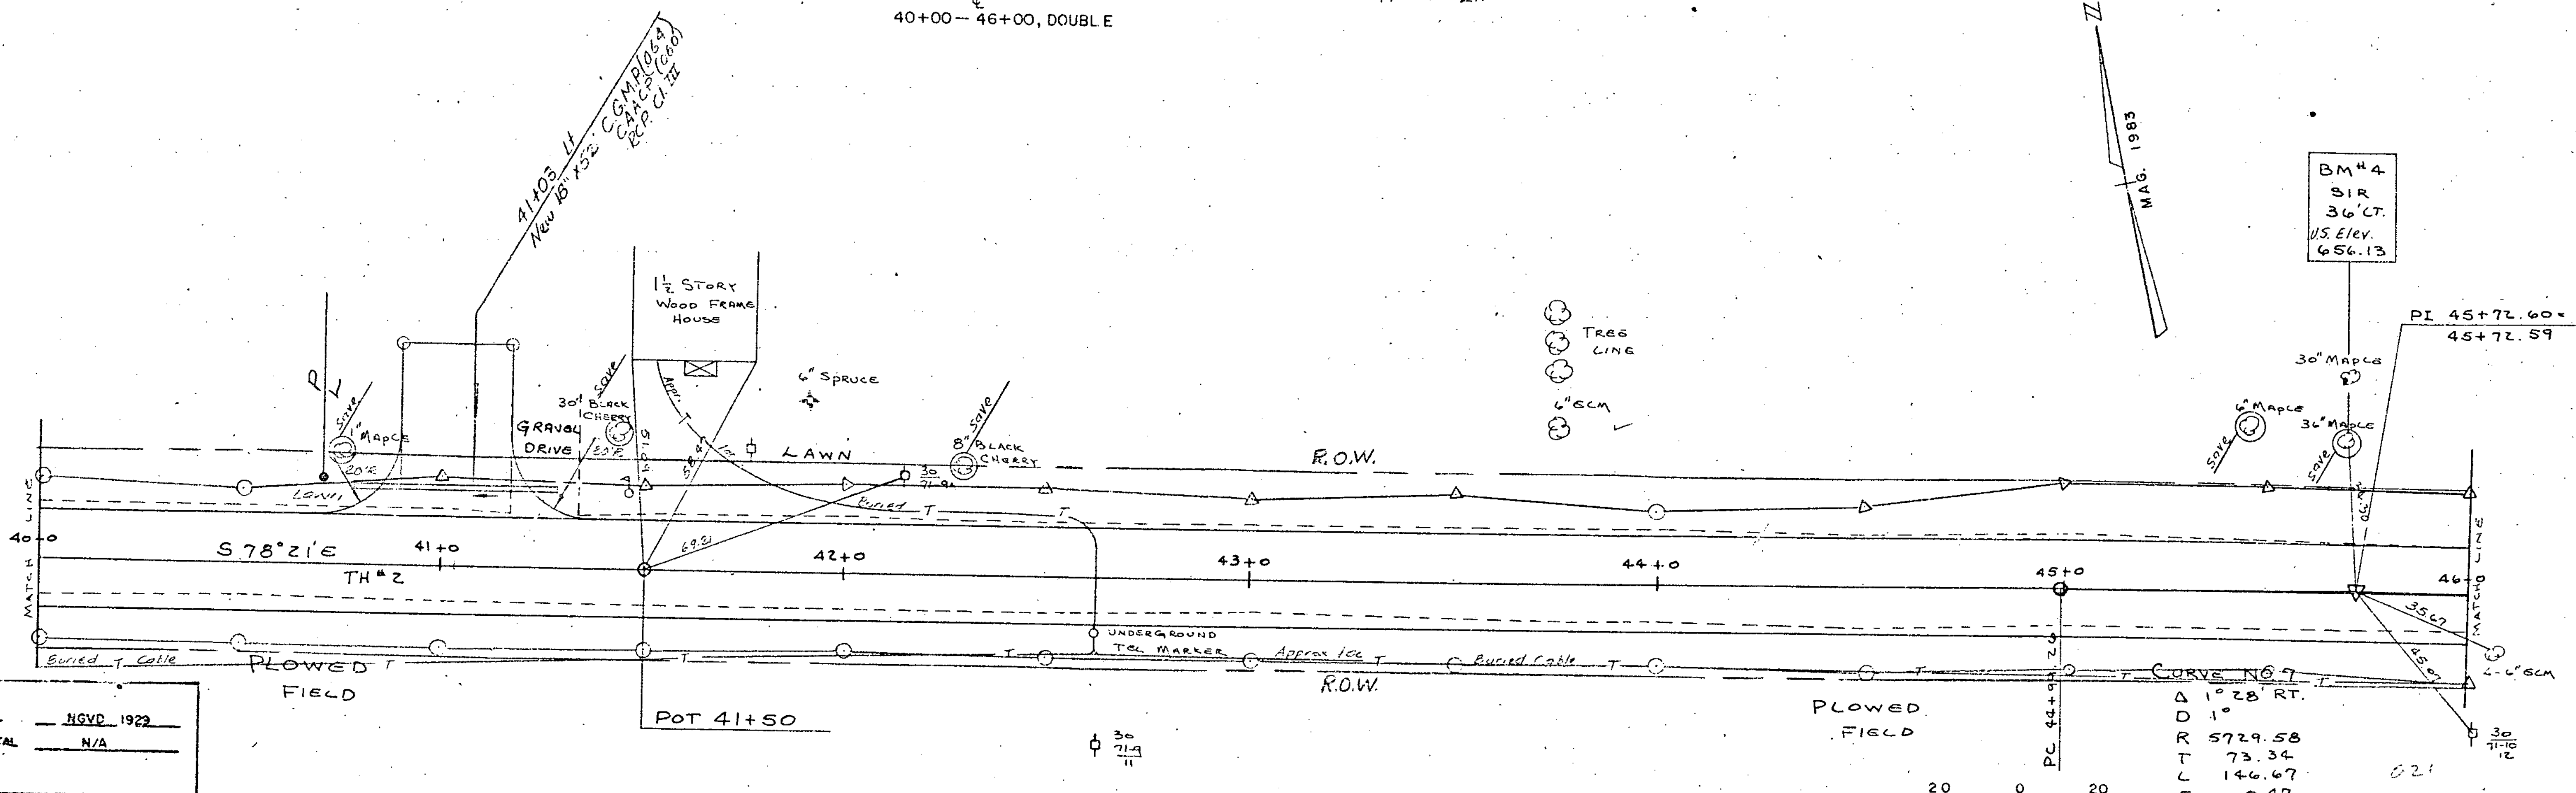


PLAN
 DATE: 11/15/83
 DRAWN BY: J. VALLE
 CHECKED BY: J. VALLE
 NO. 1

PROFILE
 DATE: 11/15/83
 DRAWN BY: J. VALLE
 CHECKED BY: J. VALLE
 NO. 1

4" REFLECTORIZED YELLOW LINE
 Construct Drive
 41+03 Lt.
 40+00 - 46+00, DOUBLE

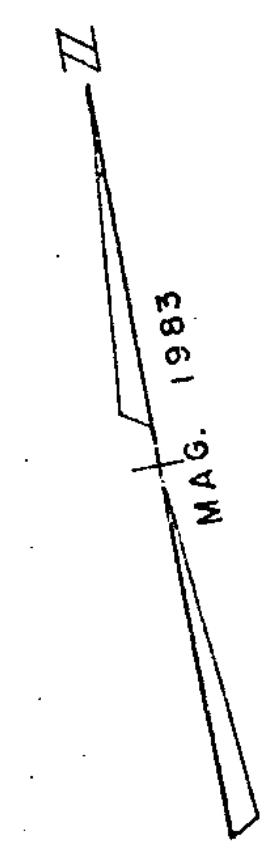

DATUM
 VERTICAL: NGVD 1929
 HORIZONTAL: N/A

PVI
 40+00
 300' V.C.
 649.25
 SSD = 6,113

CURVE NO. 7
 Δ 1° 28' RT.
 D 1°
 R 5729.58
 T 73.34
 L 146.67
 E 0.47
 2T-L 0.01
 Bank 22/1/81

SCALE IN FEET
 20 0 20

SCALE IN FEET
 20 0 20

JERICO
 A-A-D-0004(1)

SHEET 31 OF 80