


PLAN
 DATE: 11/15/83
 DRAWN BY: JAVIERE
 CHECKED BY: JAVIERE
 NO. 1


PROFILE
 DATE: 11/15/83
 DRAWN BY: JAVIERE
 CHECKED BY: JAVIERE
 NO. 1

4" REFLECTORIZED YELLOW LINE
 52+00-53+00 DOUBLE
 (53+00-53+50 MATCH EXISTING LINES)

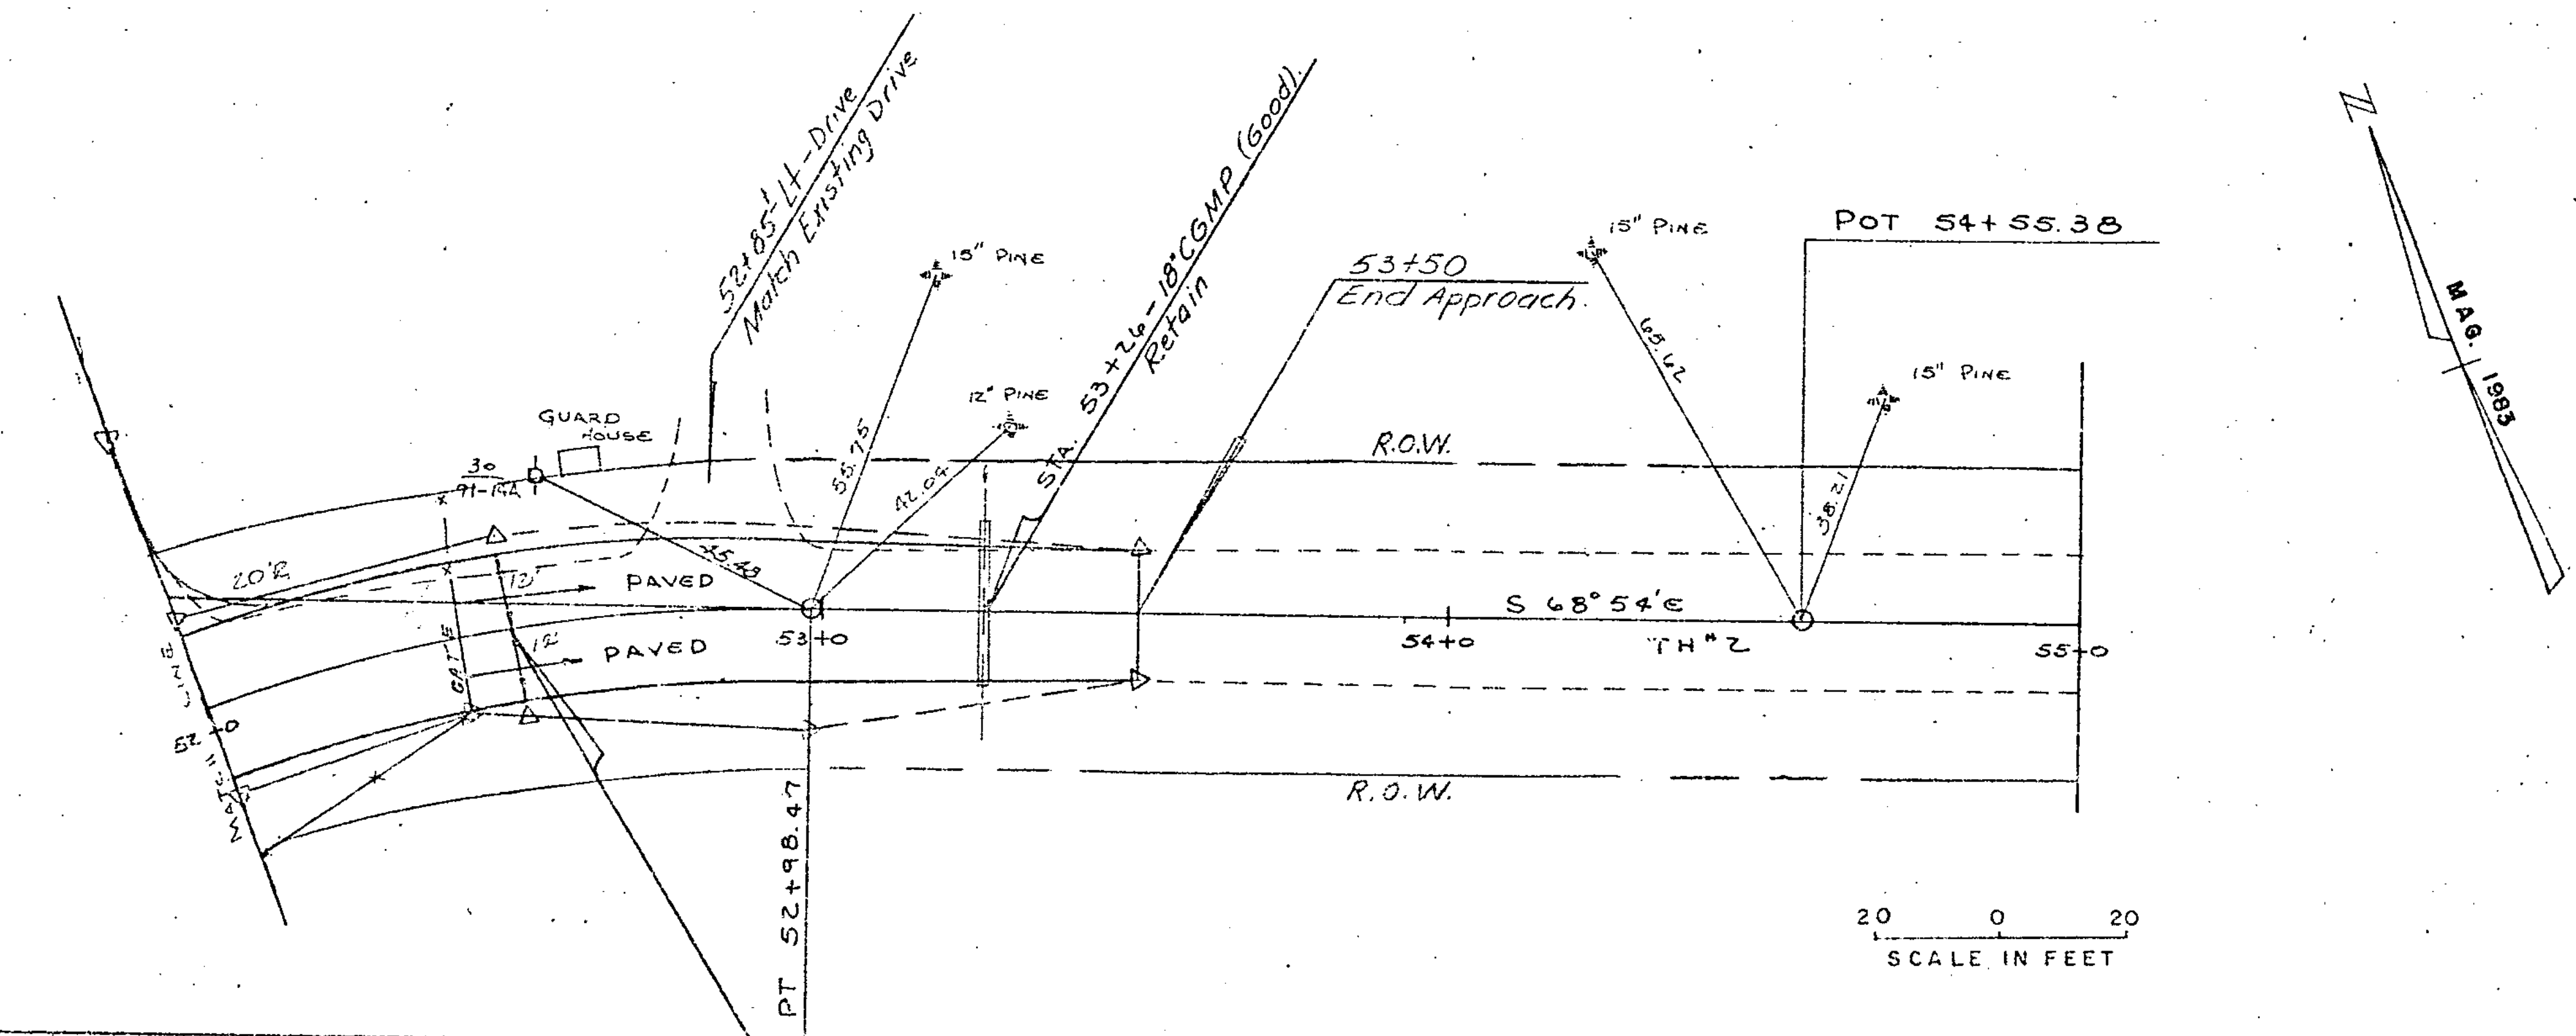

DATUM
 VERTICAL: NGVD 1929
 HORIZONTAL: N/A

20 0 20
 SCALE IN FEET

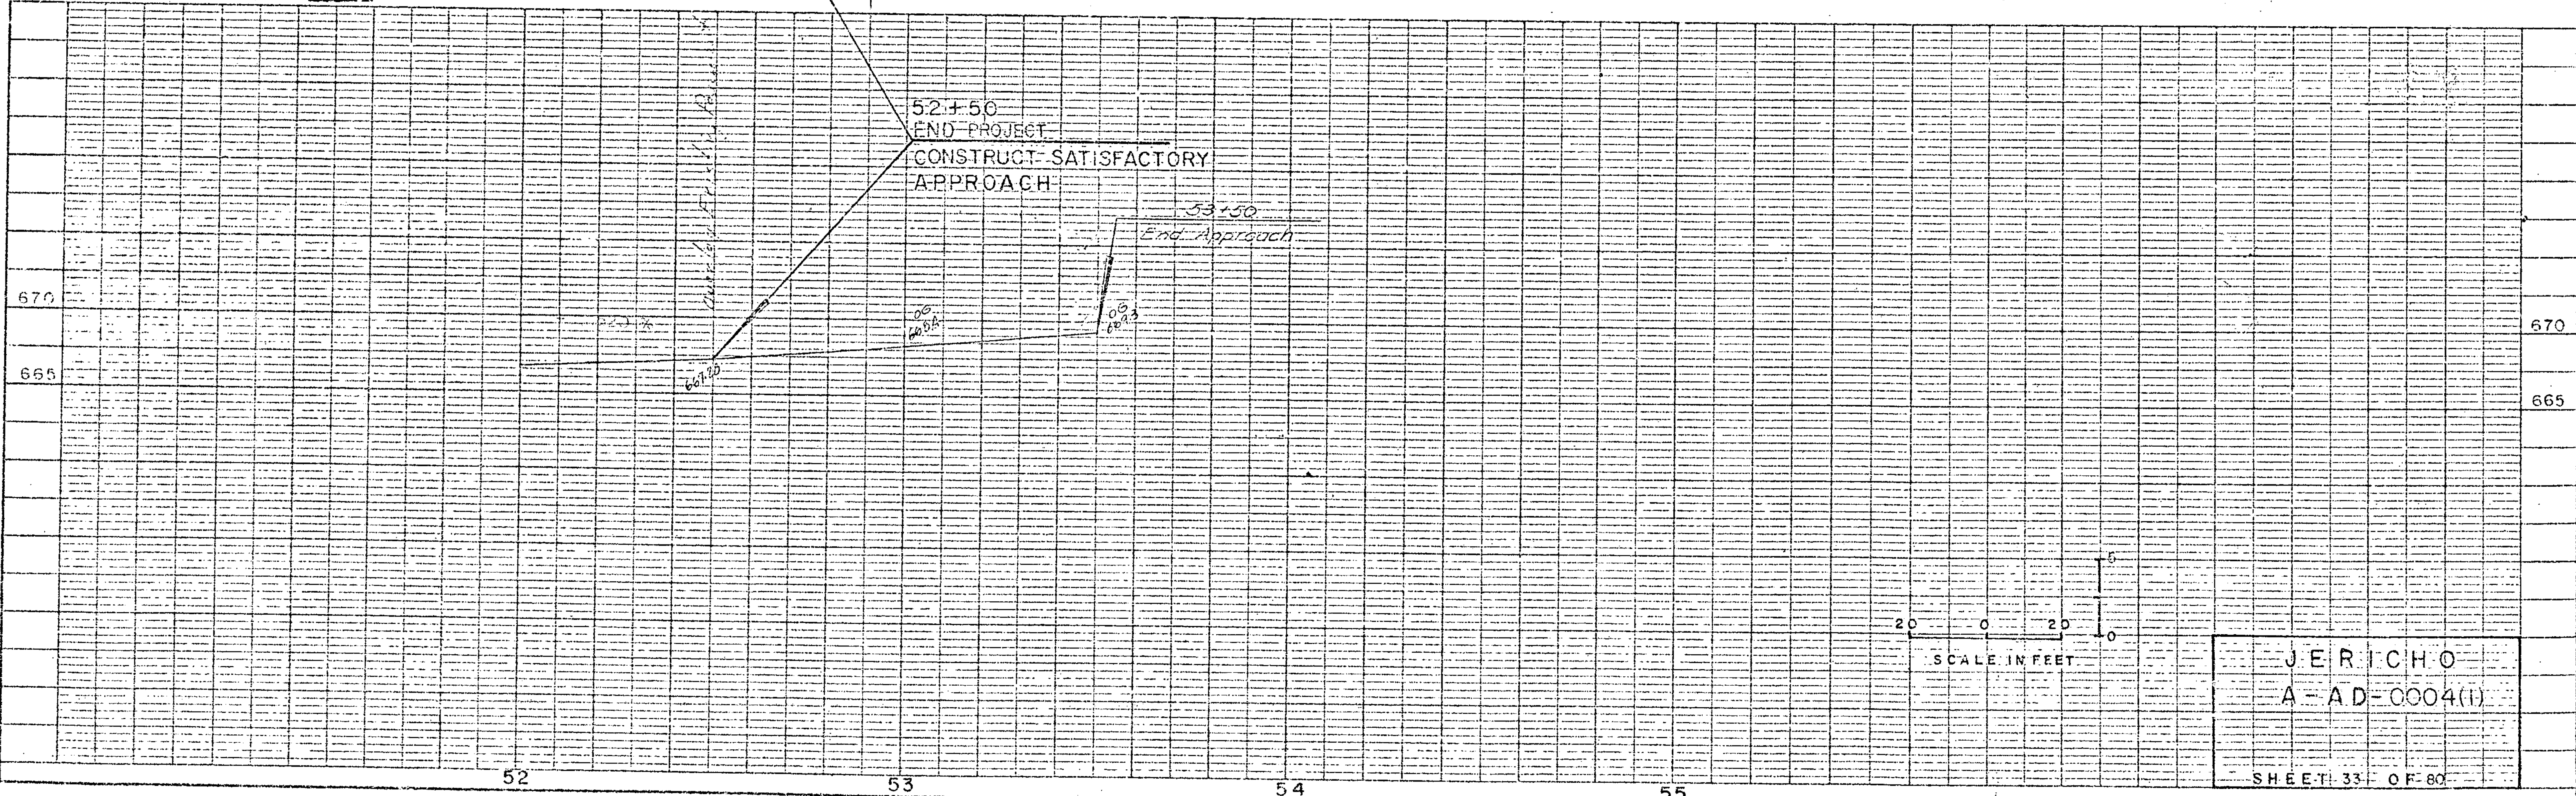

20 0 20
 SCALE IN FEET

JERICHO
 A-AD-0004(1)

SHEET 33 OF 80