


FEDERAL ROAD DISTRICT  
 SURVEY  
 STATE HIGHWAY  
 PROJECT NO. 0004(1)  
 SHEET NO. 71 OF 80


ORIGINAL SURVEY  
 DATE 2-83  
 BY F. CASSIDY  
 CHECKED BY  
 DATE

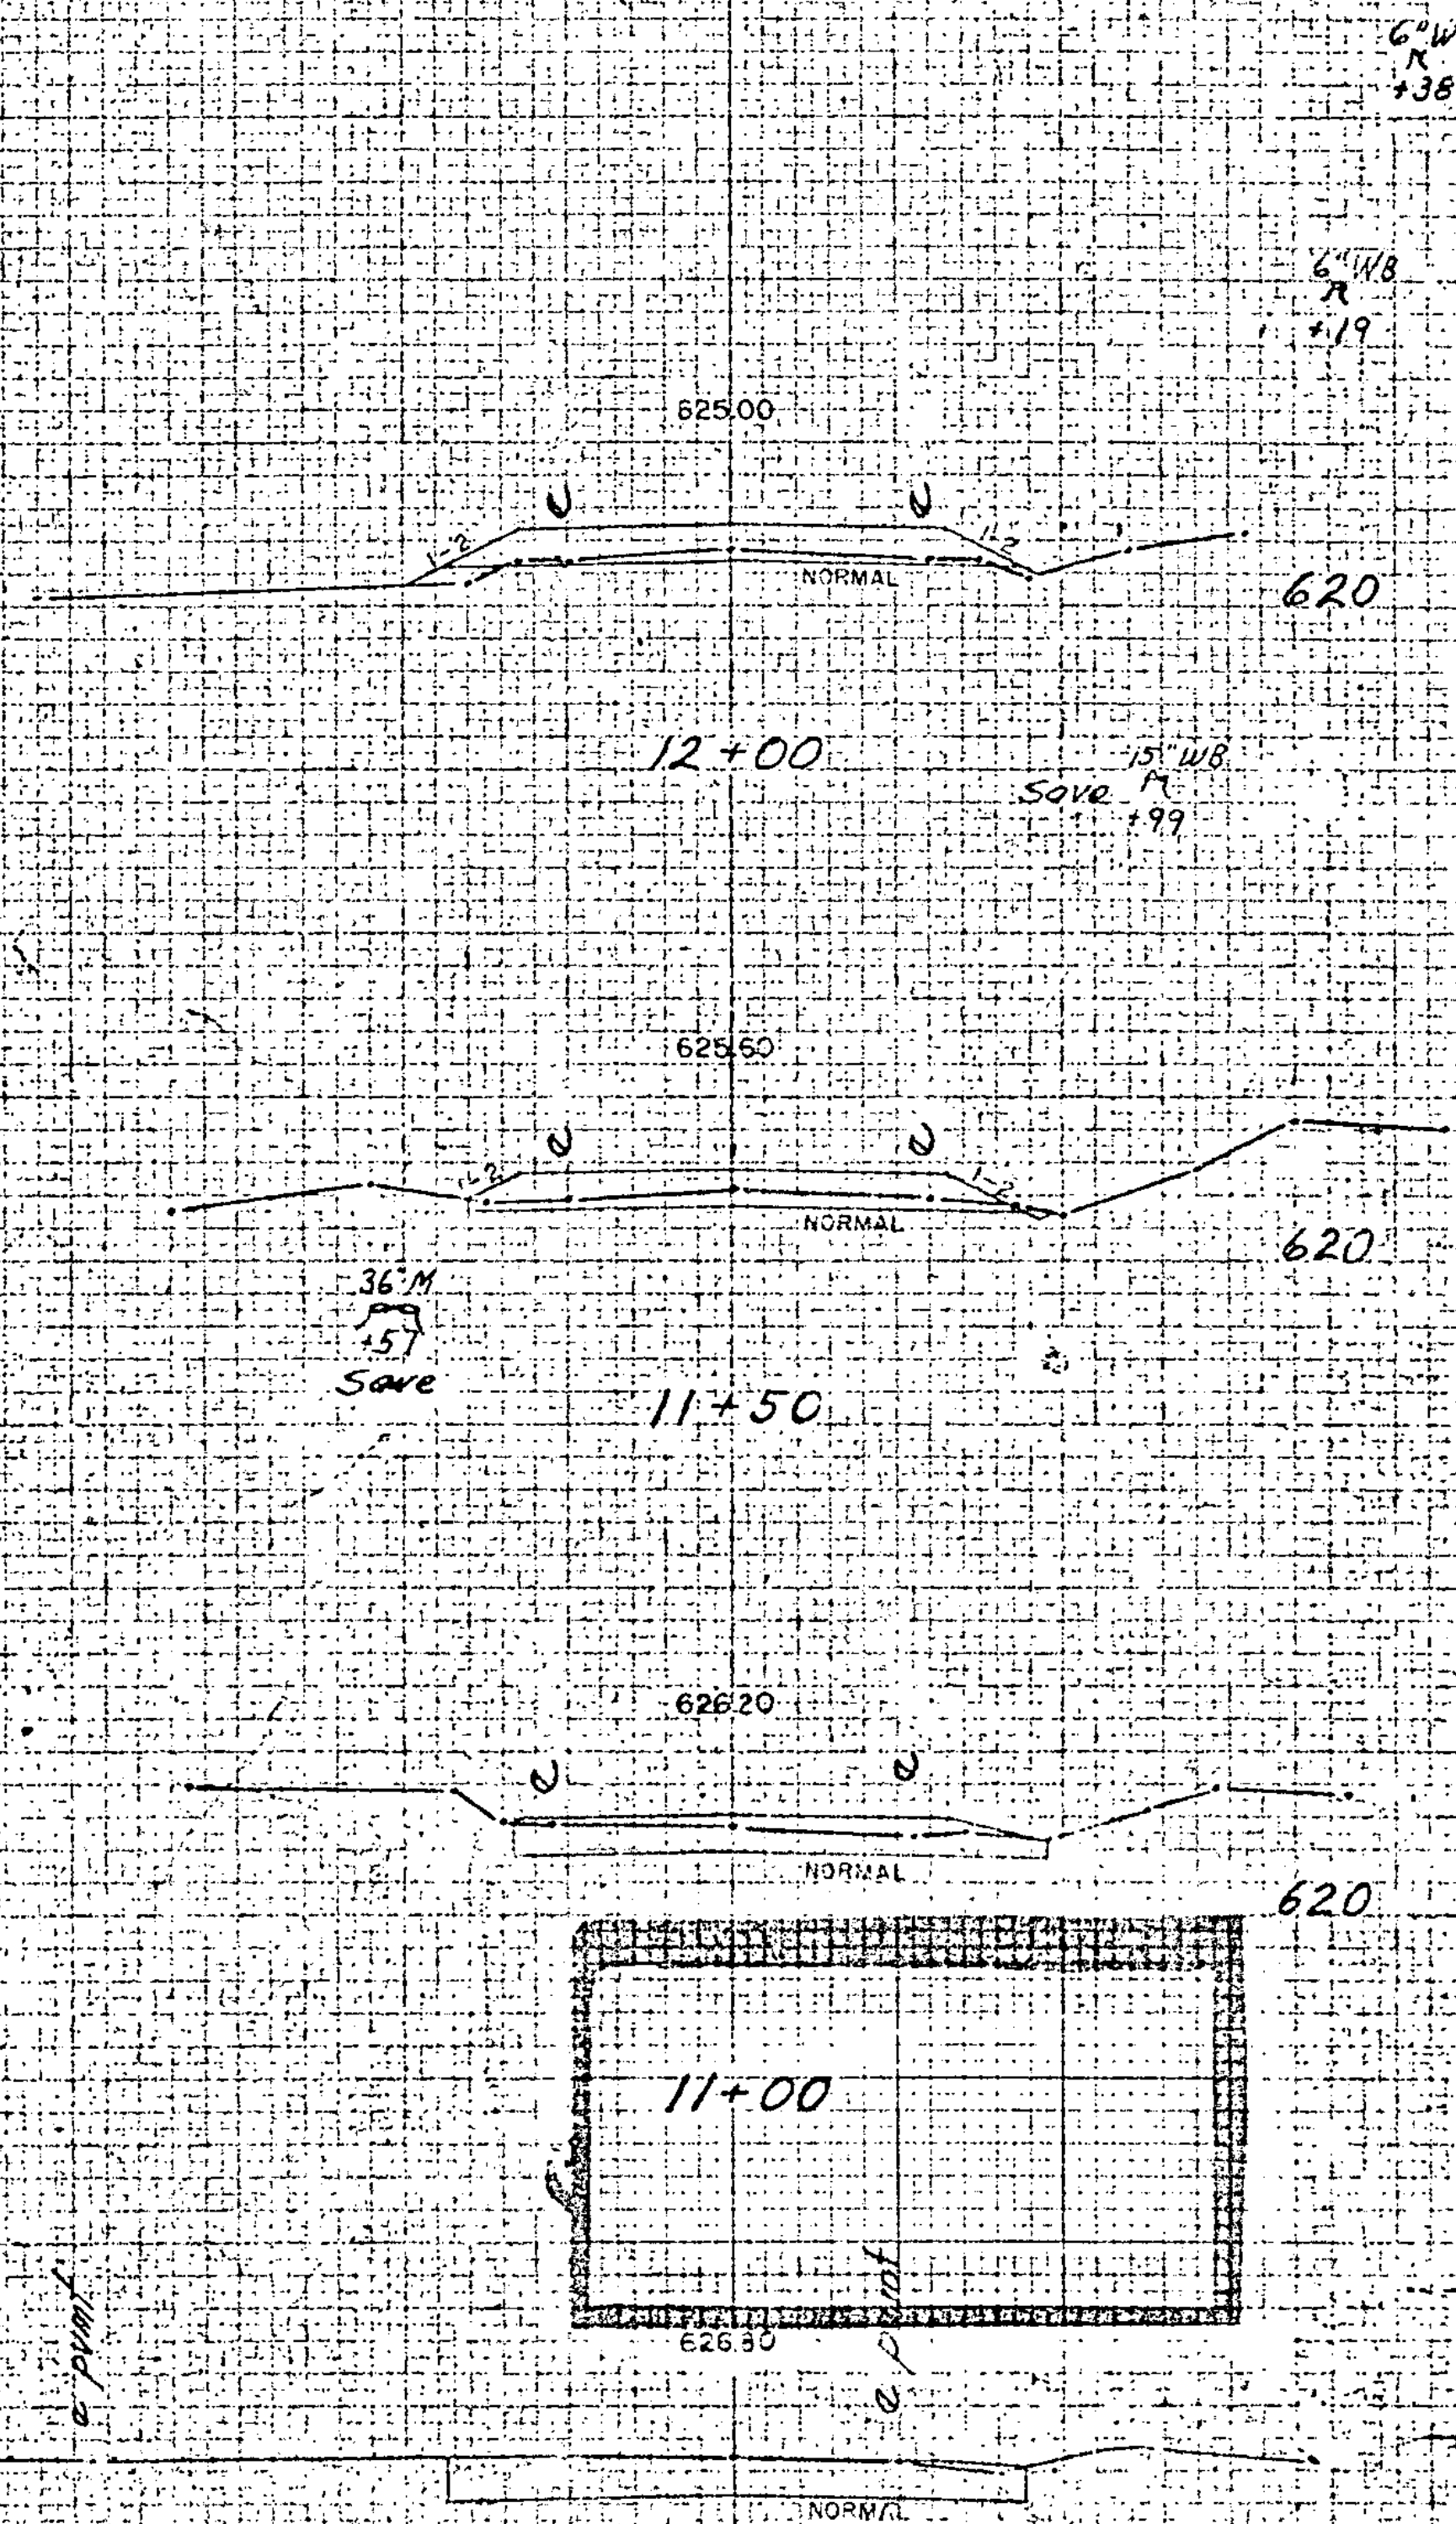

Note: Use Gravel Surface Course  
17pm 401.10 for sub-base  
for drives

10+50  
 Begin Project  
 End Approach Construction  
 3-4' E  
 A  
 +38

10+00  
 Begin Approach Construction  
 T.H. #2

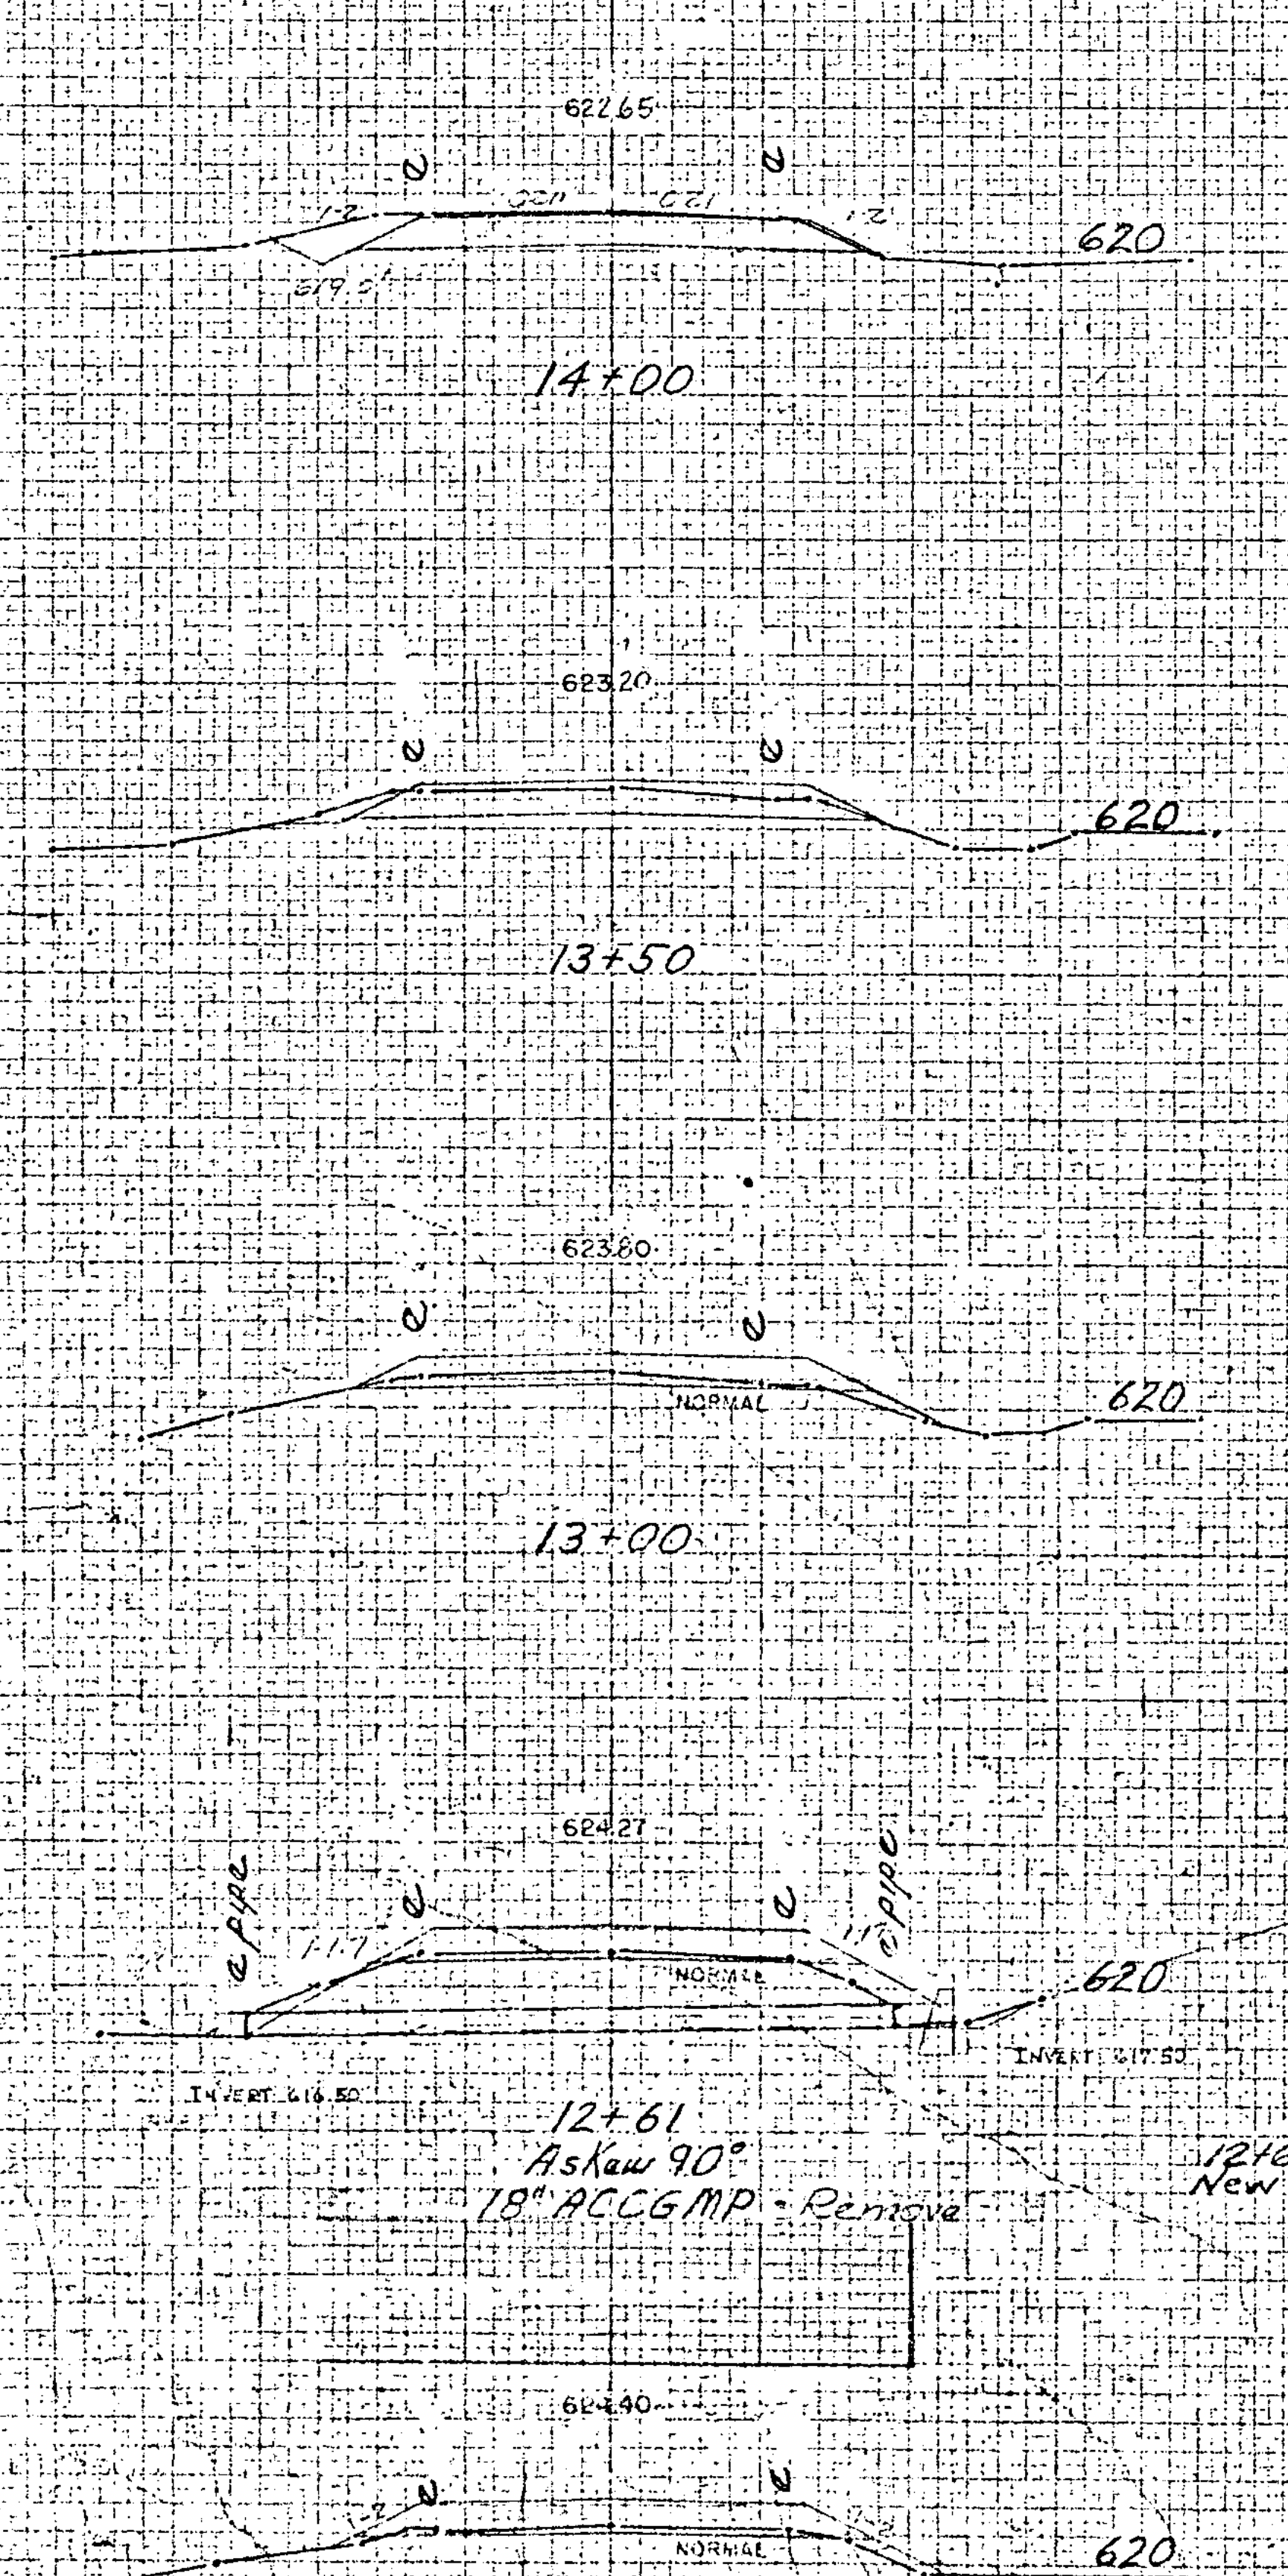

12+61  
 As skew 90°  
 18' ACCGMP - Remove  
 New 18 x 48' ACCGMP (OGA)

10' E  
+46

12+50

10 0 5 10  
 Scale in Feet

STA 10+00 ~ 14+00  
 JERICHO  
 A-AD-0004(1)  
 Surveyed Lavallee JAN 83  
 SHEET 71 OF 80

T.H. #2