


New 18'x40' ACCGMP (064)  
 WITH METAL END SECTIONS & 1/2" ST  
 16+52 SPACING 4' @ 10'  
 18" ACCGMP  
 ASKEW 90°  
 REMOVE

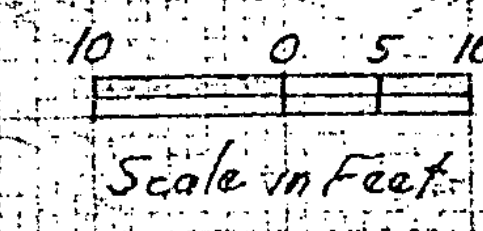

STA 14+50 ~ 18+50  
 JERICHO  
 A-AD-0004 (1)  
 Surveyed Lavallee JAN 83  
 SHEET 12 OF 80