


FINAL SURVEY	DATE
PLANNED	
PLATE	
NO. BOOK	
NO. SHEET	

ORIGINAL SURVEY	DATE
PLANNED	
PLATE	
NO. BOOK	
NO. SHEET	

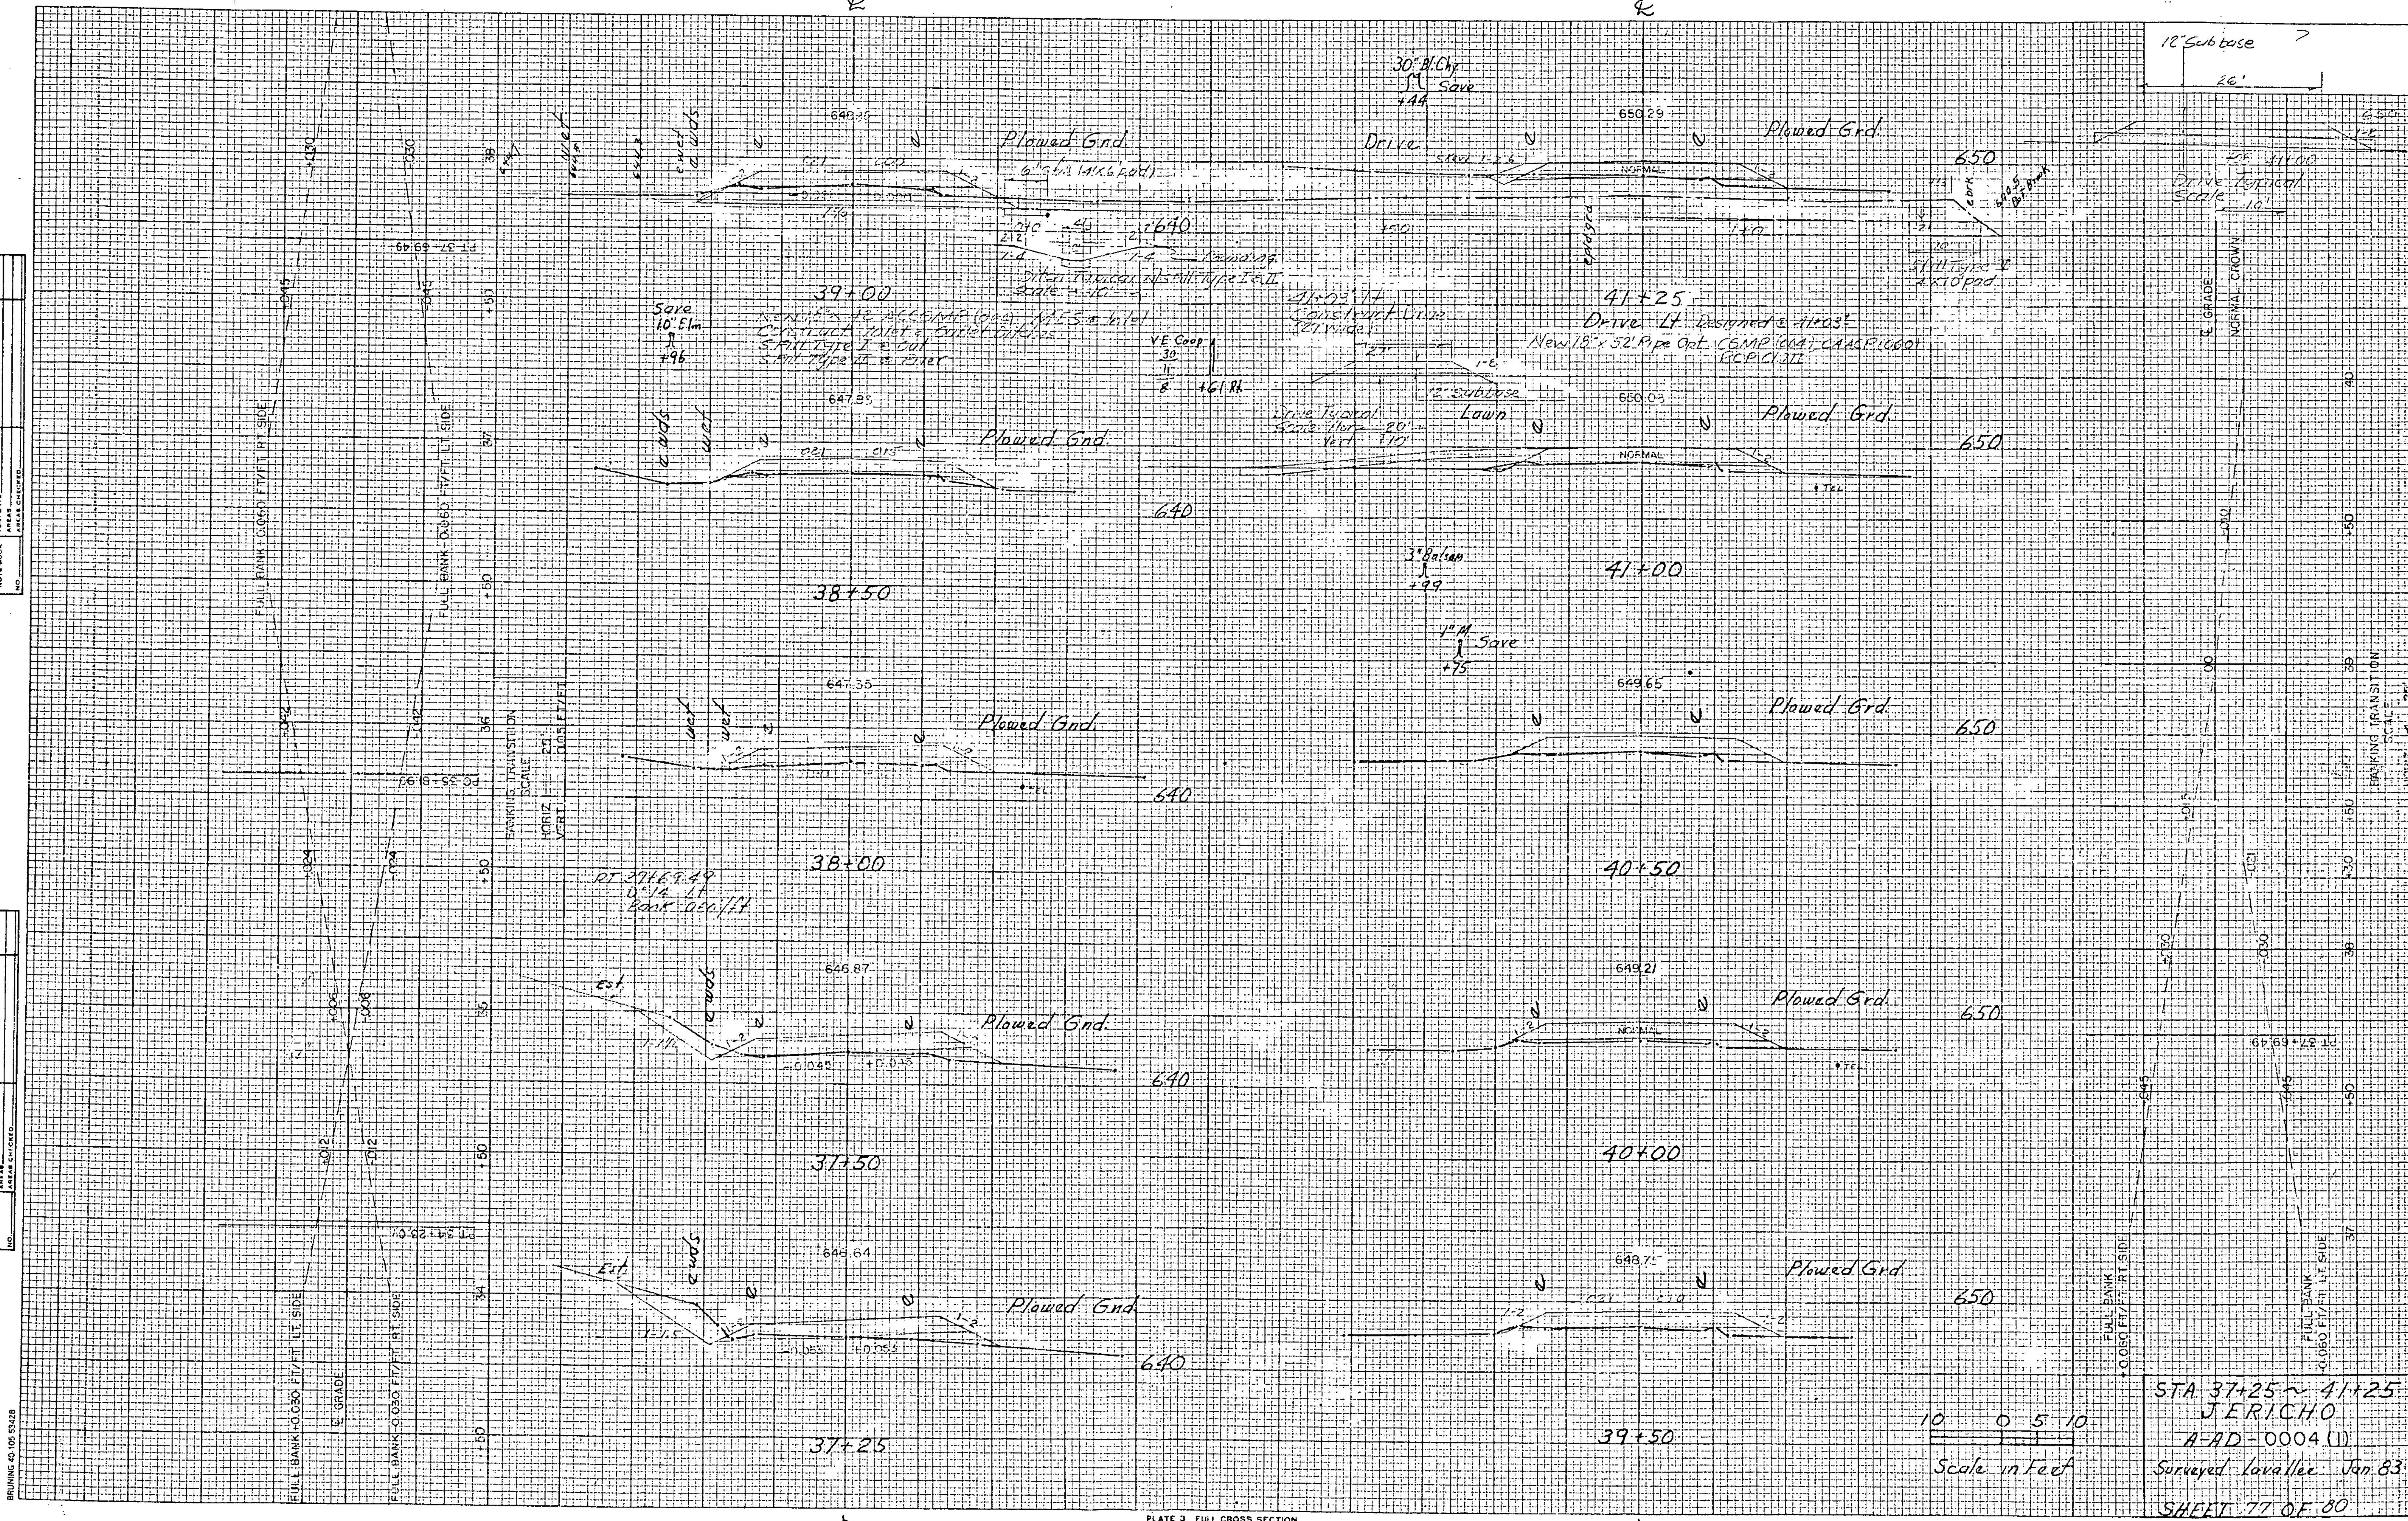

STA 37+25 ~ 41+25  
 JERICHO  
 A-AD-0004 (1)  
 Surveyed Lavallee Jan 83  
 SHEET 77 OF 80