

DATE	BY
2-83	R. CASSIDY
REVISION	
NO. 1	
NO. 2	
NO. 3	
NO. 4	
NO. 5	
NO. 6	
NO. 7	
NO. 8	
NO. 9	
NO. 10	

DATE	BY
2-83	R. CASSIDY
REVISION	
NO. 1	
NO. 2	
NO. 3	
NO. 4	
NO. 5	
NO. 6	
NO. 7	
NO. 8	
NO. 9	
NO. 10	

SPRINKLING 40 (109.5) 2478

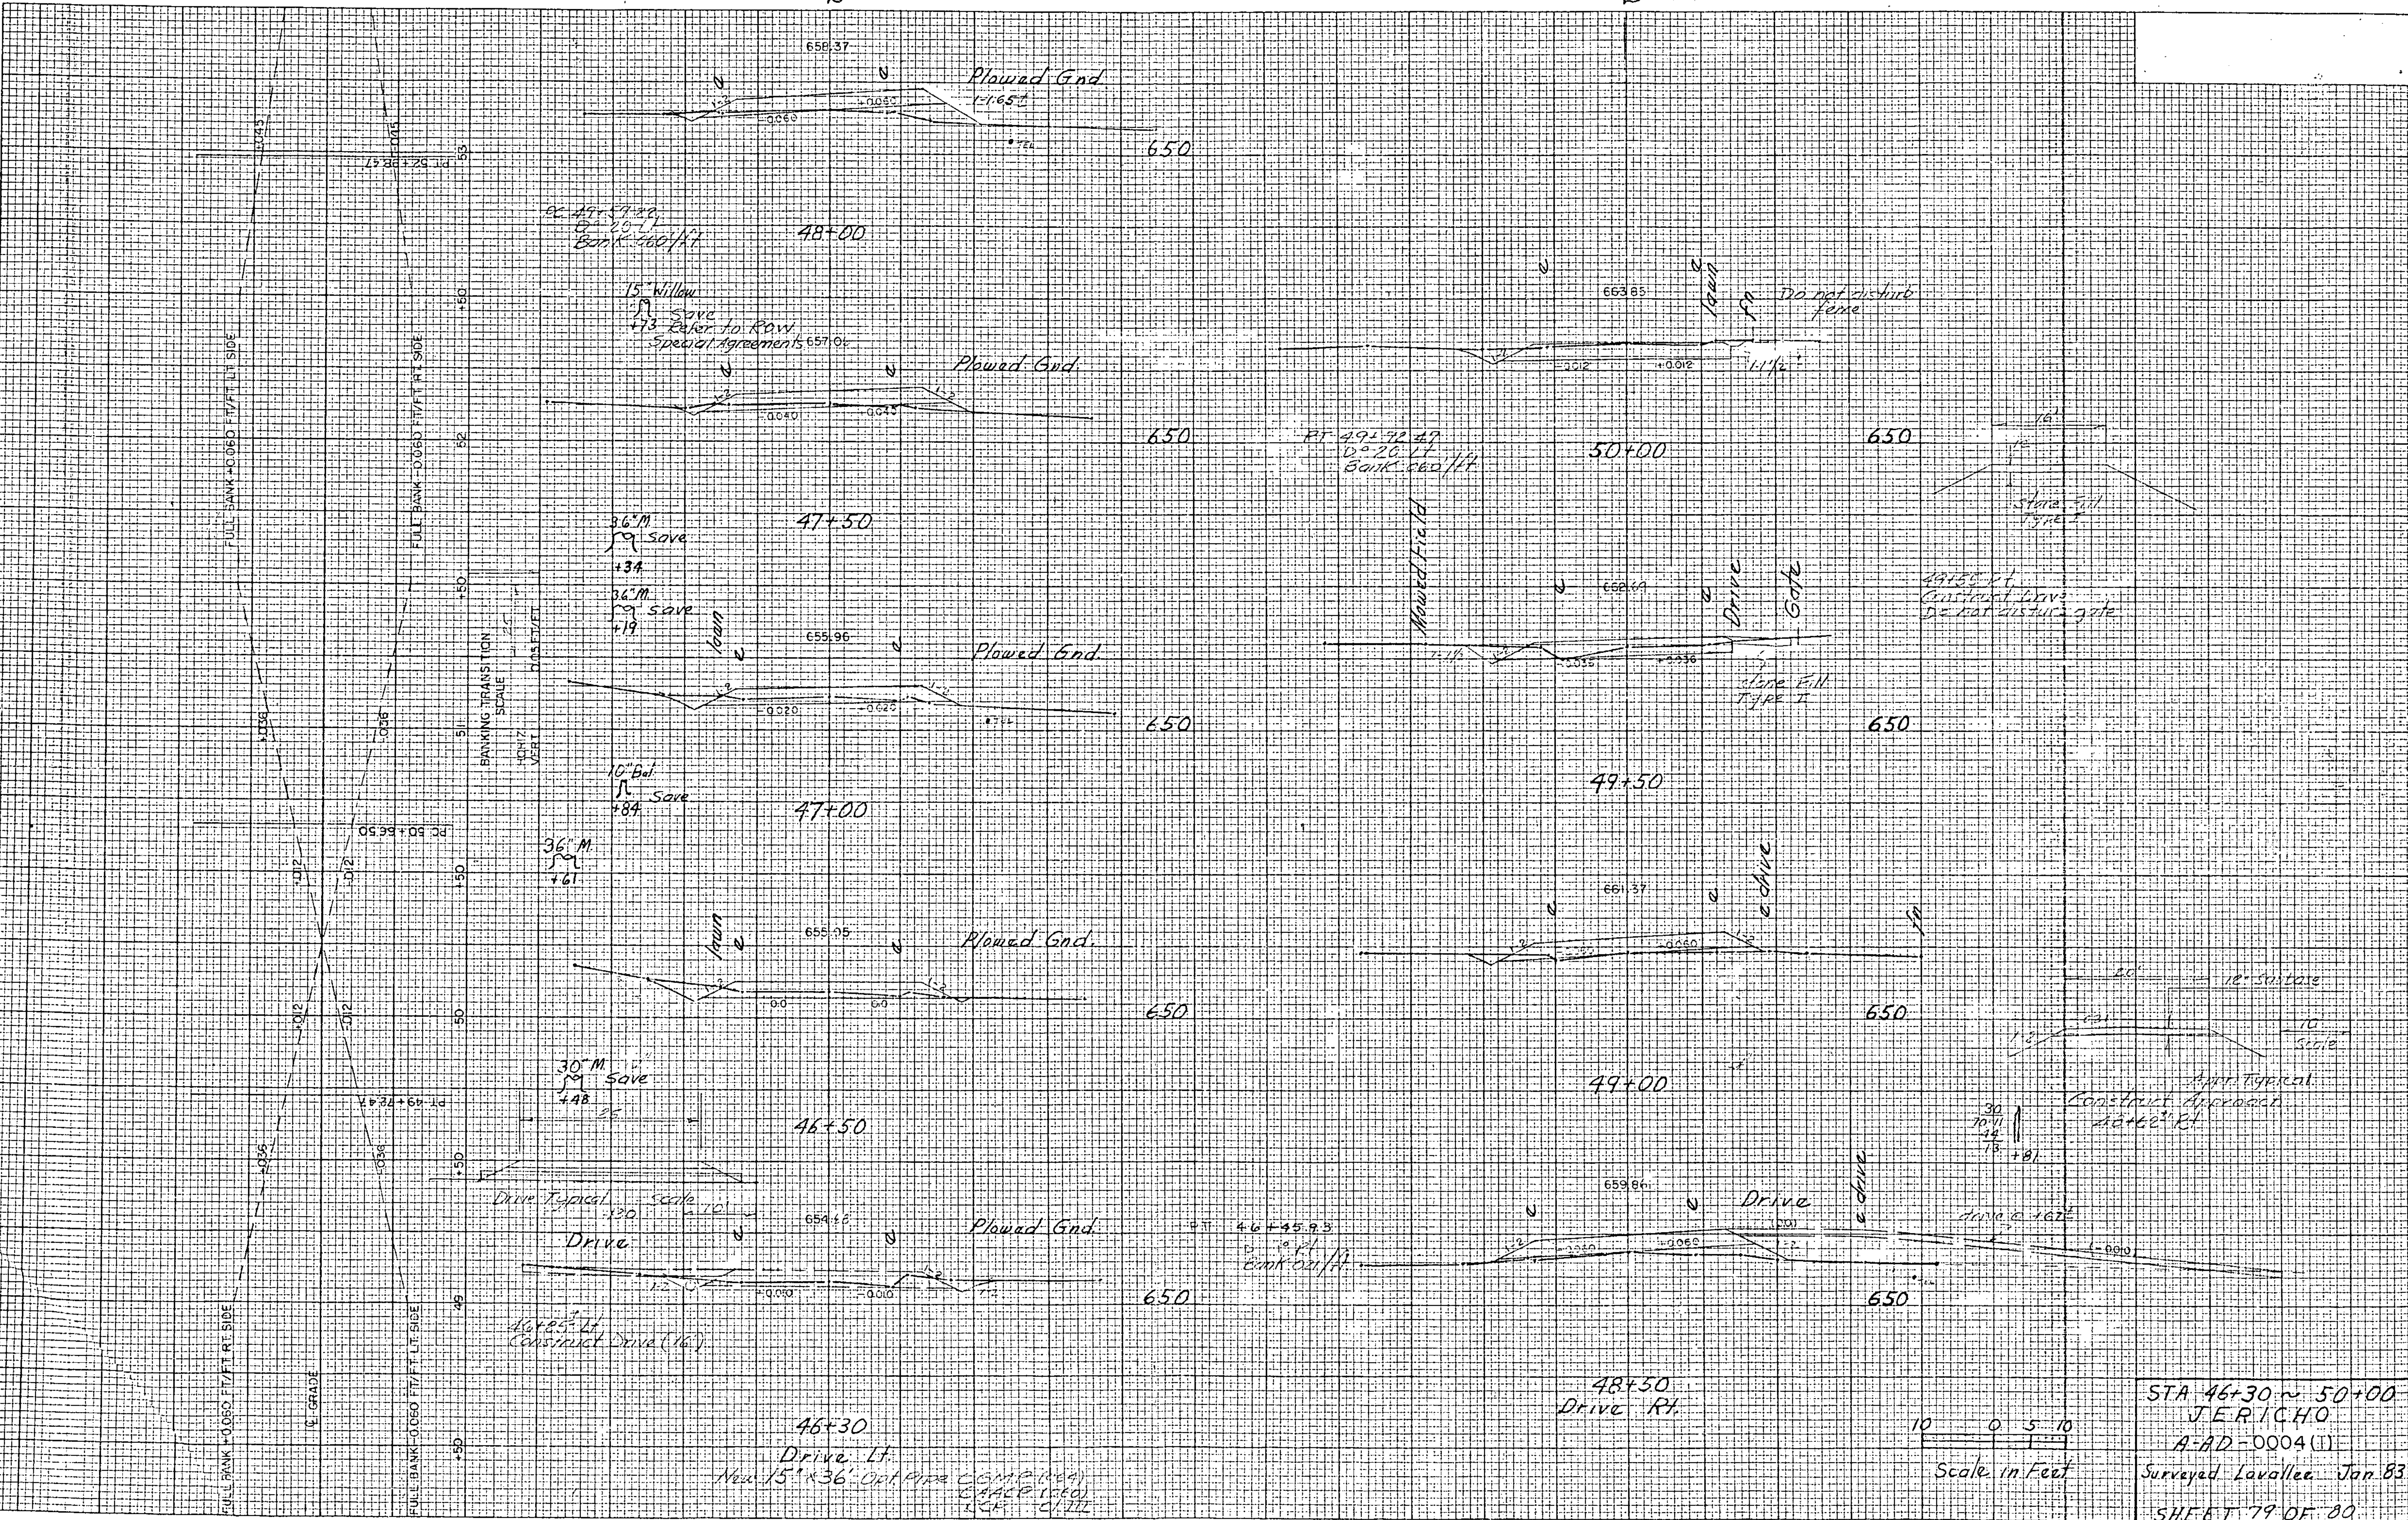


PLATE 3 FULL CROSS SECTION  
CHARLES BRUNING COMPANY  
MADE IN U.S.A.

STA 46+30 ~ 50+00  
JERICHO  
A-AD-0004 (1)  
Surveyed Lavallee Jan 83  
SHEET 79 OF 80