


DATE
BY
NO.
FINAL SURVEY PLOTTED
NOTE BOOK NO.
AREA CHECKED

DATE
BY
NO.
ORIGINAL SURVEY PLOTTED
NOTE BOOK NO.
AREA CHECKED

BRUNING 40 105 52428

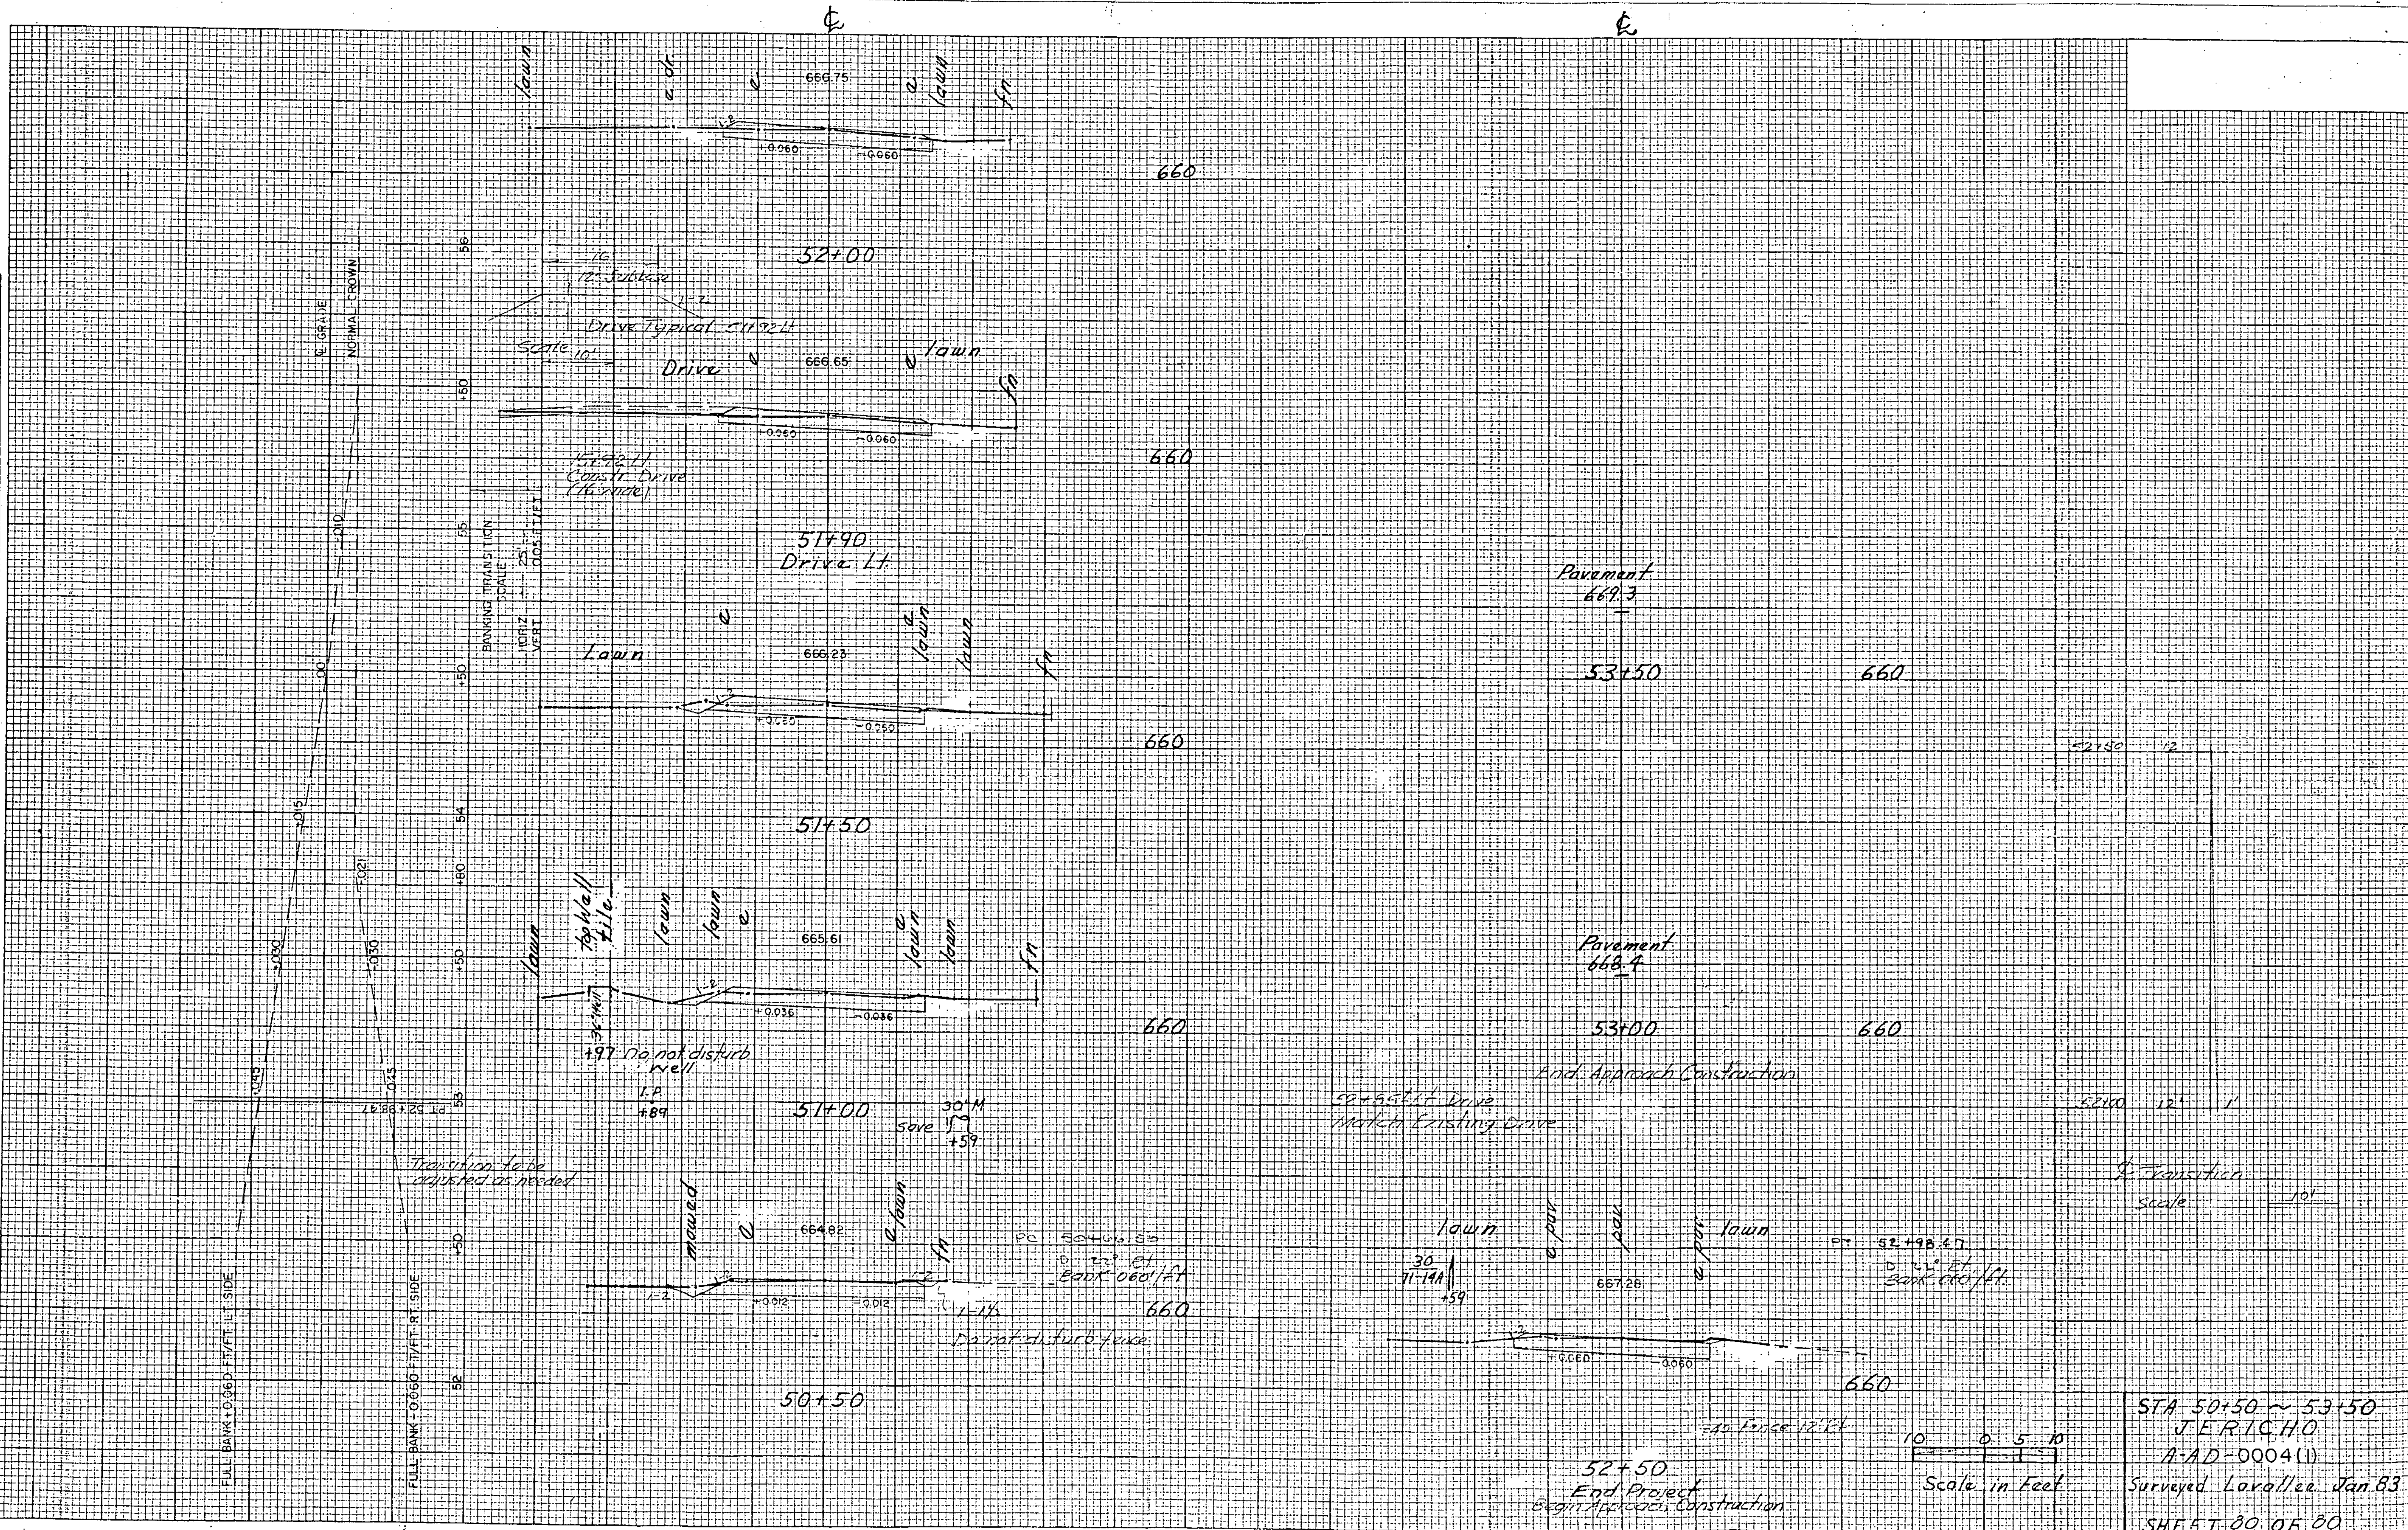

STA 50+50 ~ 53+50
JERICHO
A-D-0004(1)
Surveyed Lovell Jan 83
SHEET 80 OF 80