

646.21 - PAINTED CURBS

NORTHBOUND LT.	SOUTHBOUND RT.
42+75 ~ 43+25	42+75 ~ 43+25
43+75 ~ 44+05	43+75 ~ 44+05
62+40 ~ 62+70	44+95 ~ 45+60
63+70 ~ 64+00	46+70 ~ 47+30
71+00 ~ 71+30	62+40 ~ 62+70
	63+70 ~ 64+00
	65+15 ~ 65+75
	66+25 ~ 66+85
	70+50 ~ 71+30

646.22 - ARROW MARKINGS

SOUTHBOUND ONLY	
43+85	65+00
45+10	

646.35 - TEMPORARY 4" REFLECTORIZED WHITE LINES

SOUTHBOUND ONLY


SOLID 40+66 ~ 74+00 (MINUS 40' OPENING)
DASHED 40+66 ~ 67+80
SOLID 43+85 ~ 45+15 (LANE LINE)
SOLID 63+60 ~ 65+15 (LANE LINE)

646.36 - TEMPORARY 4" REFLECTORIZED YELLOW LINES

SOLID { SOUTHBOUND 40+66 ~ 74+00 (MINUS 80' FOR OPENINGS)
{ NORTHBOUND 71+00 ~ 74+00

202.18 REMOVAL OF EXISTING PAVEMENT MARKING

NORTHBOUND 71+00 ~ 74+00
SOUTHBOUND 69+72 ~ 74+00

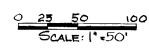

NOTE: STATIONING IS BASED ON ROUTE-LOG STATIONS.

DATUM

VERTICAL _____

HORIZONTAL _____

SURVEYED BY _____ DATE _____

DRAWN BY P.M. FELKEY DATE 4-9-84

TRACED BY _____ DATE _____

PAVEMENT MARKING
ST. JOHNSBURY (SB)
PROJ# HMA NO. 2525

SHEET 11 OF 11

VERMONT AGENCY
TRANSPORTATION
PHASE-III INTERSTATE
HANGER 4077

1984

Pavement Marking - St. Johnsbury (5B)
HMA 2525

1984