


TYPICAL SECTIONS & DESIGN DATA

ITEM 406.25 BITUMINOUS CONCRETE PAVEMENT.
 LEVELING COURSE 200 TONS/MILE
 1-1/2" WEARING COURSE TYPE III 22' WIDE ($\pm 1/4$ ")
 1-1/2" PAVED SHOULDERS 4' WIDE (SEE SHEET 4 FOR SHOULDER
 CONSTRUCTION DETAILS)

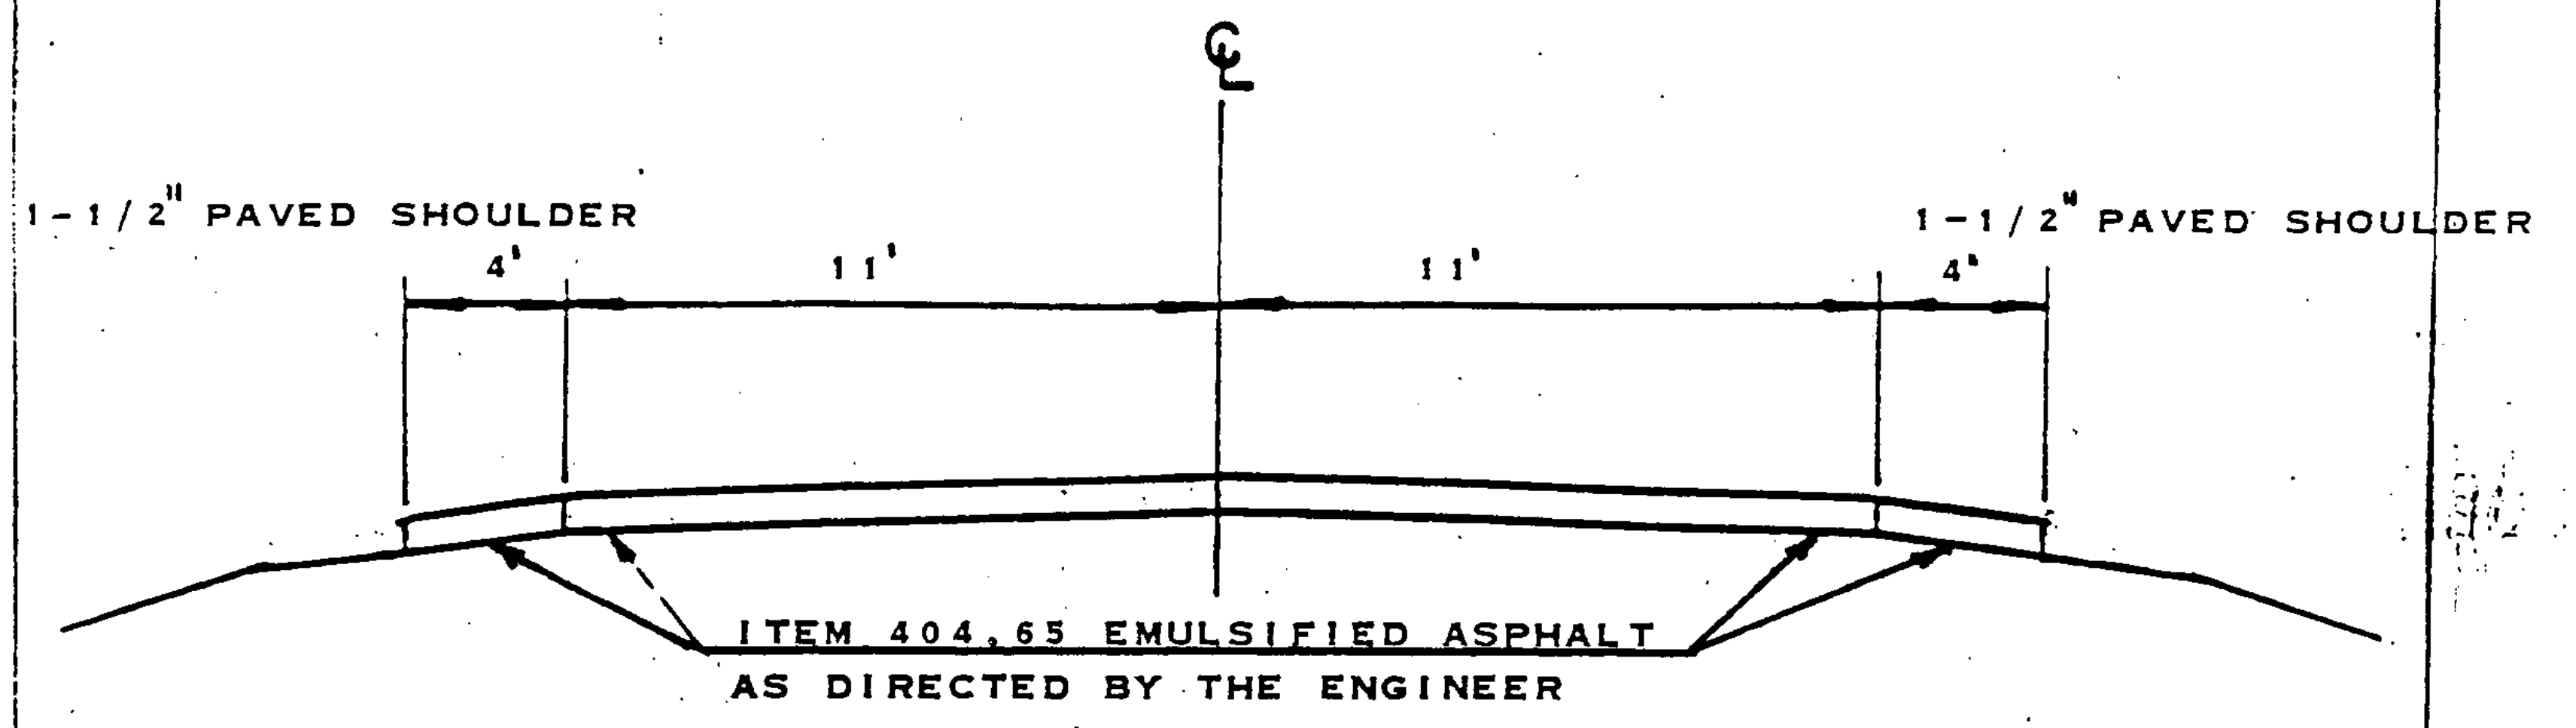

BEGIN PROJECT MALLETT'S BAY AVENUE MM 0.00
 END PROJECT LAVIGNE ROAD MM 0.70
 0.70 MILE OR 3696 FEET

URBAN GRASS SEED FORMULA

%WT	LBS/A	
37.50	30	CREEPING RED FESCUE
31.25	25	KENTUCKY BLUEGRASS
<u>31.25</u>	<u>25</u>	PERENNIAL RYE GRASS
100.0	80	

GENERAL NOTES:

SEED TO BE APPLIED PER SEEDING FORMULA OR AS DIRECTED BY THE ENGINEER. FERTILIZER-FORMULA 10-20-10 TO BE USED WITH SEED, APPLIED AT A RATE OF 500 LBS/ACRE OR AS DIRECTED BY THE ENGINEER.

HAY MULCH TO BE PLACED ON EARTH SLOPES AT THE RATE OF 2 TONS/ACRE OR AS DIRECTED BY THE ENGINEER.

TOPSOIL TO BE USED WITH SEED AS INDICATED ON THE PLANS OR AS DIRECTED BY THE ENGINEER

AGRICULTURAL LIMESTONE TO BE APPLIED AT RATE OF 2 TONS PER ACRE OR AS DIRECTED BY THE ENGINEER.

PROJECT COLCHESTER

NO. M 5600 (3)S
 SHEET 3 OF 18