


PLAN DETAILS - INTERSECTIONS

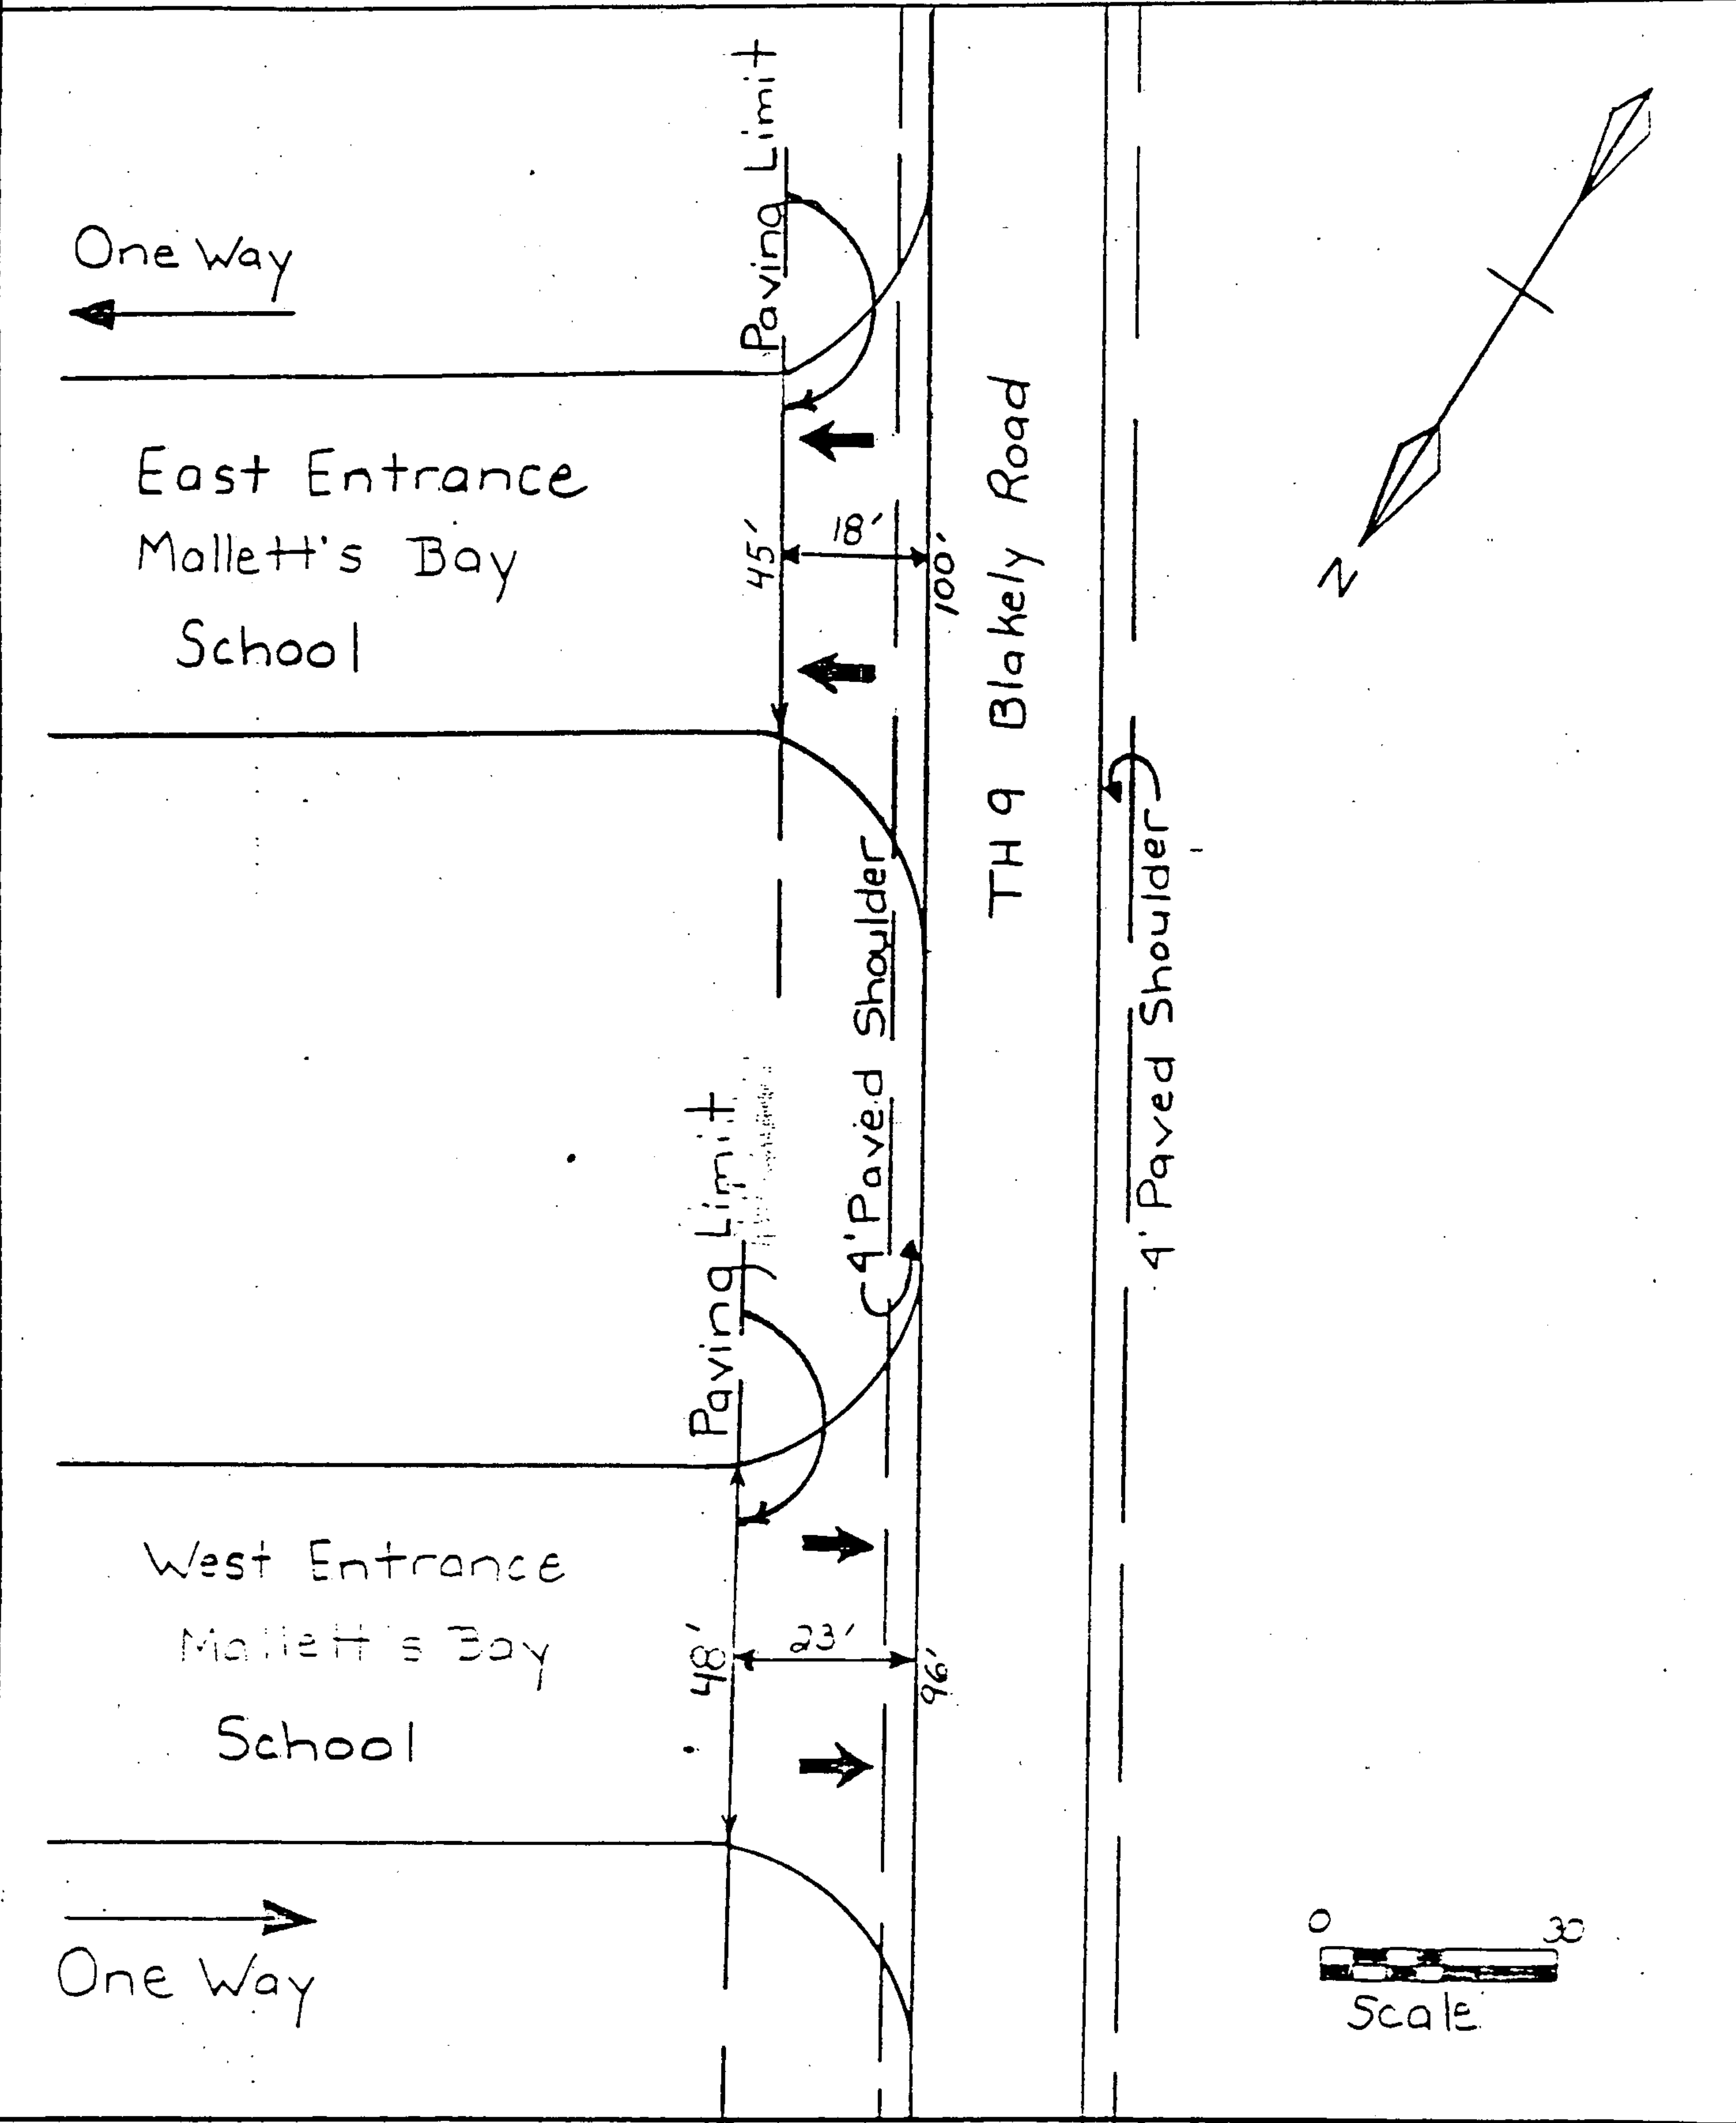

PROJECT Colchester

NO. M 5600(3)S
SHEET 7 OF 18 SHEETS