


Note:

Pavement markings to be reviewed by the Resident Engineer and placed accordingly.

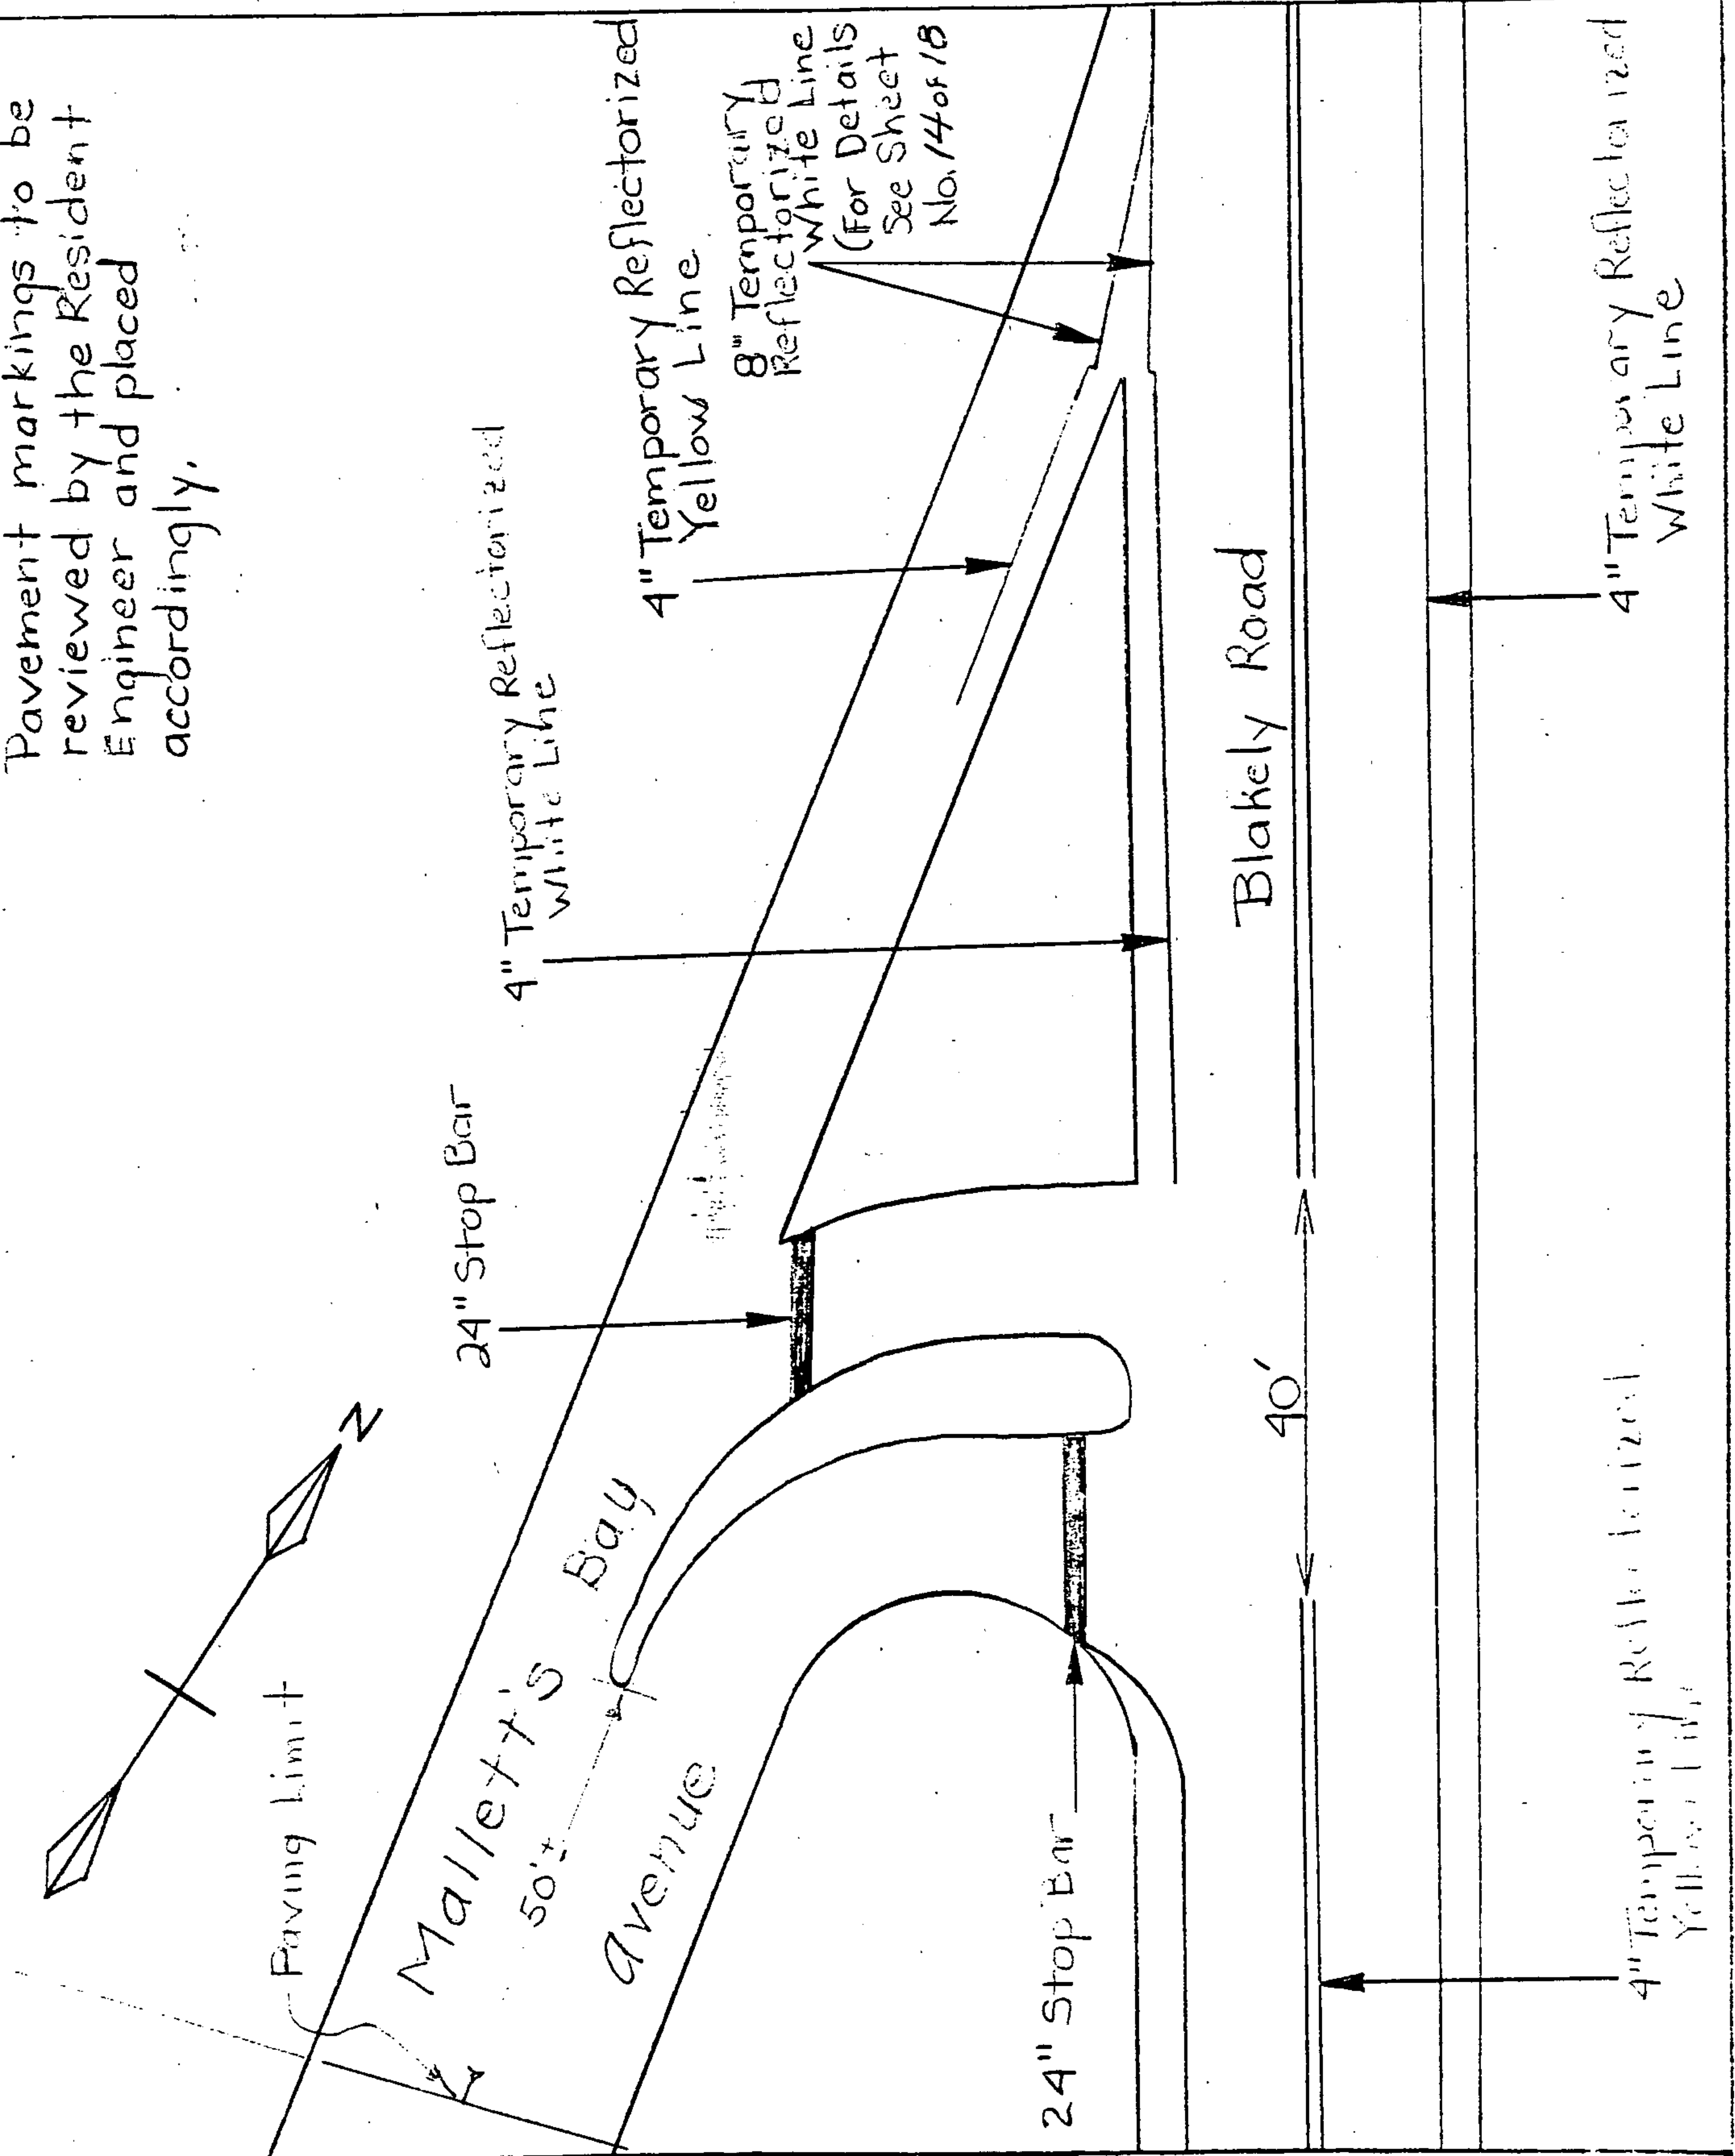

PROJECT Colchester

NO. M 5600(3) B

SHEET 8 OF 18 SHEETS