


Lavigne Road Approach

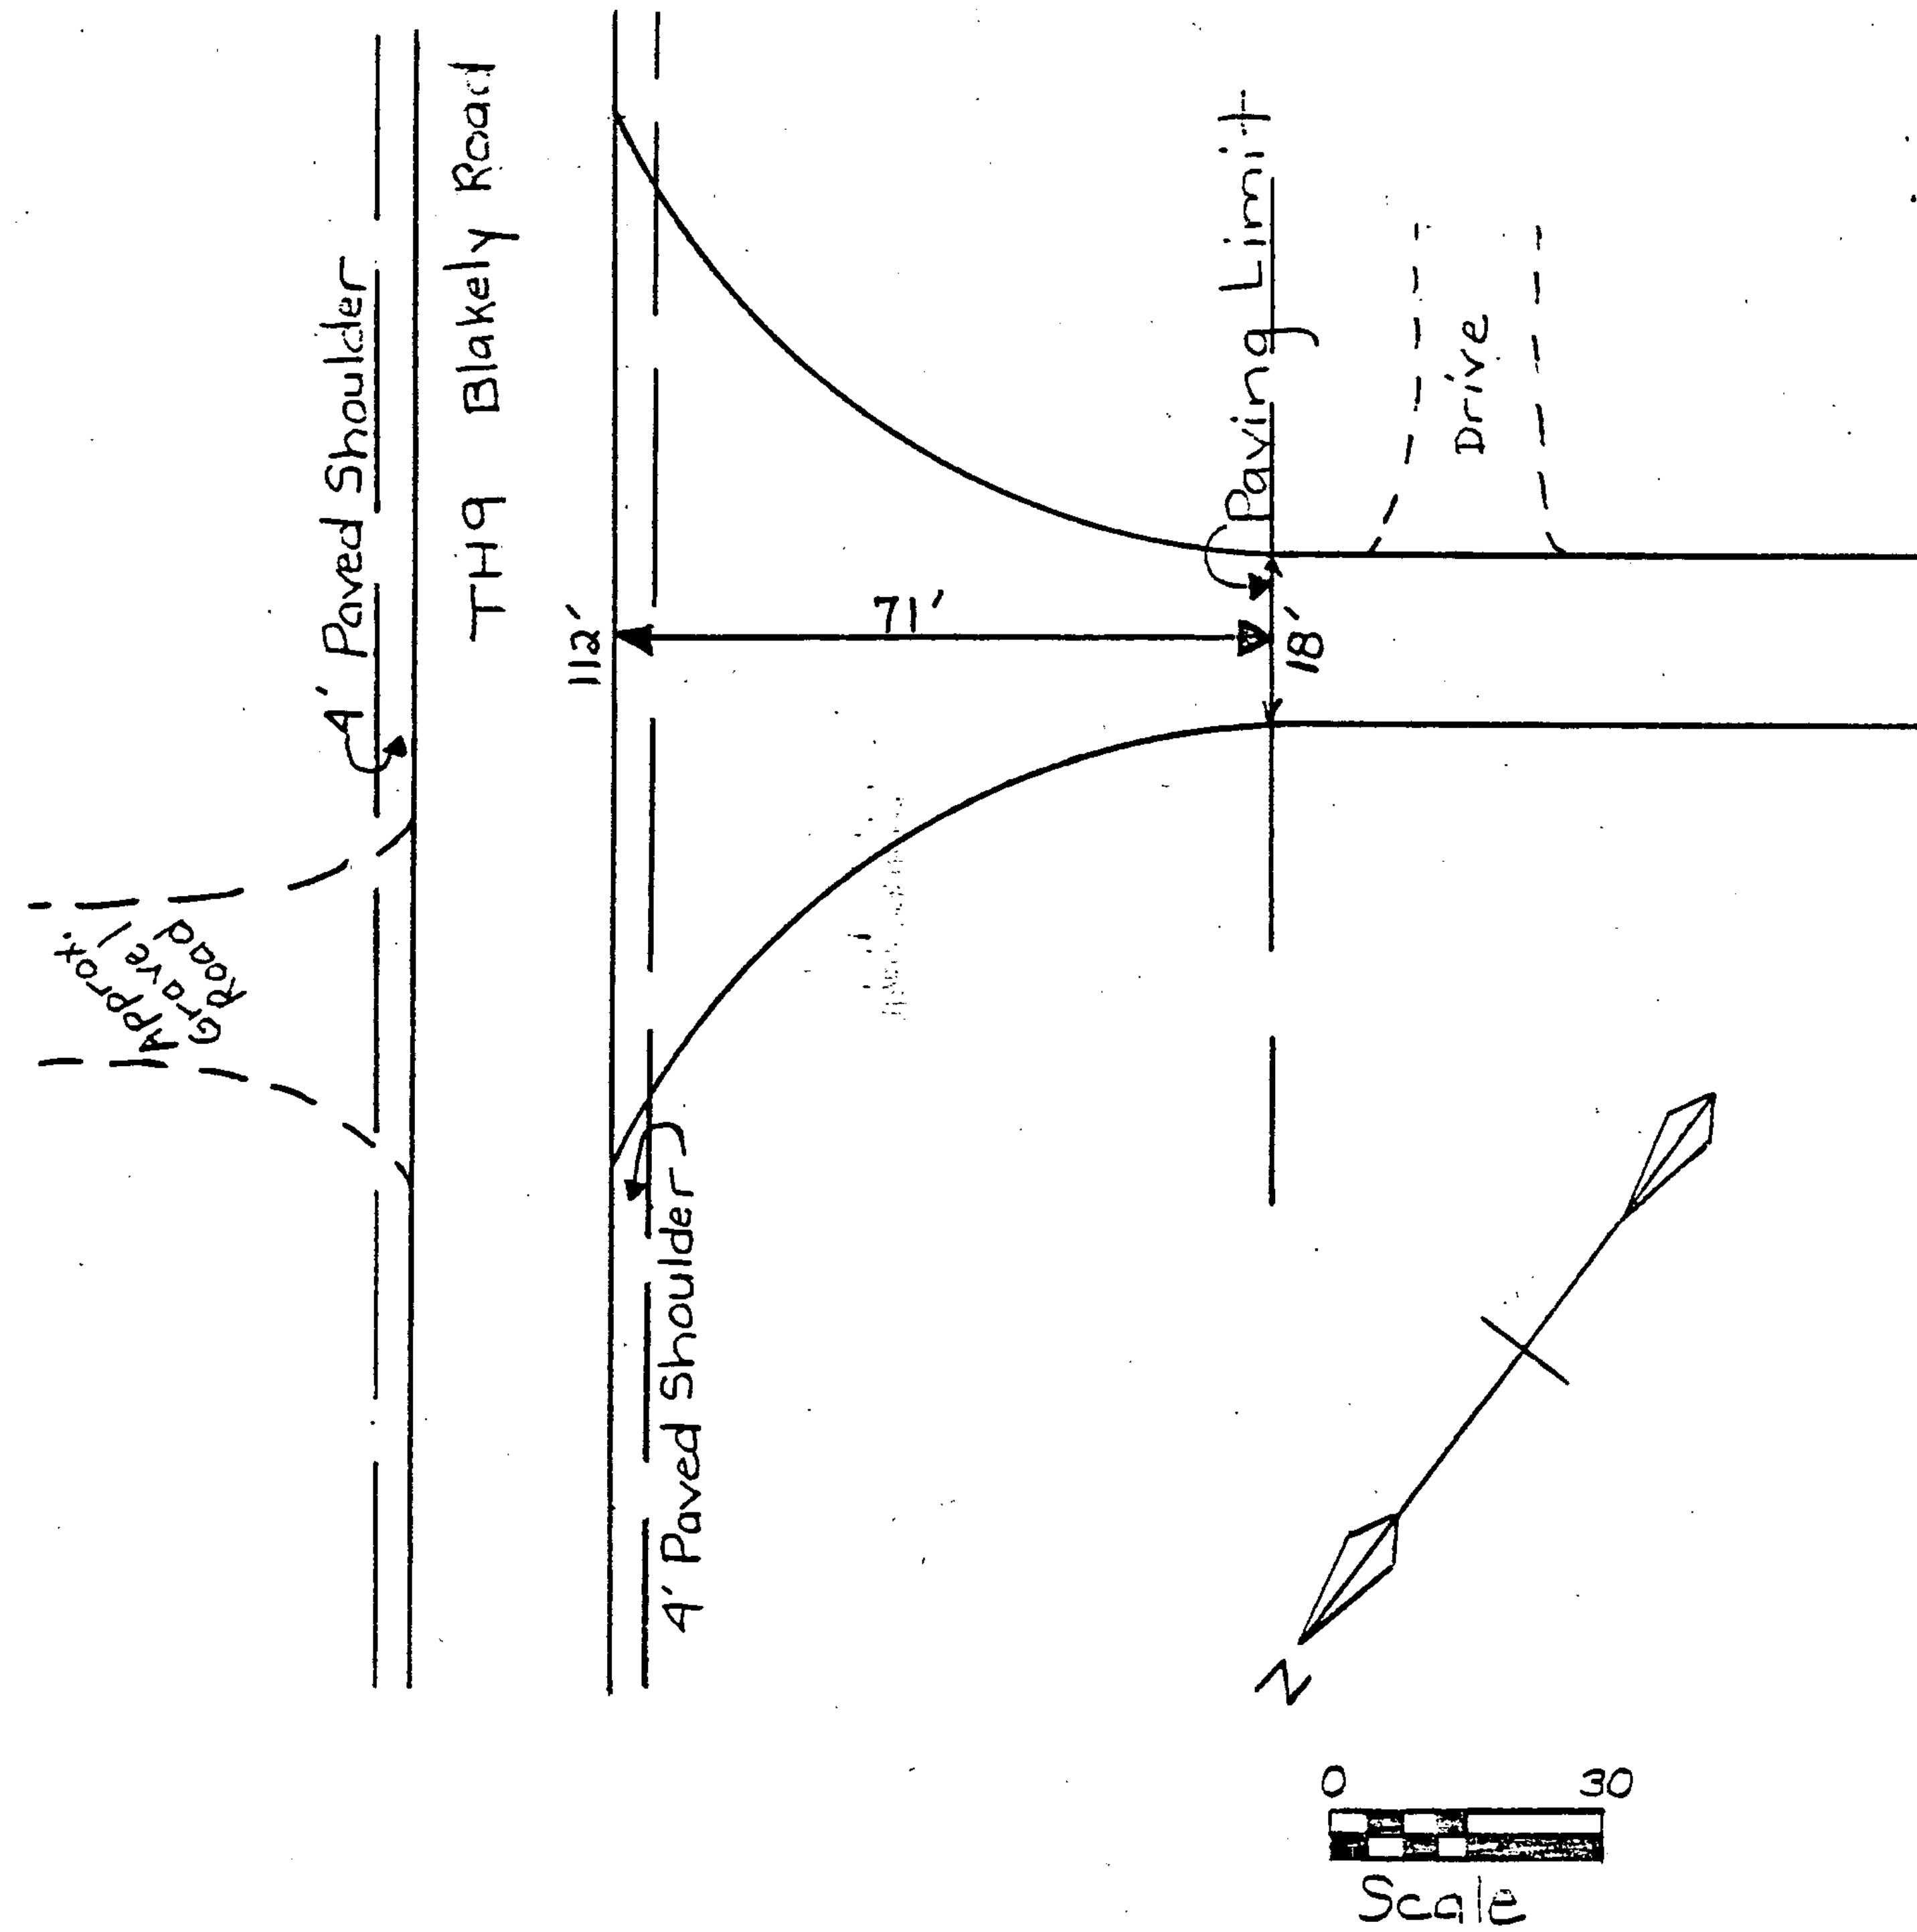

PROJECT Colchester

NO. M 5600 (3) S

SHEET 9 OF 18 SHEETS