

GRANITE BRICK PAVING (GUTTERS)  
 REV. STA. 98+00 LT. ~ FAIR. ST. STA. 80+55 LT.  
 FAIR. ST. STA. 80+55 RT. ~ STA. 103+50 LT.  
 REV. STA. 98+00 RT. ~ STA. 103+50 RT.

NOTE: UNDERDRAIN OFFSET MAYBE ADJUSTED AS NEEDED TO AVOID CONFLICT WITH UTILITIES AS APPROVED BY THE ENGINEER.

THE ACTUAL LOCATION OF THE DROP INLET @ 100+08 RT. MAYBE ADJUSTED IN THE FIELD TO AVOID CONFLICT WITH THE SEWER MANHOLE AT THAT STATION AS DIRECTED BY THE ENGINEER.

CONCRETE MANHOLE WITH CAST IRON COVER (MOD)  
 STA. 100+08 RT.  
 STA. 101+44 RT.  
 STA. 102+64 RT.


5" PORTLAND CEMENT CONCRETE SIDEWALK  
 REV. STA. 99+98 RT. ~ REV. STA. 100+24 RT.  
 REV. STA. 100+38 RT. ~ REV. STA. 101+08 RT.  
 REV. STA. 101+20 RT. ~ REV. STA. 101+86 RT.  
 REV. STA. 101+96 RT. ~ STA. 103+50 RT.

8" PORTLAND CEMENT CONCRETE SIDEWALK  
 REV. STA. 100+19 RT. ~ REV. STA. 100+43 RT.  
 REV. STA. 101+03 RT. ~ REV. STA. 101+25 RT.  
 REV. STA. 101+91 RT. ~ REV. STA. 102+01 RT.

STA. 102+98 LT.  
 REMOVE & RESET MARBLE WALK AS DIRECTED BY THE ENGINEER AS AGREED TO BY THE PROPERTY OWNER  
 PAYMENT SUBSIDIARY TO COMMON EXCAVATION

NOTE: TEMPORARY EROSION CONTROL METHODS AS PER STANDARD SHEETS T-1 & T-2 ARE TO BE USED ON THIS PROJECT AS APPROVED AND DIRECTED BY THE ENGINEER.

DROP INLETS AT STATIONS 101+95 RT. AND 104+50 RT. ARE TO BE INSTALLED TO AVOID DISTURBING THE EXISTING 8" SEWER LINE IF POSSIBLE. A QUANTITY OF RELAYING SEWER PIPE HAS BEEN ESTIMATED TO ALLOW RELOCATION OF THE SEWER LINE IF NECESSARY.

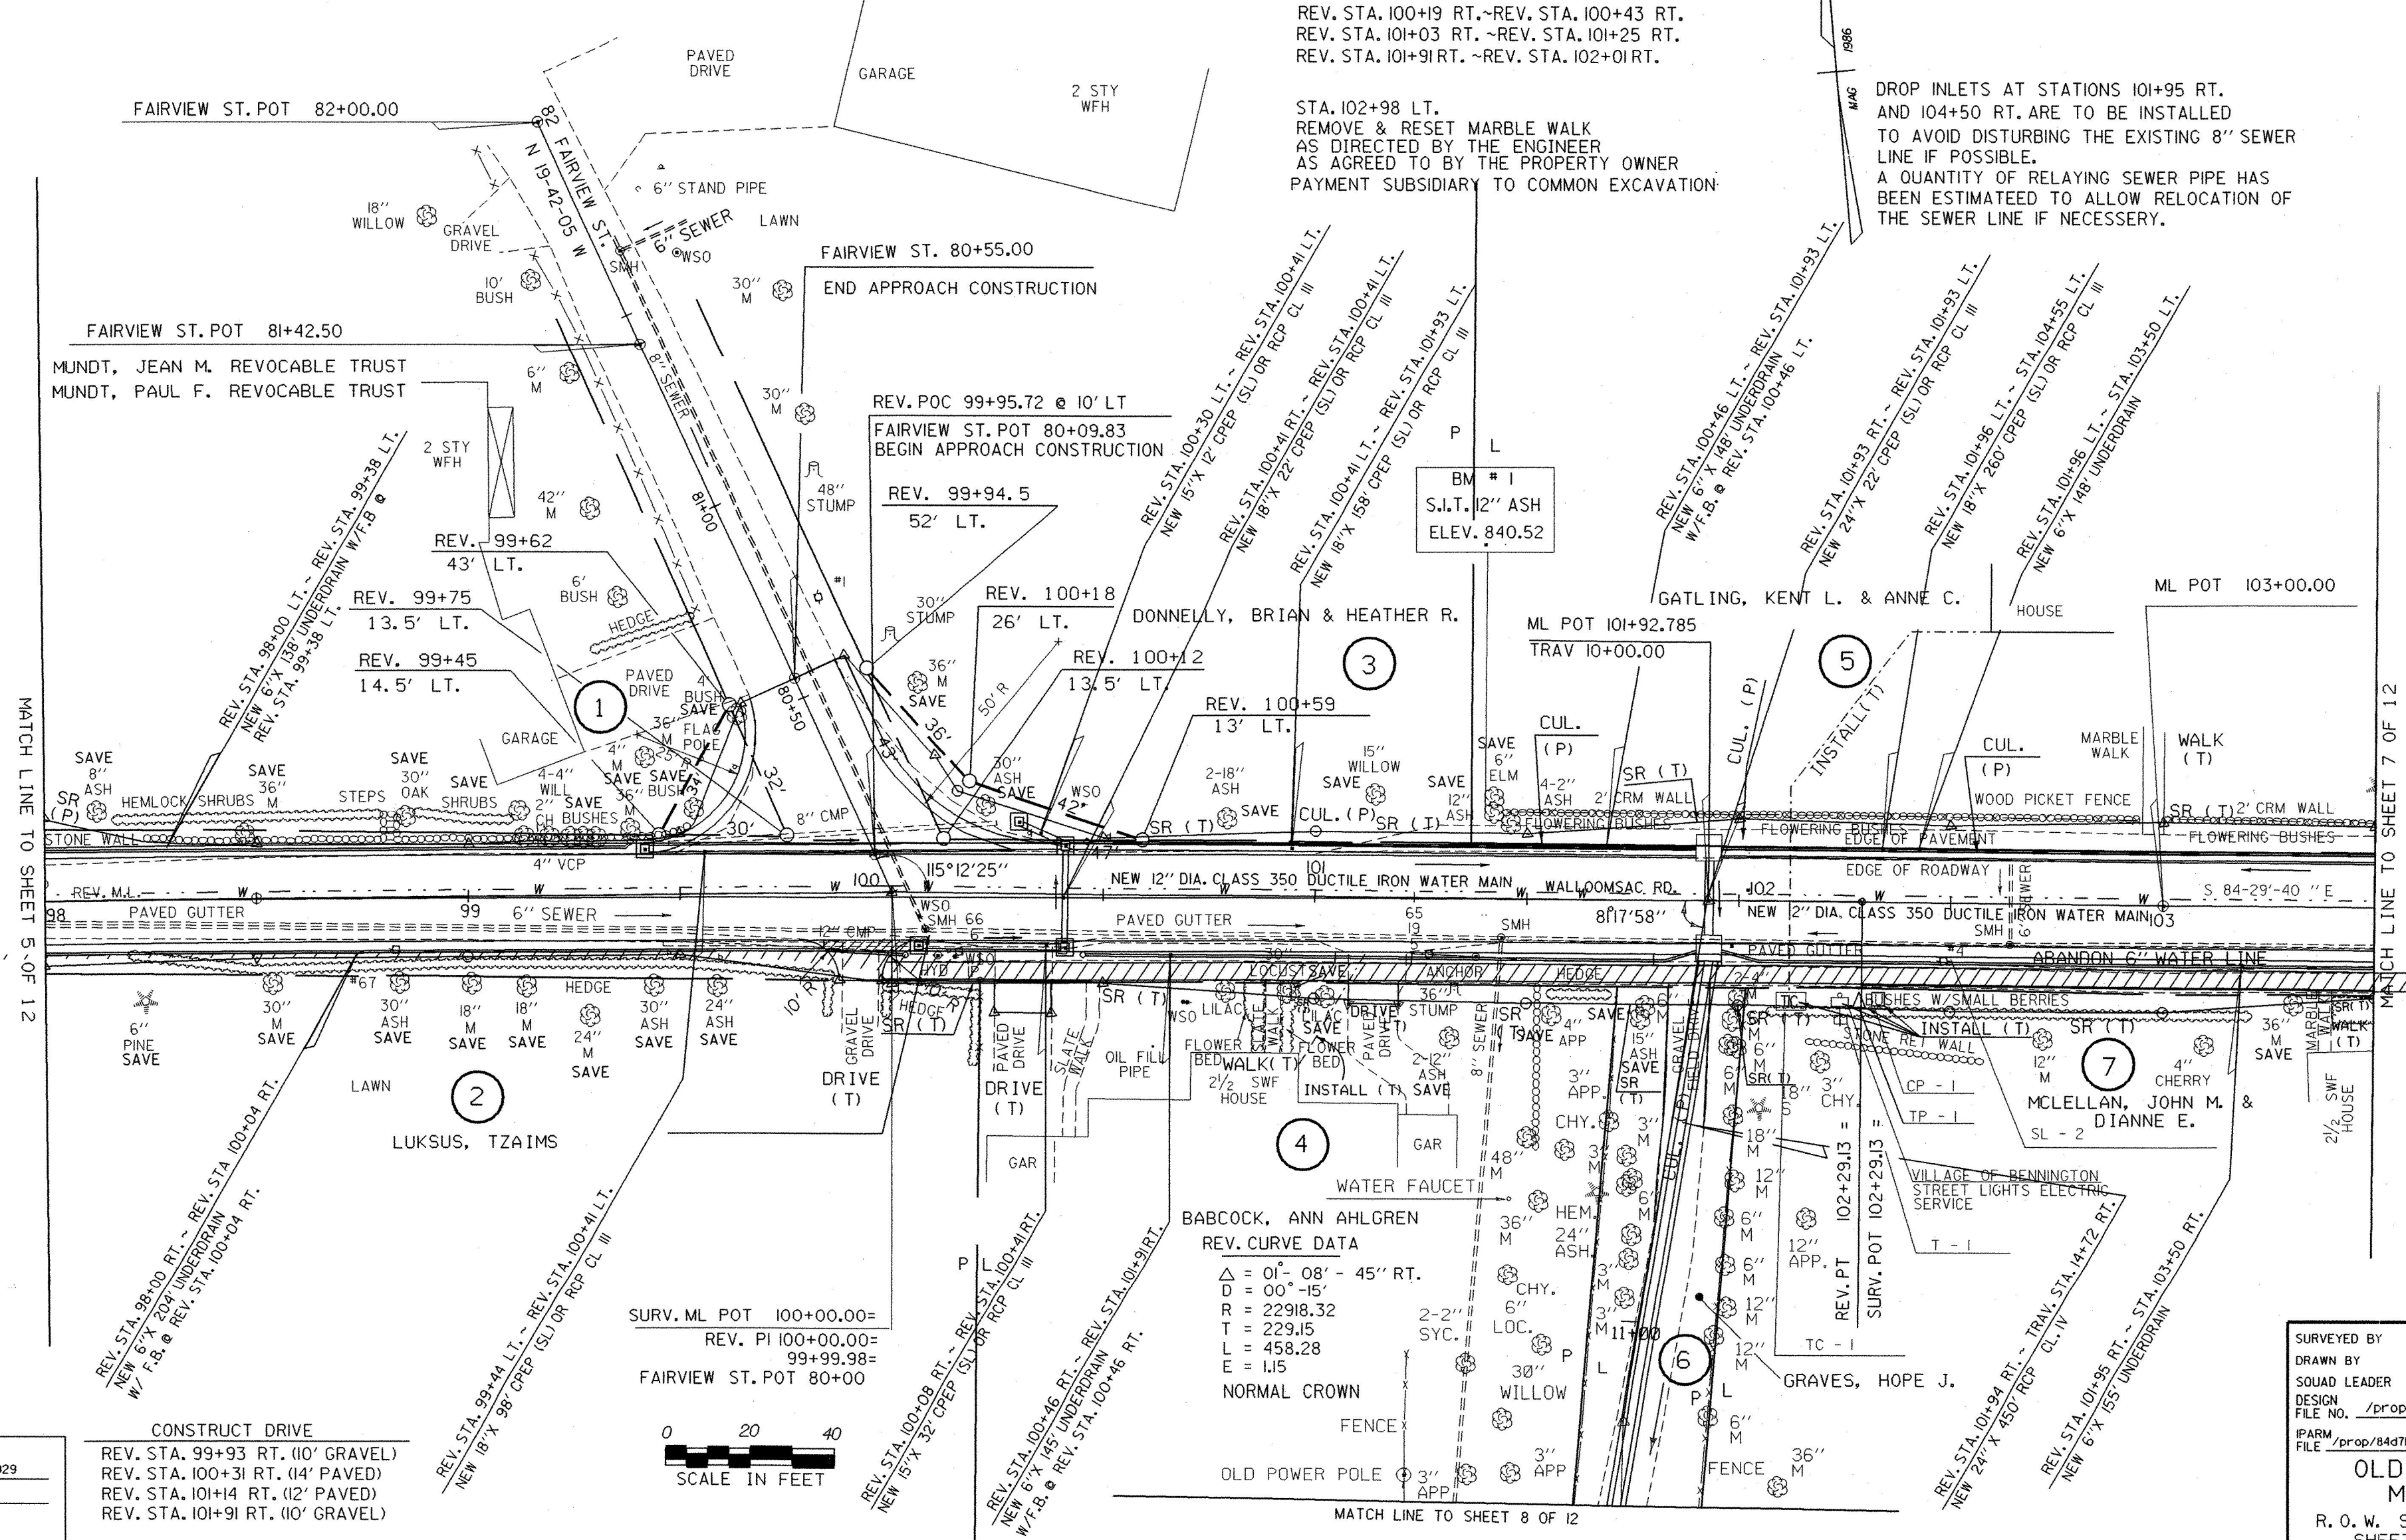


MATCH LINE TO SHEET 5 OF 12

MATCH LINE TO SHEET 7 OF 12

MATCH LINE TO SHEET 8 OF 12

DATUM	
VERTICAL	NGVD 1929
HORIZONTAL	N/A

CONSTRUCT DRIVE  
 REV. STA. 99+93 RT. (10' GRAVEL)  
 REV. STA. 100+31 RT. (14' PAVED)  
 REV. STA. 101+14 RT. (12' PAVED)  
 REV. STA. 101+91 RT. (10' GRAVEL)

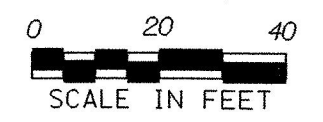

**FOR R.O.W. USE ONLY**

SURVEYED BY	MOREAU	DATE	1/86
DRAWN BY	A. JONES	DATE	6/22/93
SQUAD LEADER	S. MENARD		
DESIGN FILE NO.	/prop/84d714/rd714zz.dgn		
DATE PLOTTED	28-APR-1999		
<b>OLD BENNINGTON</b>			
<b>M 1400(4) S</b>			
R. O. W. SHEET 6 OF 12 SHEETS			
SHEET 12 OF 63 SHEETS			