

MATCH LINE TO SHEET 6 OF 12

ML POT 107+47.62 =
MONUMENT AVE. POT 55+52.75
PROJECT M 1400 (2) (1990)


107+47.62
GUTTERS & SIDEWALK
END APPROACH M 1400(4)S

NOTE: TEMPORARY EROSION CONTROL
METHODS AS PER STANDARD SHEETS
T-1 & T-2 ARE TO BE USED ON THIS
PROJECT AS APPROVED AND DIRECTED BY
THE ENGINEER.

CONCRETE MANHOLE WITH CAST IRON COVER (MOD)
STA. 104+32 RT.

NOTE: UNDERDRAIN OFFSET MAYBE ADJUSTED AS
NEEDED TO AVOID CONFLICT WITH UTILITIES
AS APPROVED BY THE ENGINEER.

DATUM	
VERTICAL	NGVD 1929
HORIZONTAL	N/A

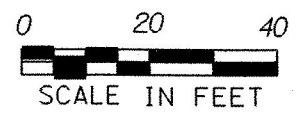

GRANITE BRICK PAVING (GUTTER)
STA. 103+50 LT. ~ STA. 105+99 LT.
STA. 103+50 RT. ~ STA. 107+07 RT.
STA. 107+12 RT. ~ STA. 107+45 RT.

NOTE: THE HEATING TAPE SHOWN AT
THE DRIVE AT STA. 104+36 RT. IS NO
LONGER USED AND NEED NOT BE PROTECTED
OR REPLACED.

END R. O. W. PROJECT
STA. 106+80 25' RT.

SURVEYED BY	MOREAU	DATE	1/86
DRAWN BY	A. JONES	DATE	6/20/93
SQUAD LEADER	S. MENARD		
DESIGN FILE NO.	/prop/84d714/rd71413r.dgn		
IPARM FILE	/prop/84d714/rd71413r.j	DATE PLOTTED	28-APR-1999
OLD BENNINGTON M 1400(4)S R. O. W. SHEET 7 OF 12 SHEETS			