


MATCH LINE SHEET 8

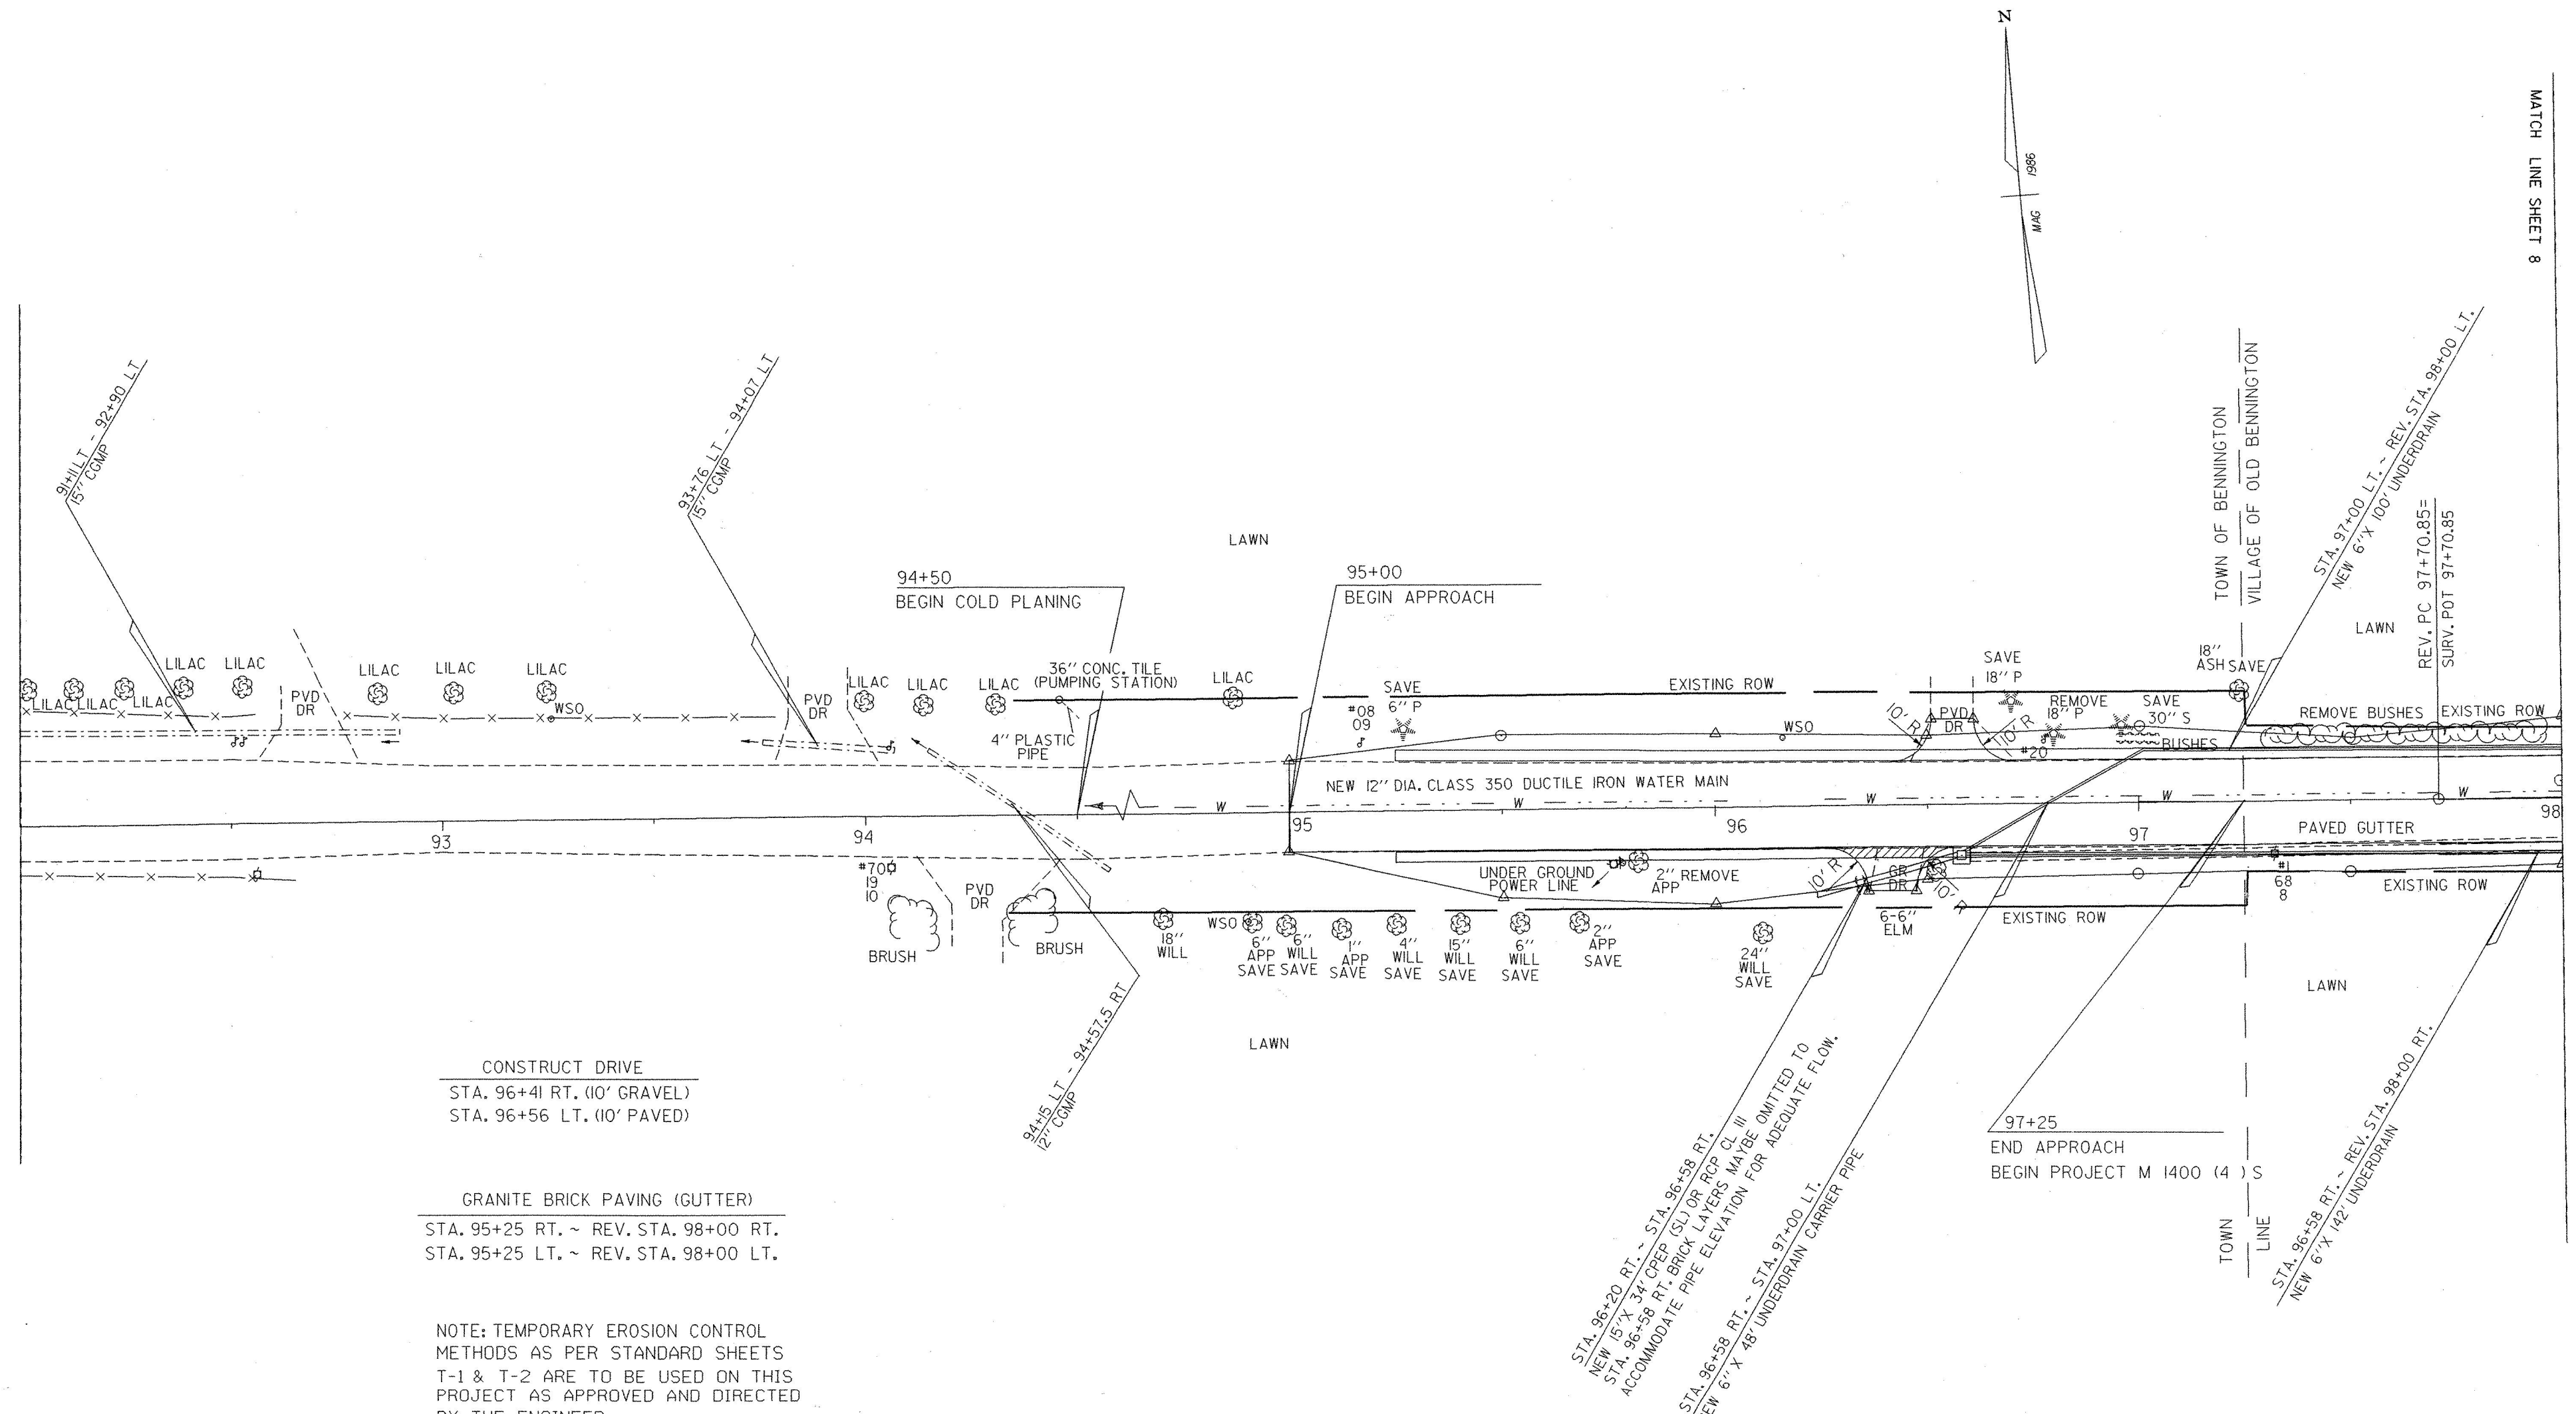


CONSTRUCT DRIVE
 STA. 96+41 RT. (10' GRAVEL)
 STA. 96+56 LT. (10' PAVED)

GRANITE BRICK PAVING (GUTTER)
 STA. 95+25 RT. ~ REV. STA. 98+00 RT.
 STA. 95+25 LT. ~ REV. STA. 98+00 LT.

NOTE: TEMPORARY EROSION CONTROL METHODS AS PER STANDARD SHEETS T-1 & T-2 ARE TO BE USED ON THIS PROJECT AS APPROVED AND DIRECTED BY THE ENGINEER.

NOTE: UNDERDRAIN OFFSET MAYBE ADJUSTED AS NEEDED TO AVOID CONFLICT WITH UTILITIES AS APPROVED BY THE ENGINEER

DATUM	
VERTICAL	NGVD 1929
HORIZONTAL	N/A

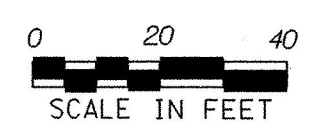

SURVEYED BY	MOREAU	DATE	1/86
DRAWN BY	A. JONES	DATE	6/20/93
SQUAD LEADER	S. MENARD		
DESIGN FILE NO.	/sqdc/84d714/dd714.dgn		
IPARM FILE	dd714011	DATE PLOTTED	28-APR-1999
PROJ. NAME	OLD BENNINGTON		
PROJ. NO.	M 1400 (4) S		
SHEET 15	OF 63	SHEETS	