

ML POT 107+47.62 =
MONUMENT AVE. POT 55+52.75
PROJECT M 1400 (2) (1990)

107+47.62
GUTTERS & SIDEWALK
END APPROACH M 1400(4)S

NOTE: TEMPORARY EROSION CONTROL
METHODS AS PER STANDARD SHEETS
T-1 & T-2 ARE TO BE USED ON THIS
PROJECT AS APPROVED AND DIRECTED
BY THE ENGINEER.

CONCRETE MANHOLE WITH CAST IRON COVER (MOD)
STA. 104+32 RT.

NOTE: UNDERDRAIN OFFSET MAYBE ADJUSTED AS
NEEDED TO AVOID CONFLICT WITH UTILITIES
AS APPROVED BY THE ENGINEER.

STA. 104+57 RT.
REMOVE & RESET MARBLE WALK
AS DIRECTED BY THE ENGINEER
AS AGREED TO BY THE PROPERTY OWNER.
PAYMENT SUBSIDIARY TO COMMON EXCAVATION

SIDEWALK RAMP
STA. 107+09 RT. (TYPE VI)

DRY RUBBLE MASONRY
STA. 105+40 RT. ± ~ STA. 105+56 RT. ±

DECIDUOUS SHRUBS AT STATION 104+52RT.
TO BE TRANSPLANTED OR REPLACED ON FILL SLOPE, AS
DIRECTED BY THE ENGINEER, AS AGREED TO BY THE
PROPERTY OWNER.

REMOVE & RESET CONC. POST
FROM STA. 106+01 LT. (6.5' LT.)
TO STA. 105+87 LT. (± 15' LT.)

CONSTRUCT DRIVE
STA. 103+72 LT. (15' PAVED)
STA. 104+05 RT. (14' PAVED)
STA. 104+30 LT. (20' PAVED)
STA. 104+36 RT. (22' PAVED)
STA. 105+26 RT. (12' GRAVEL)

GRANITE BRICK PAVING (GUTTER)
STA. 103+50 LT. ~ STA. 105+99 LT.
STA. 103+50 RT. ~ STA. 107+07 RT.
STA. 107+12 RT. ~ STA. 107+45 RT.


ML PI 106+21.59 =
SURV Δ = 4'-06'-50" LT.
END PROJECT M 1400 (4) S

5" PORTLAND CEMENT CONCRETE SIDEWALK
STA. 103+50 RT. ~ STA. 103+98 RT.
103.0 STA. 104+12 RT. ~ STA. 104+25 RT. 106.10
STA. 104+47 RT. ~ STA. 105+20 RT.
STA. 105+32 RT. ~ STA. 107+47.62 RT.
106.35 35

8" PORTLAND CEMENT CONCRETE SIDEWALK
STA. 104+03 RT. ~ STA. 104+17 RT.
STA. 104+30 RT. ~ STA. 104+52 RT.
STA. 105+25 RT. ~ STA. 105+37 RT.

NOTE: THE HEATING TAPE SHOWN AT
THE DRIVE AT STA. 104+36 RT. IS NO
LONGER USED AND NEED NOT BE PROTECTED
OR REPLACED.

DATUM	
VERTICAL	NGVD 1929
HORIZONTAL	N/A

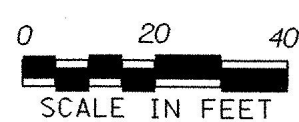

SURVEYED BY	MOREAU	DATE	1/86
DRAWN BY	A. JONES	DATE	6/20/93
SQUAD LEADER	S. MENARD		
DESIGN FILE NO.	/USR/SODC/840714/DD714.dgn		
IPARM FILE	dd714i03.j	DATE PLOTTED	28-APR-1999
PROJ. NAME	OLD BENNINGTON		
PROJ. NO.	M 1400 (4) S		
SHEET 17	OF 63	SHEETS	