

97+25
END APPROACH
BEGIN PROJECT

95+00
BEGIN APPROACH

94+50
BEGIN COLD PLANING


PVI
96+50
825.11
150' VC
K 27
E=L05

PVC
95+75
EL. 824.56

PVR
97+25
829.84

+ 0.7400 %

+ 6.3150 %

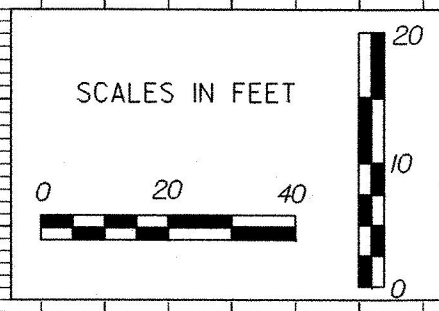

dd714pl 28-APR-1993

SURVEYED BY MOREAU DATE 1/86
DRAWN BY A. JONES DATE 6/15/93
DESIGN SUPERVISOR S. MENARD

OLD BENNINGTON
NO. M 1400 (4)S
SHEET 19 OF 63 SHEETS

92+00 93+00 94+00 95+00 96+00 97+00 98+00