




M.L. P.O.T. 100+00.00 =  
FAIRVIEW ST. P.O.T. 80+00.00

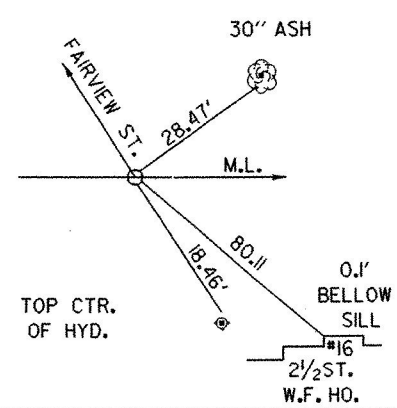


M.L. P.O.T. 103+00.00

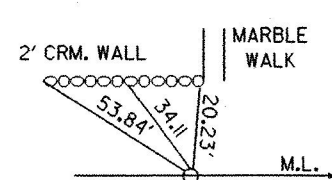


M.L. P.I. 106+21.59

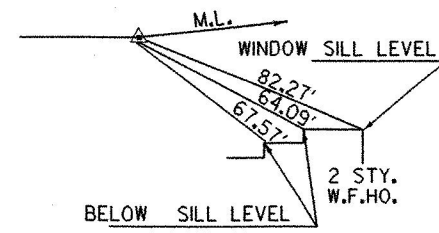


M. L. P.O.T. 107+47.62=  
MONUMENT AVE POT. 55+52.75

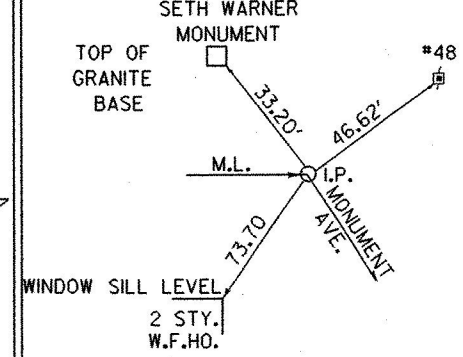




MONUMENT AVE. P.I. 45+94.47=  
45+93.67

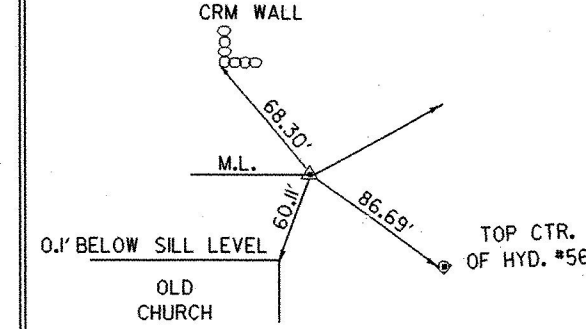

FAIRVIEW ST. P.O.T. 81+42.50

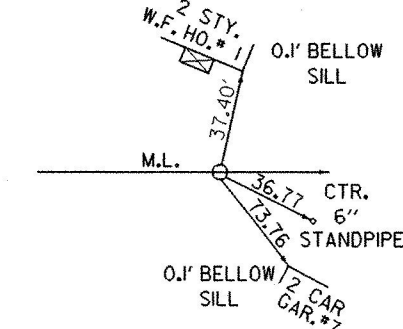

TRAV. P.O.T. 90+46.34

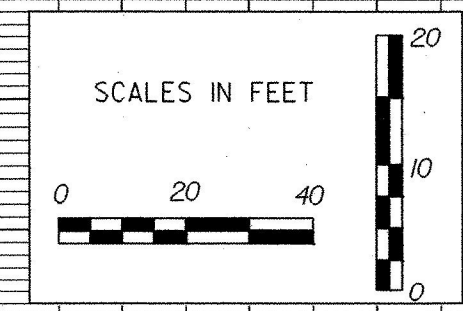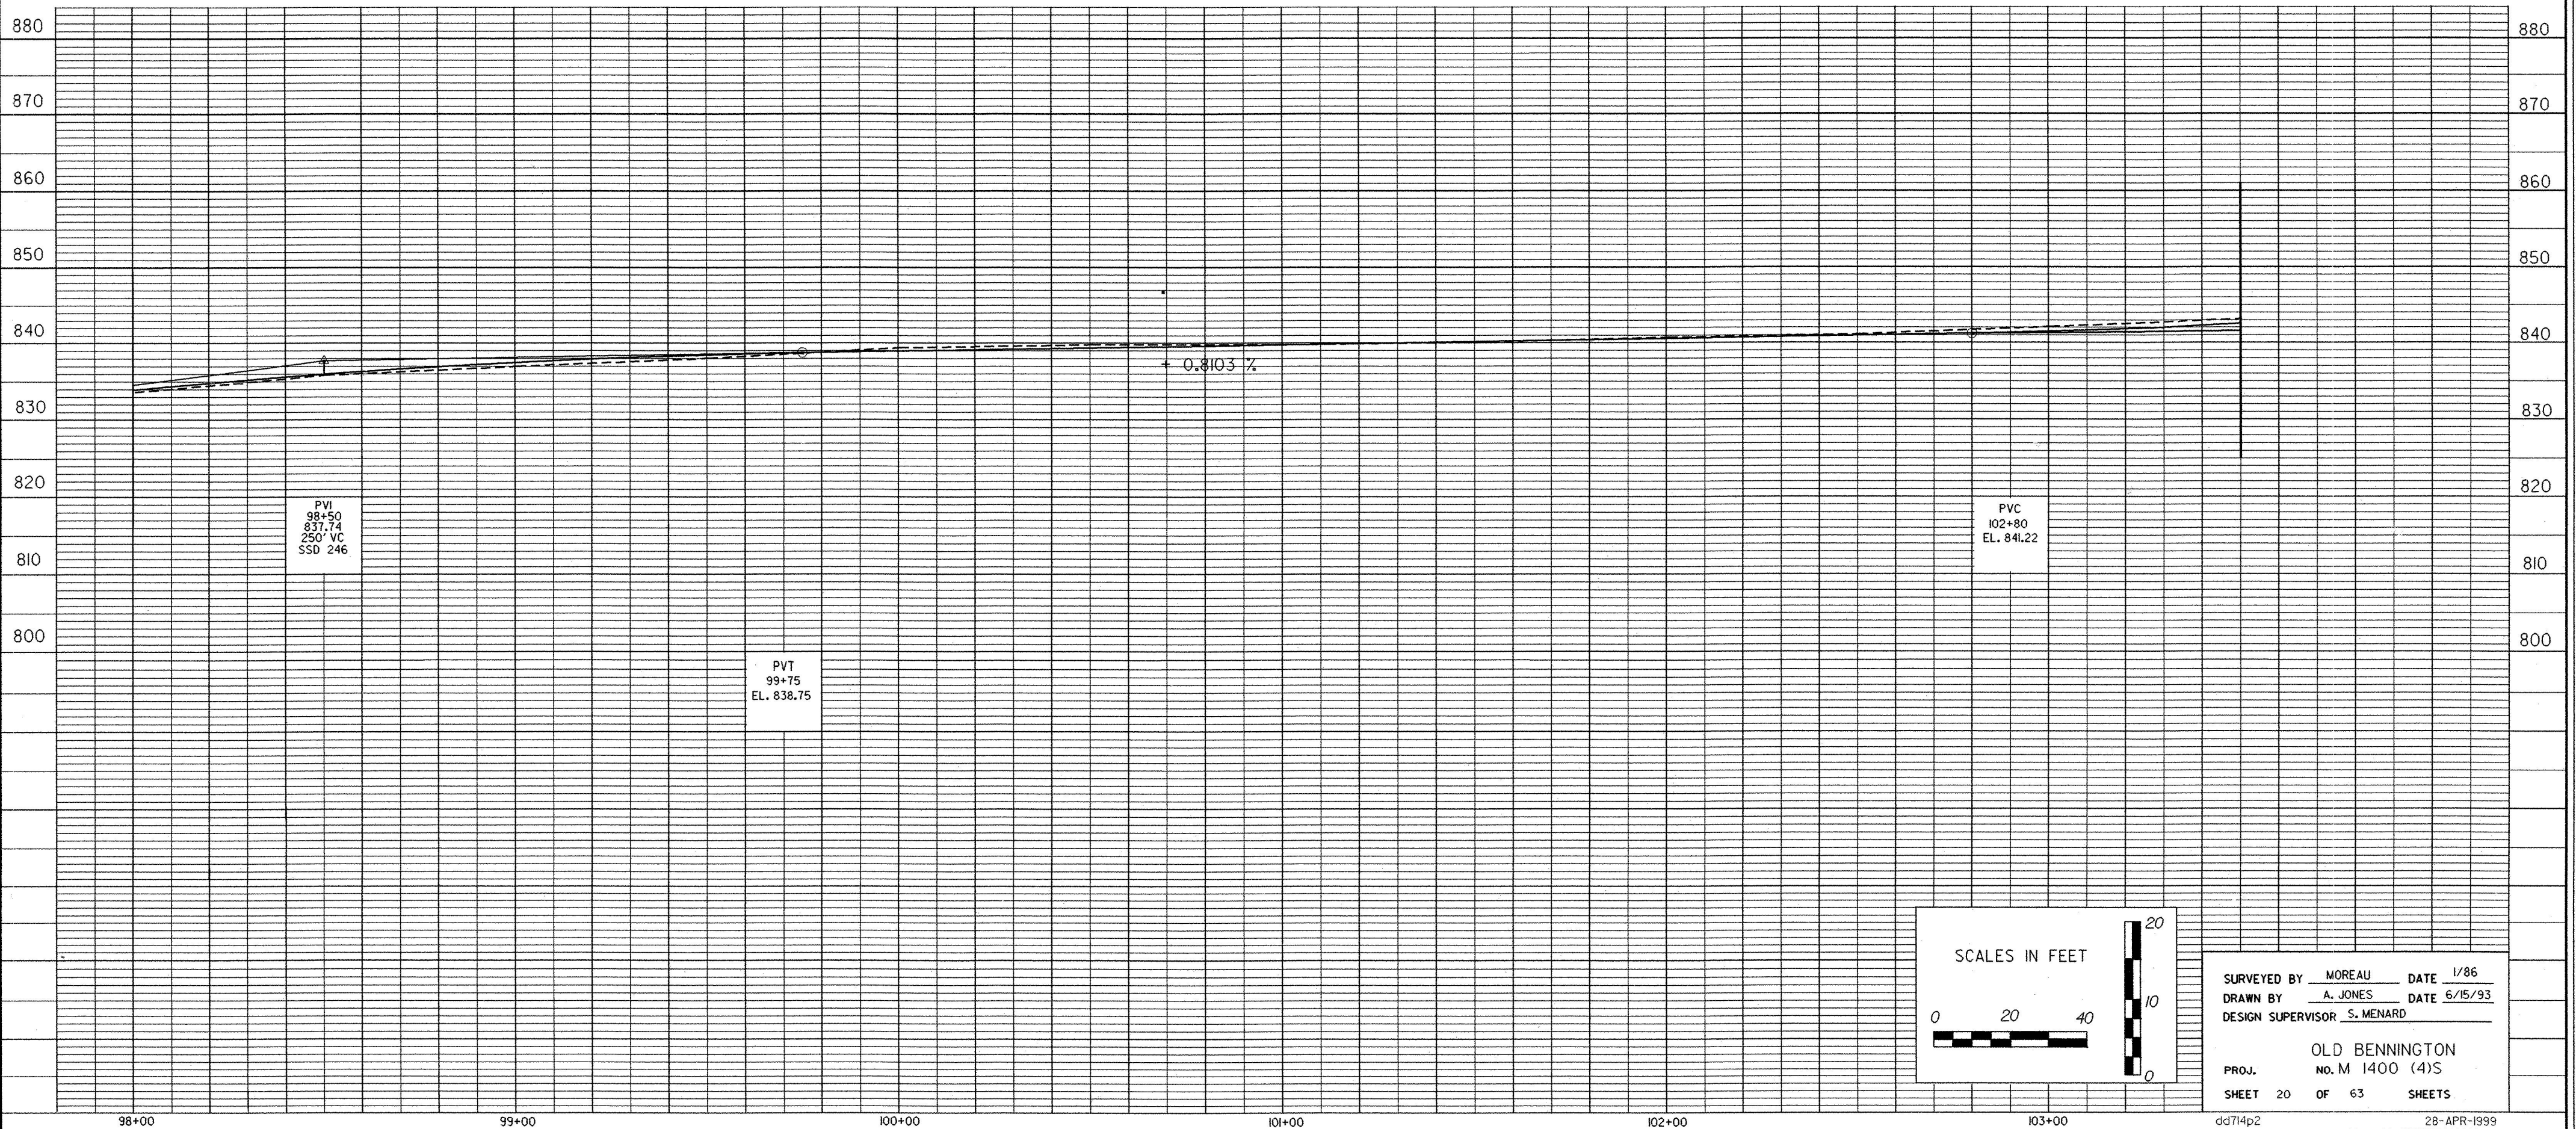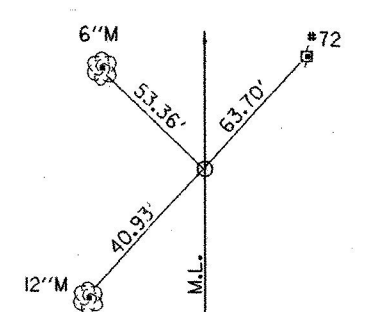

SURVEYED BY MOREAU DATE 1/86  
 DRAWN BY A. JONES DATE 6/15/93  
 DESIGN SUPERVISOR S. MENARD

OLD BENNINGTON  
 NO. M 1400 (4)S  
 PROJ. SHEET 20 OF 63 SHEETS

dd714p2 28-APR-1999