


1000
890
880
870
860
850
840
830
820
810
800

1000
890
880
870
860
850
840
830
820
810
800

103+50 104+00 105+00 106+00 107+00 107+50

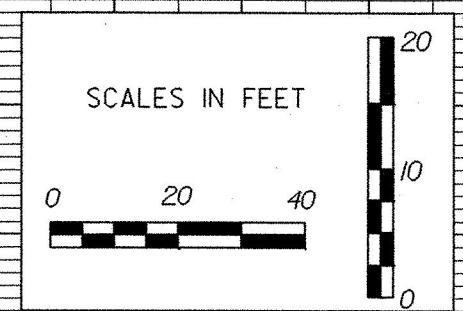

SURVEYED BY MOREAU DATE 1/86
 DRAWN BY A. JONES DATE 6/15/93
 DESIGN SUPERVISOR S. MENARD

OLD BENNINGTON
 PROJ. NO. M 1400 (4)S
 SHEET 21 OF 63 SHEETS