


M REV. 99+95.72 @ 10' LT. =
 FAIRVIEW ST. 80+09.83 EL. 838.71

+ 2.5345

PVI
 80+55
 839.90

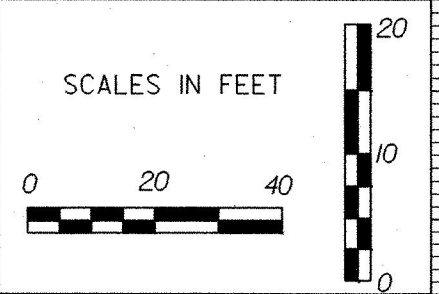

dd714p4 FAIRVIEW ST.

SURVEYED BY MOREAU DATE 1/86
 DRAWN BY A. JONES DATE 6/15/93
 DESIGN SUPERVISOR S. MENARD

OLD BENNINGTON
 PROJ. NO. M 1400 (4)S
 SHEET 22 OF 63 SHEETS

28-APR-1999

80+00 81+00 82+00