

TRENCH SECTION
 NOT TO SCALE

NOTES:
 ① PROVIDE 3\"/>

- PARTIAL LEGEND**
- 2\"/>


BENNINGTON BATTLE MONUMENT GROUNDS
 DEED REFERENCE RD SURVEY BK #1 pg 35
 EDWARD RICE, SURVEYOR REG. 18 DEC 1890

NOTE: THERE ARE AREAS OF DEED OVERLAPS OR GORES WHICH ARE PROBABLY THE RESULT OF THE NEWER SURVEYS NOT BEING TIED TO THE ORIGINAL 1890 SURVEY.

I HEREBY CERTIFY THAT THIS SURVEY WAS MADE ON THE GROUND BASED ON EXISTING MONUMENTATION WHICH IS CONSISTENT WITH THE RECORD DEEDS. (EXCEPT WHERE NOTED)

Rev.	Description	LAB	DATE
1			JULY 1998

OLD BENNINGTON
UTILITY PLAN
 MONUMENT CIRCLE

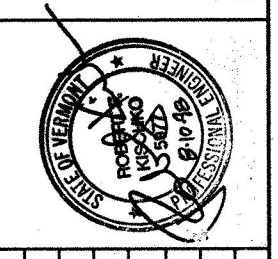

Project No.	20800010	Approved	MARCH 1998
Proj. Manager	R.F. KISCHKO	Date	07/25/98
Proj. Designer	L.A. BLACK		
Drawn By	R. FRENCH		
Checked By	R.F. KISCHKO		
Scale	AS SHOWN		