



835

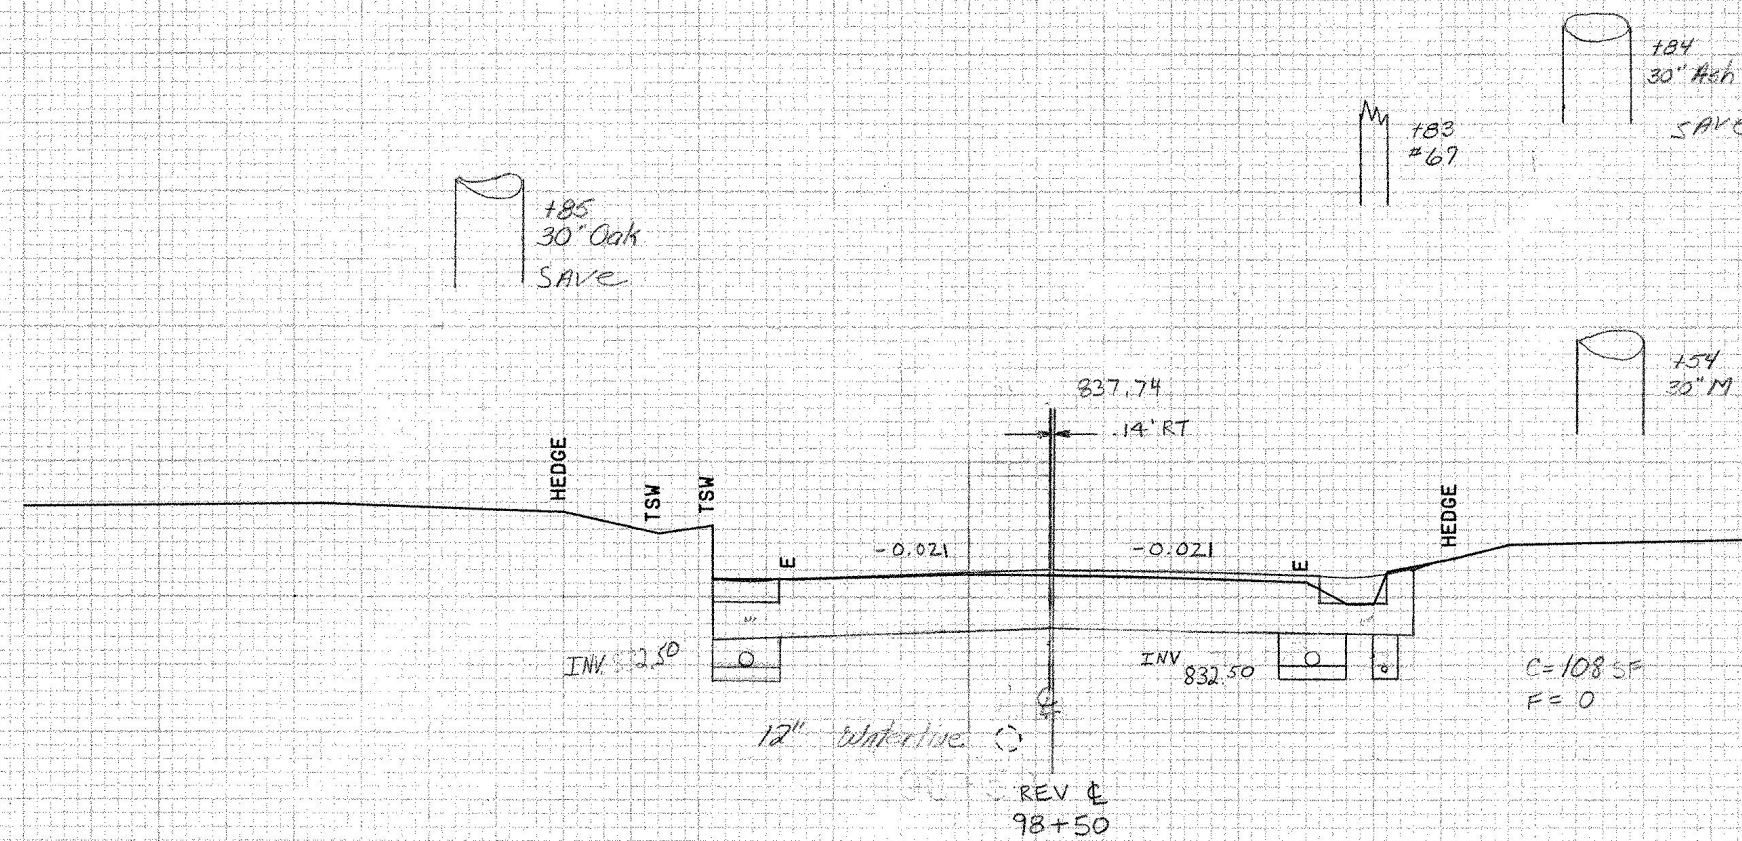

835

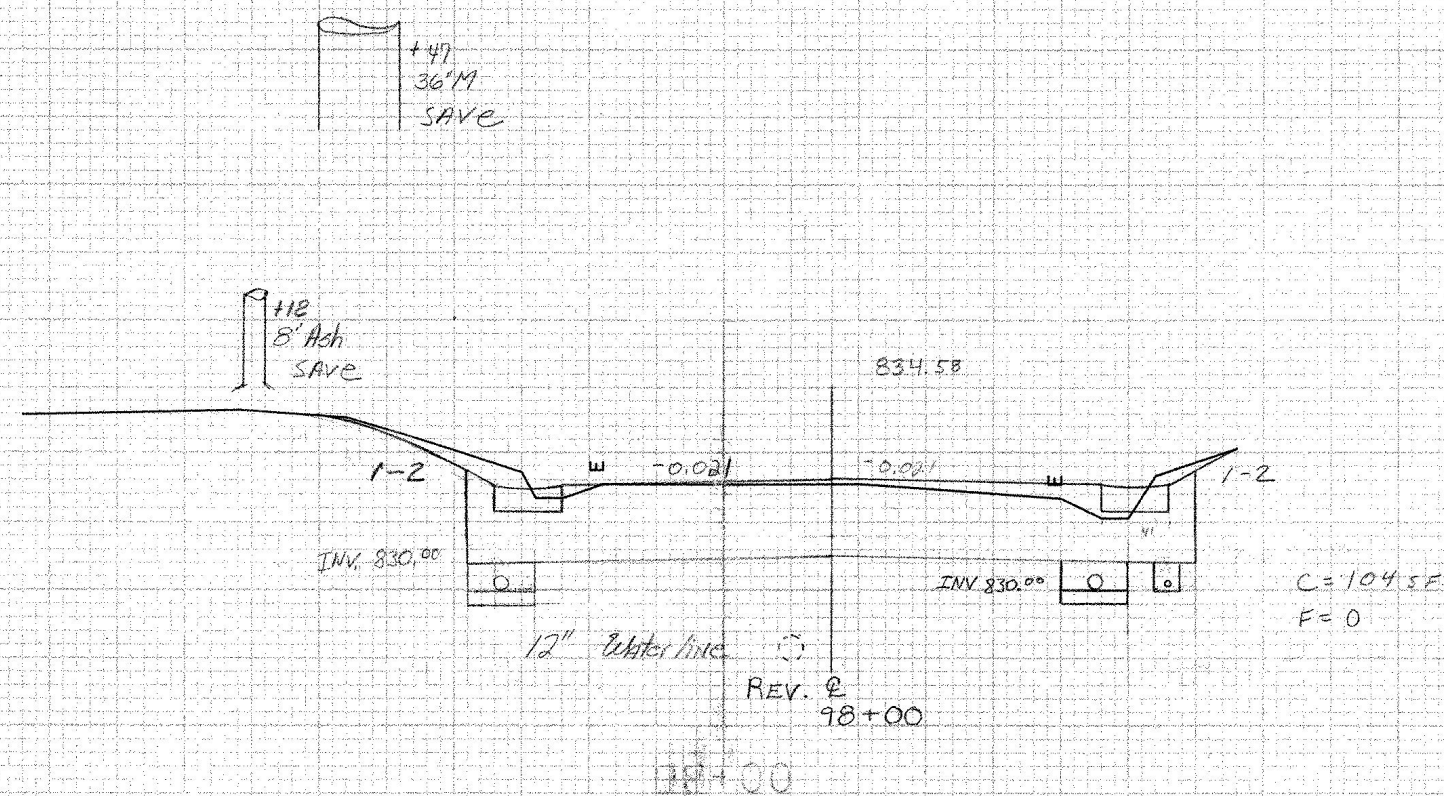

830

FROM STA. 98+00 TO STA. 99+00  
 PROJECT NAME OLD BENNINGTON  
 NO. M1400 (4) S  
 SURVEYED BY MOREAU  
 SHEET 42 OF 63 SHEETS  
 PLOTTED 02/24/86  
 JAN. 1986

SCALE 1" = 5' FEET