


191  
6" Hem.

191  
1" Ash

190  
12" M  
SAVR

188  
18  
S

156  
36" Sp.

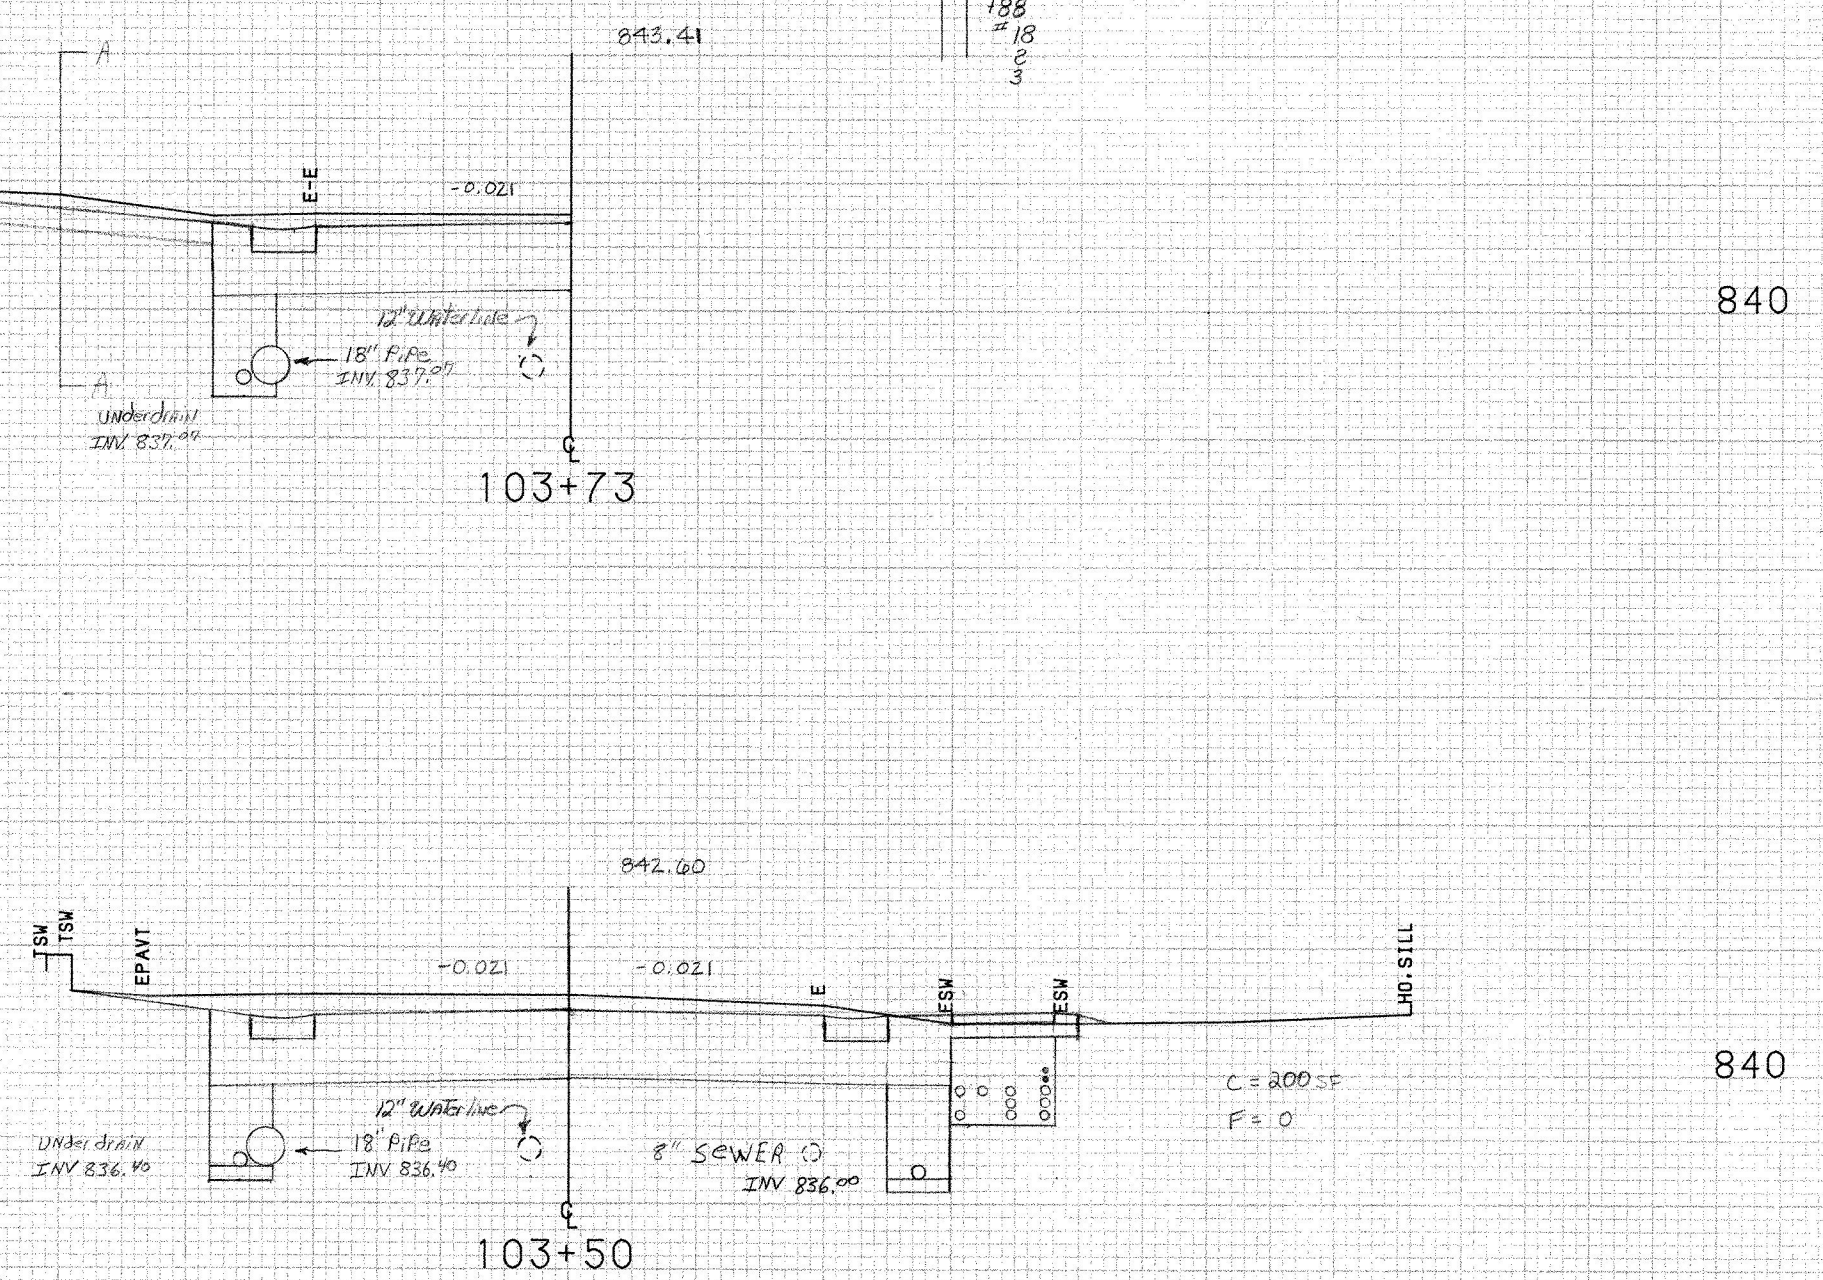

FROM STA. 103+50 TO STA. 104+00  
 PROJECT NAME OLD BENNINGTON  
 NO. M1400(4)S PLOTTED 02/24/86  
 SURVEY'D BY MOREAU JAN. 1986  
 SHEET 50 OF 63 SHEETS

SCALE 5 FEET