

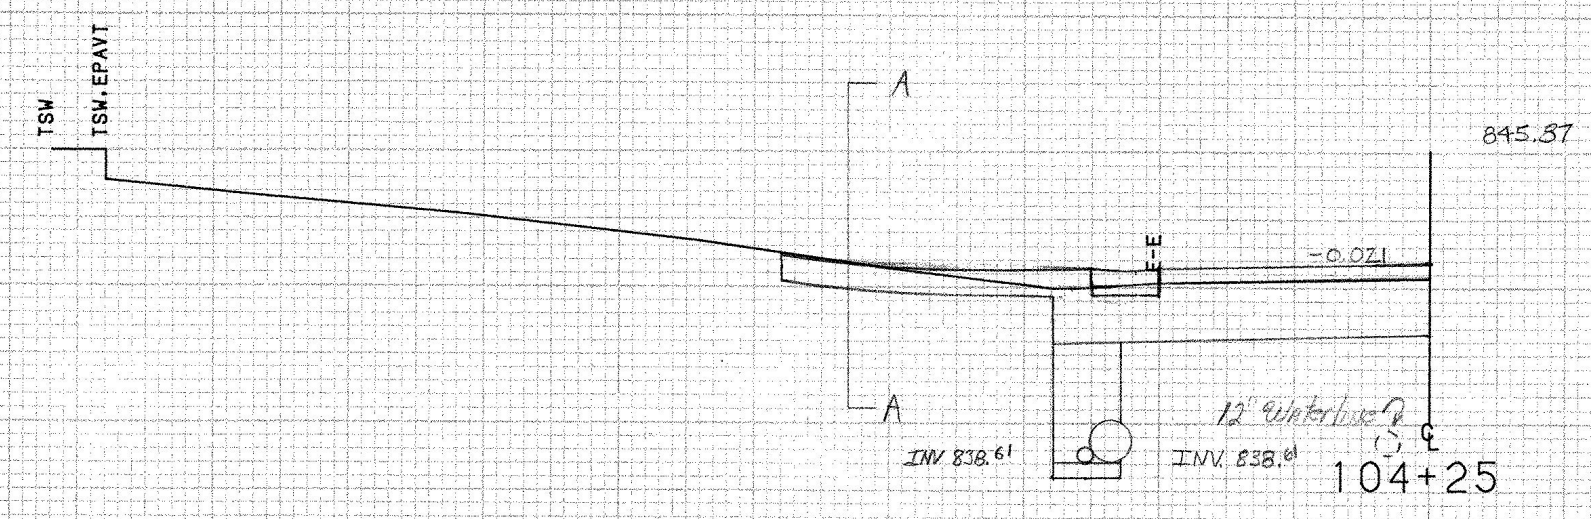
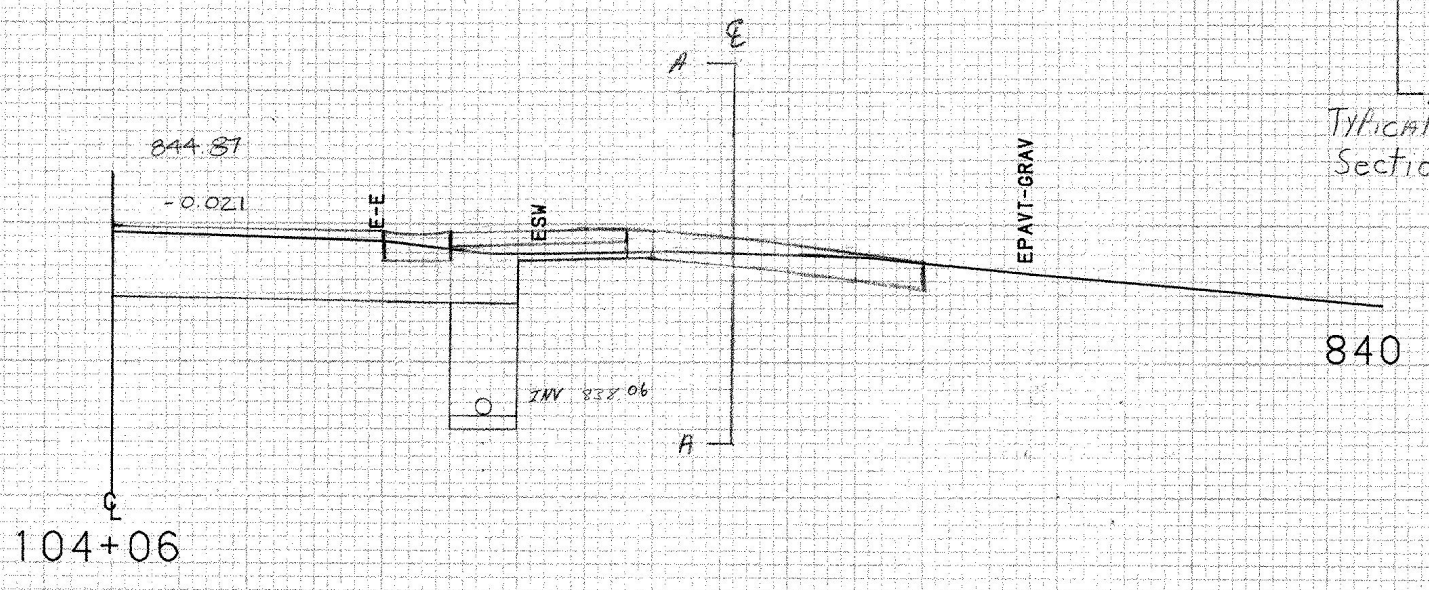


845

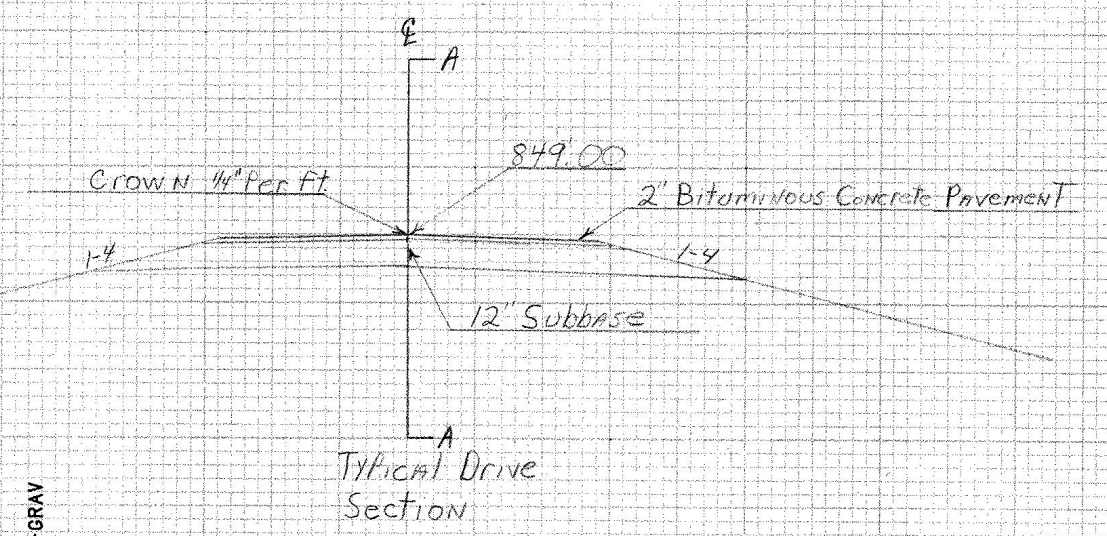

845

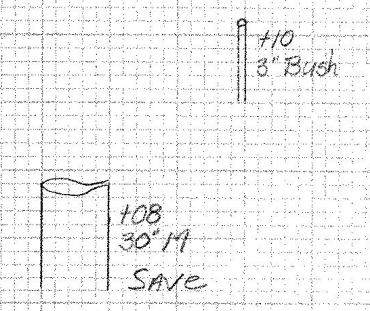

FROM STA. 104+06 TO STA. 104+32
 PROJECT NAME OLD BENNINGTON
 NO. M1400 (4) S
 SURVEYED BY MOREAU
 SHEET 37 OF 63 SHEETS

PLOTTED 02/24/86
 JAN. 1986

SCALE 5 FEET