


107+47.62

860

*Match New Gutter & Sidewalk To Existing  
@ 107+45 Rt. (Monument Ave.)*

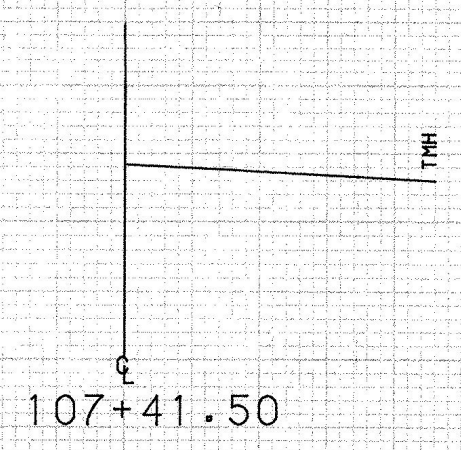

107+41.50

860

FROM STA.	107+41.50	TO STA.	107+47.62
PROJECT NAME	OLD BENNINGTON		<del>XXXXXXXXXX</del>
NO.	M1400(4)S	PLOTTED	02/24/86
SURVEYED BY	MOREAU	JAN.	1986
SHEET	58	OF	63 SHEETS

SCALE 5 FEET