


80+55  
END FAIRVIEW ST. CONSTRUCTION

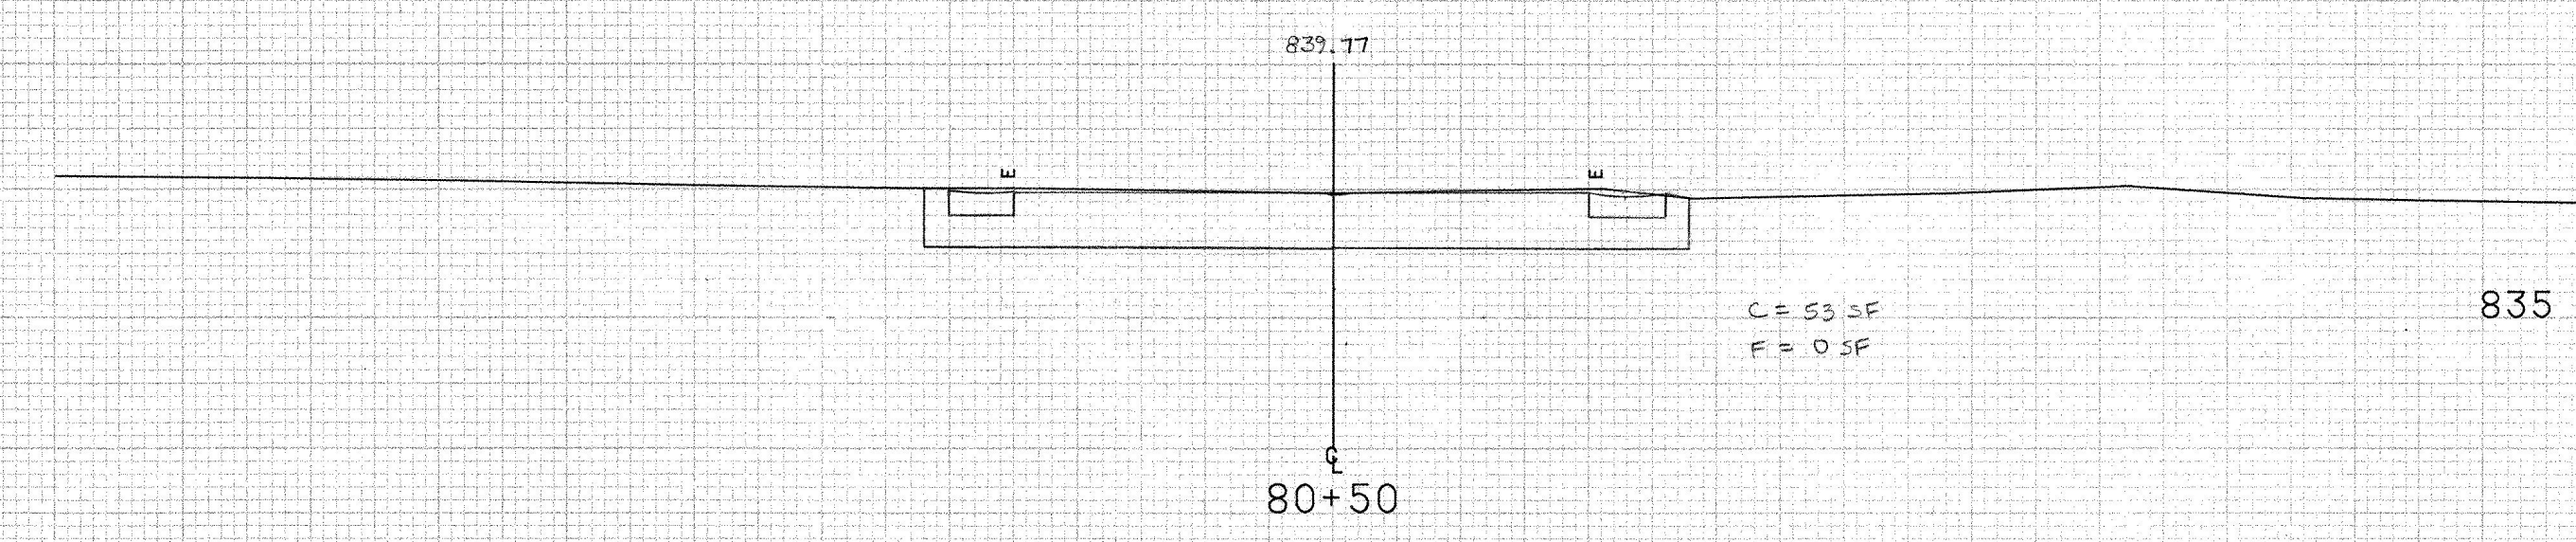

FROM STA.	80+50	TO STA.	81+00
PROJECT NAME	OLD BENNINGTON FAIRVIEW ST		
NO.	M1400 (4) S	PLOTTED	02/24/86
SURVEYED BY	MOREAU	JAN.	1986
SHEET	60	OF	62 SHEETS

SCALE 1" = 5 FEET