




11+50

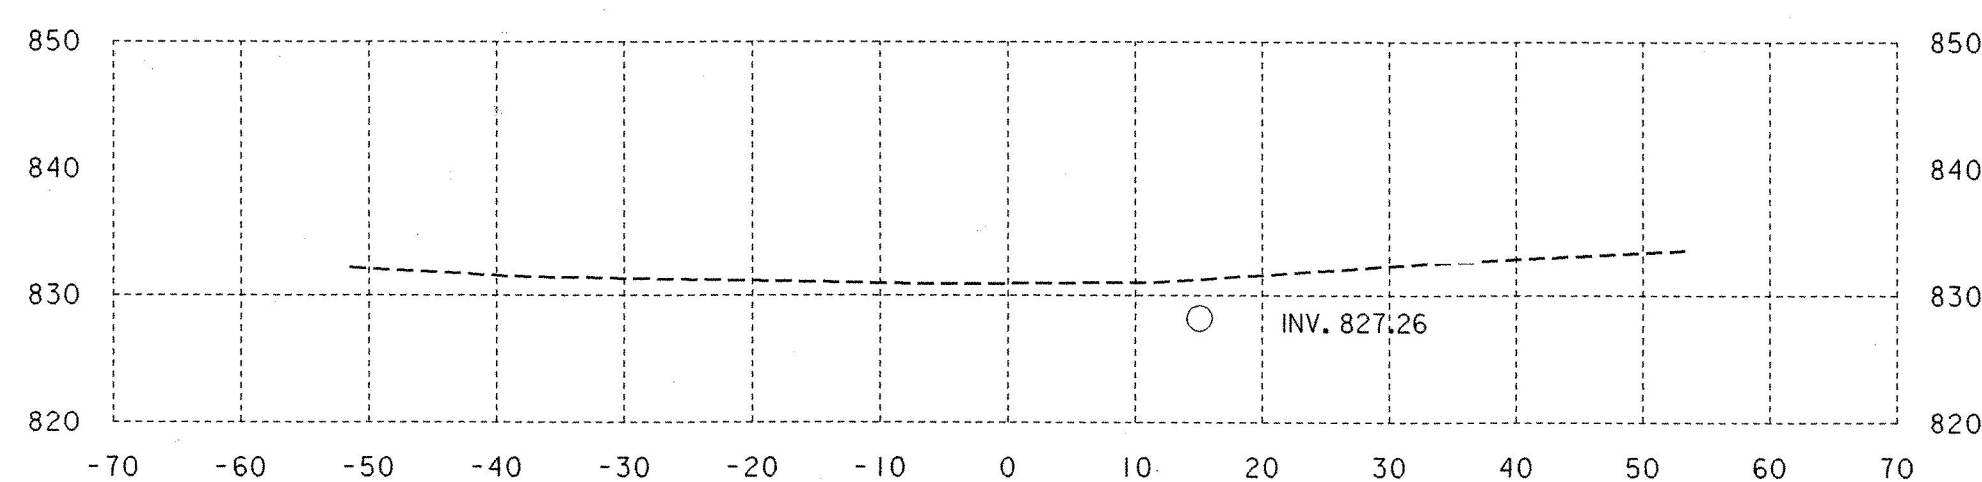


13+00

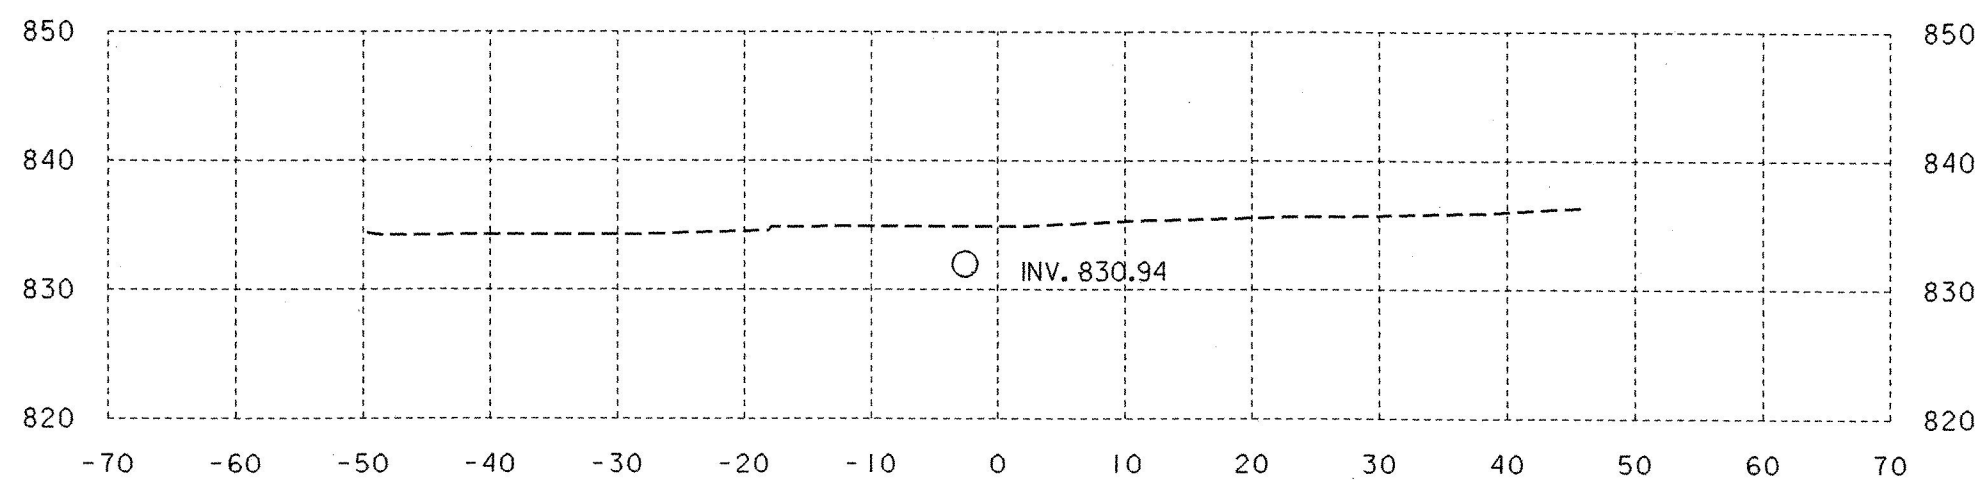


11+00

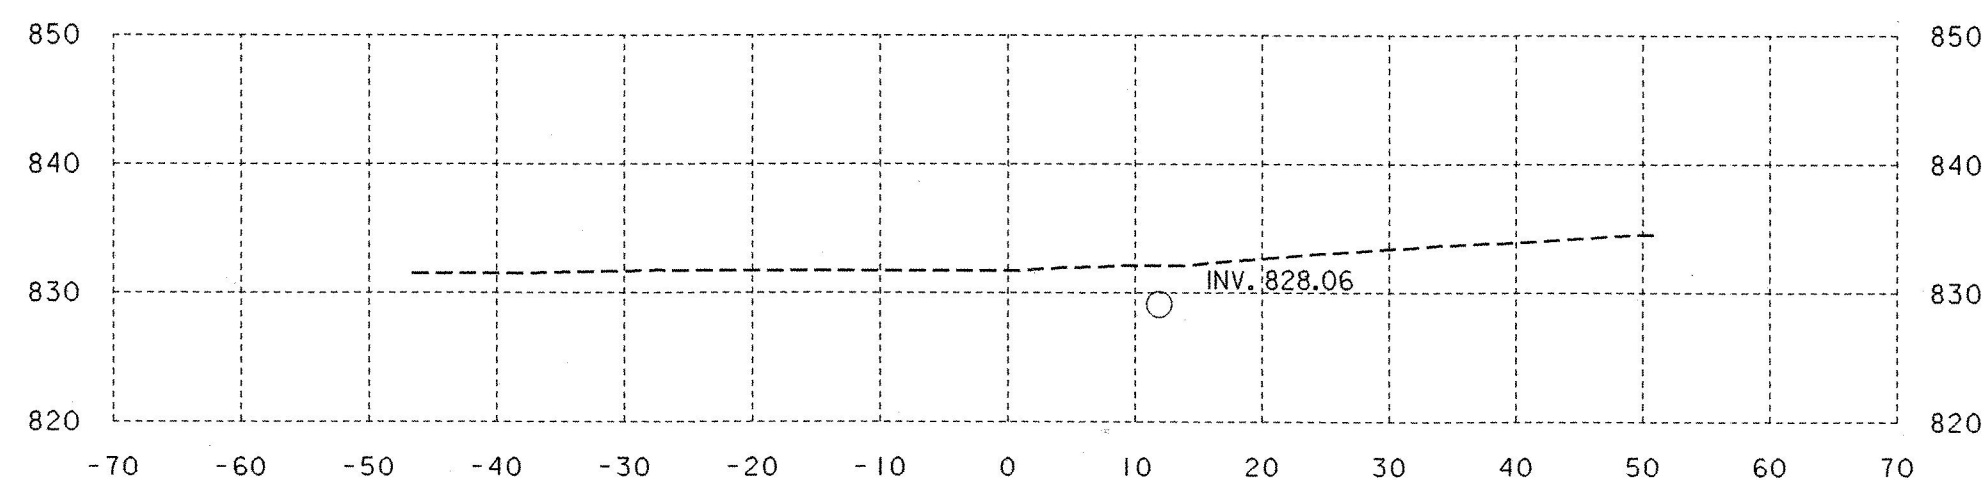

12+50

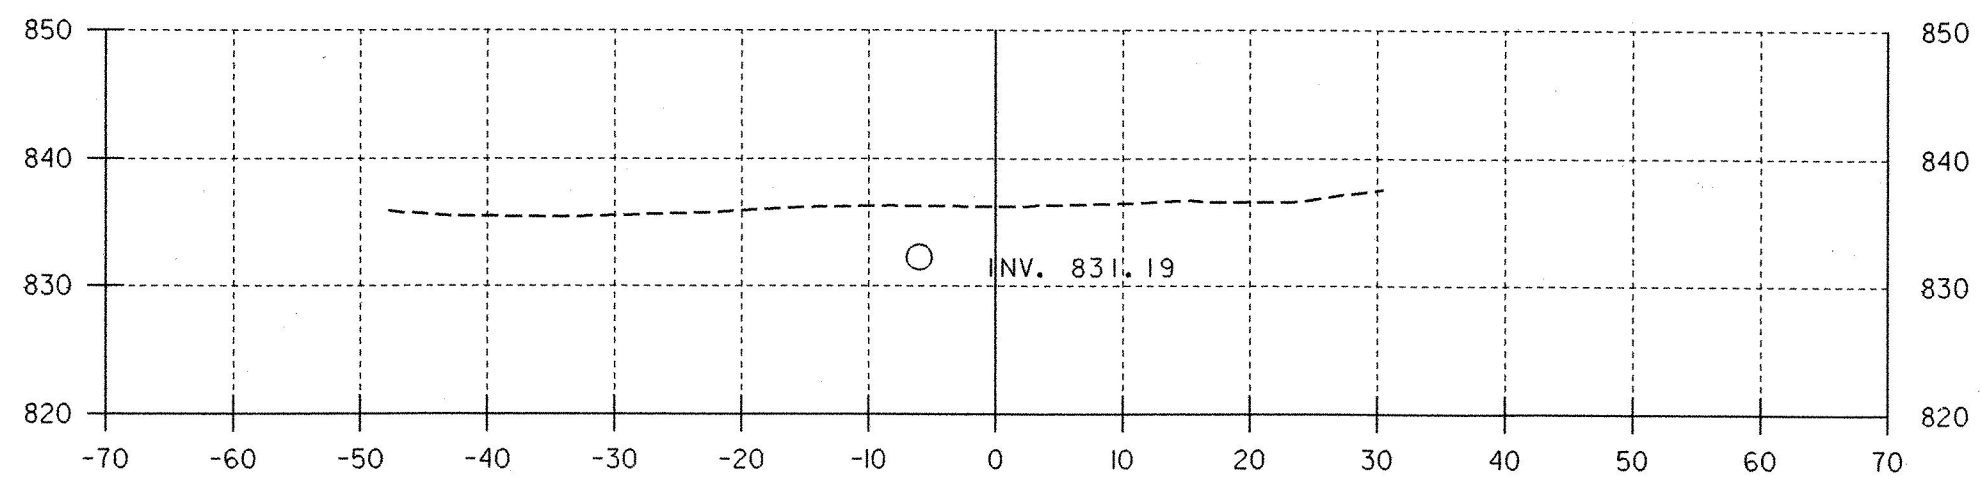

10+50

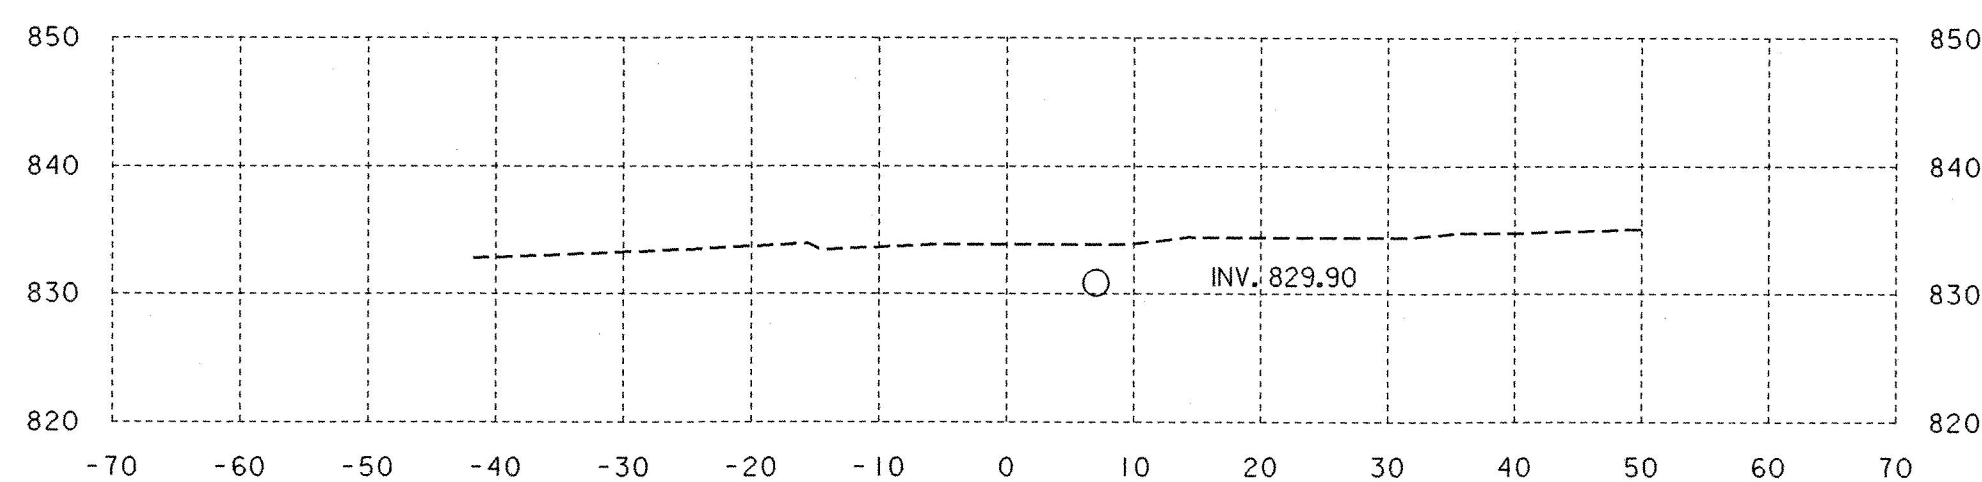

12+00

DATUM
 VERTICAL NGVD 1929
 HORIZONTAL N/A

SURVEYED BY _____ DATE _____
 DRAWN BY A. JONES DATE 6/22/94
 SQUAD LEADER S. MENARD
 DESIGN FILE NO. /usr/sqdc/84d714/dd7143d.dgn
 IPARM FILE dd714xsl DATE PLOTTED 28-APR-1999
 PROJ. NAME OLD BENNINGTON
 PROJ. NO. M 1400 (4) S
 SHEET 62 OF 63 SHEETS