



14+50

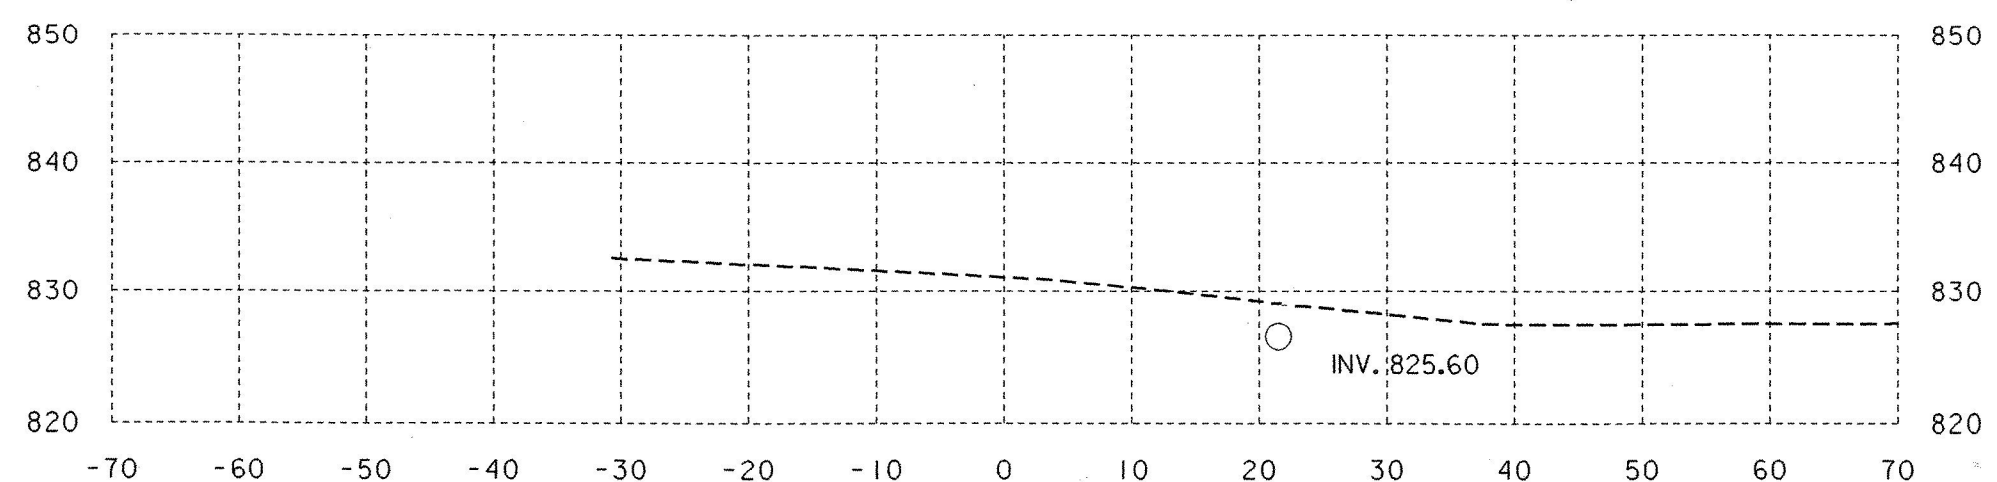

14+00

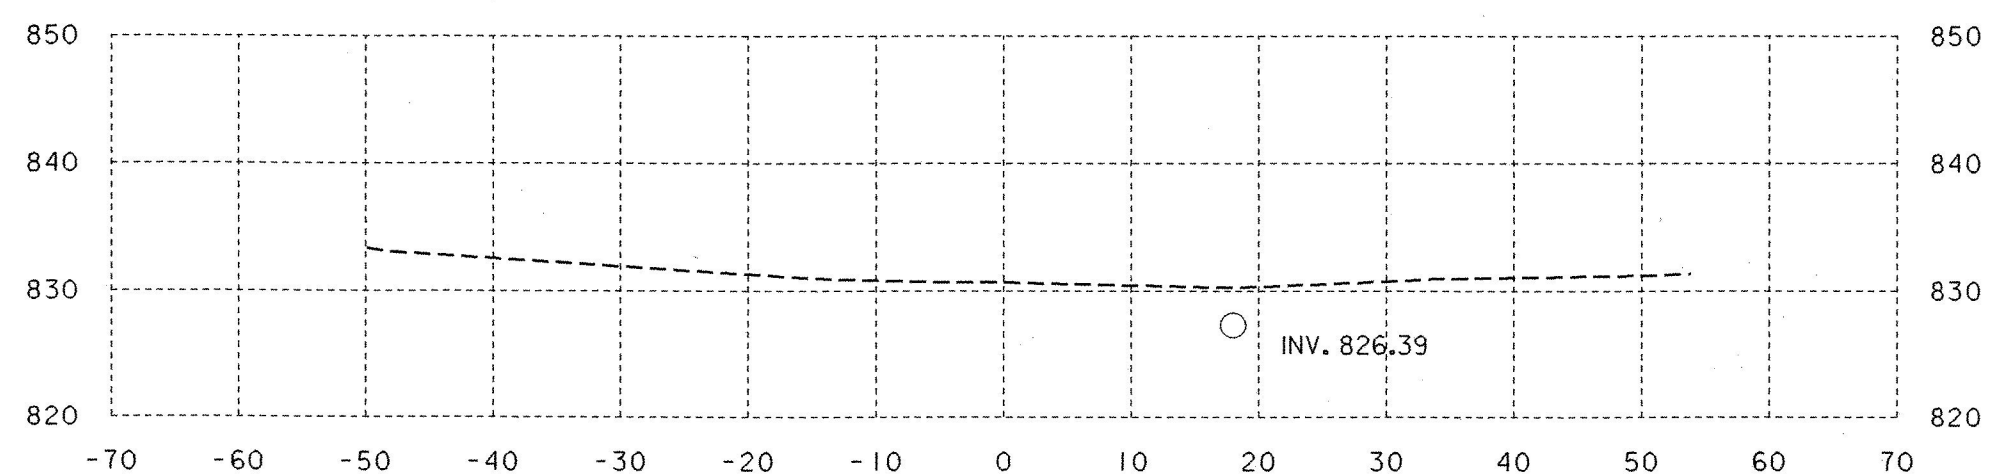

13+50

DATUM
VERTICAL NGVD 1929
HORIZONTAL N/A

SURVEYED BY	<u>A. JONES</u>	DATE	<u>6/22/94</u>
DRAWN BY	<u>S. MENARD</u>	DATE	<u>6/22/94</u>
SQUAD LEADER	<u>S. MENARD</u>		
DESIGN FILE NO.	<u>/usr/sqdc/84d714/dd7143d.dgn</u>		
IPARM FILE	<u>dd714xs2</u>	DATE	<u>28-APR-1999</u>
FILE		PLOTTED	<u>28-APR-1999</u>
PROJ. NAME	<u>OLD BENNINGTON</u>		
PROJ. NO.	<u>M 1400 (4) S</u>		
SHEET	<u>63</u>	OF	<u>63</u> SHEETS