


TYPICAL SECTIONS & DESIGN DATA

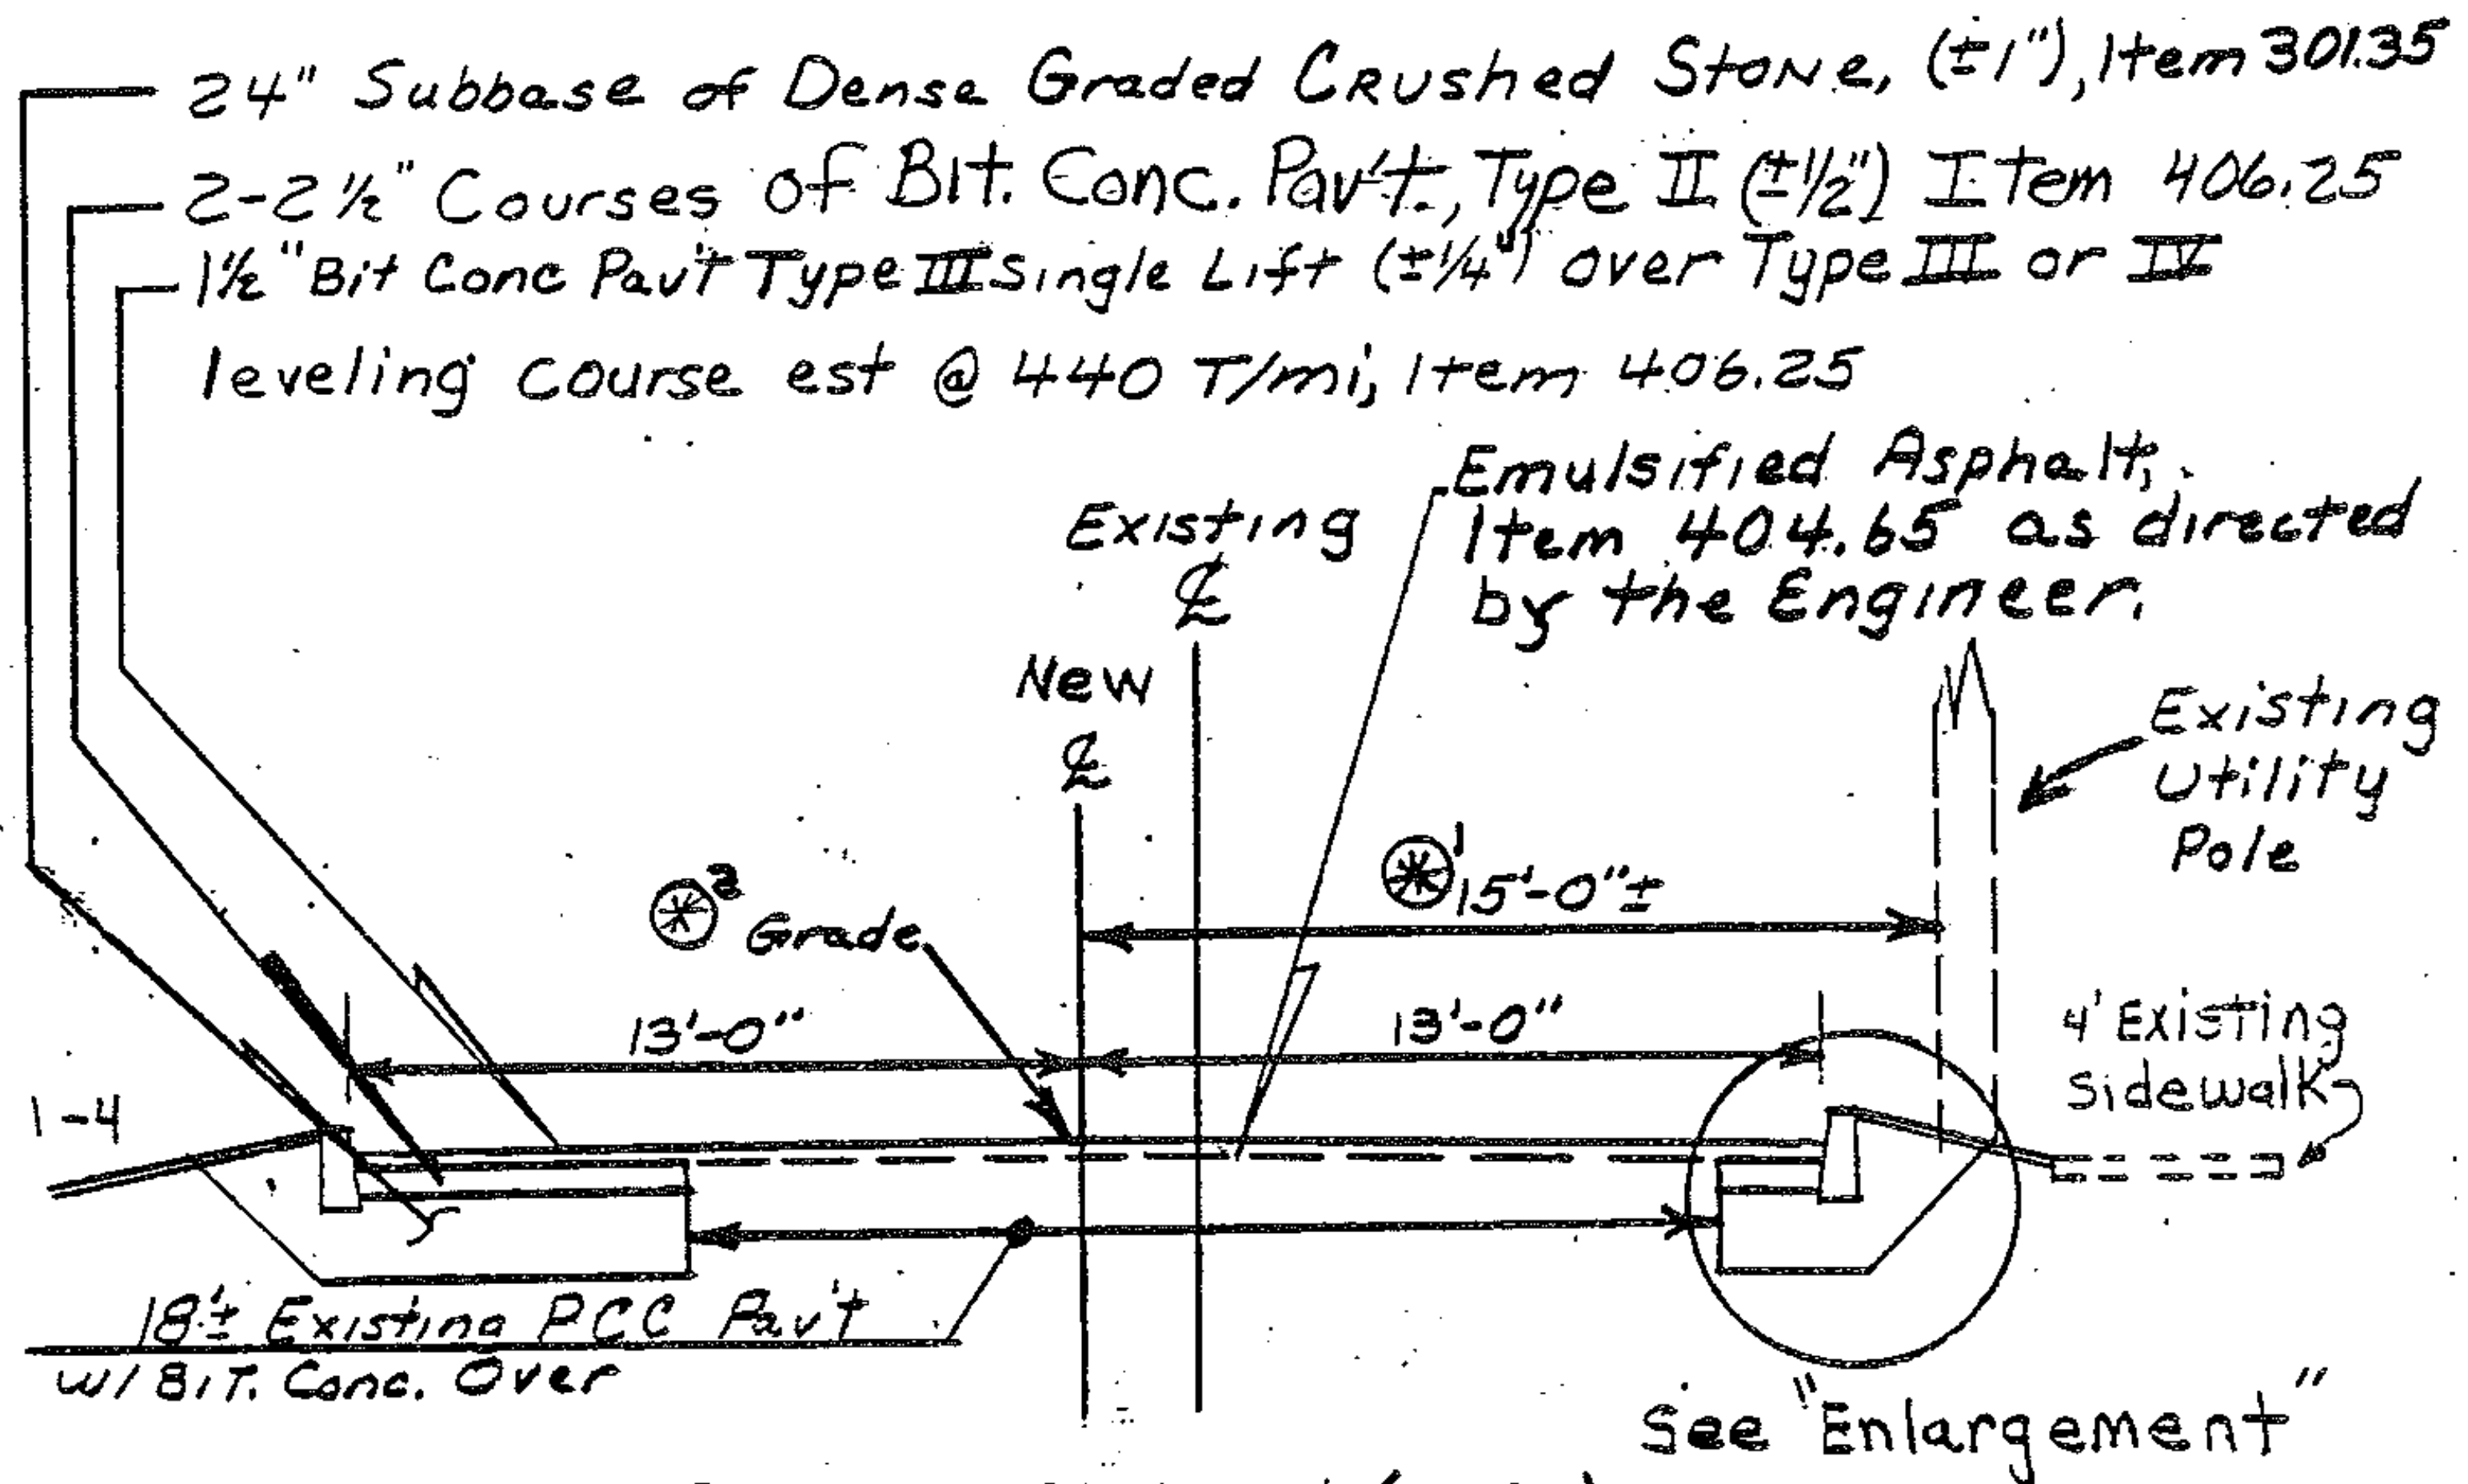

TYPICAL SECTION (NTS)

⊗¹ As established in field, by Engineer; Strive for 2" (min) from face of curb to face of existing pole line.

⊗² Finish grade to be 1/2" (plus leveling) above existing, or as directed by the Engineer.

