


# DETAILS

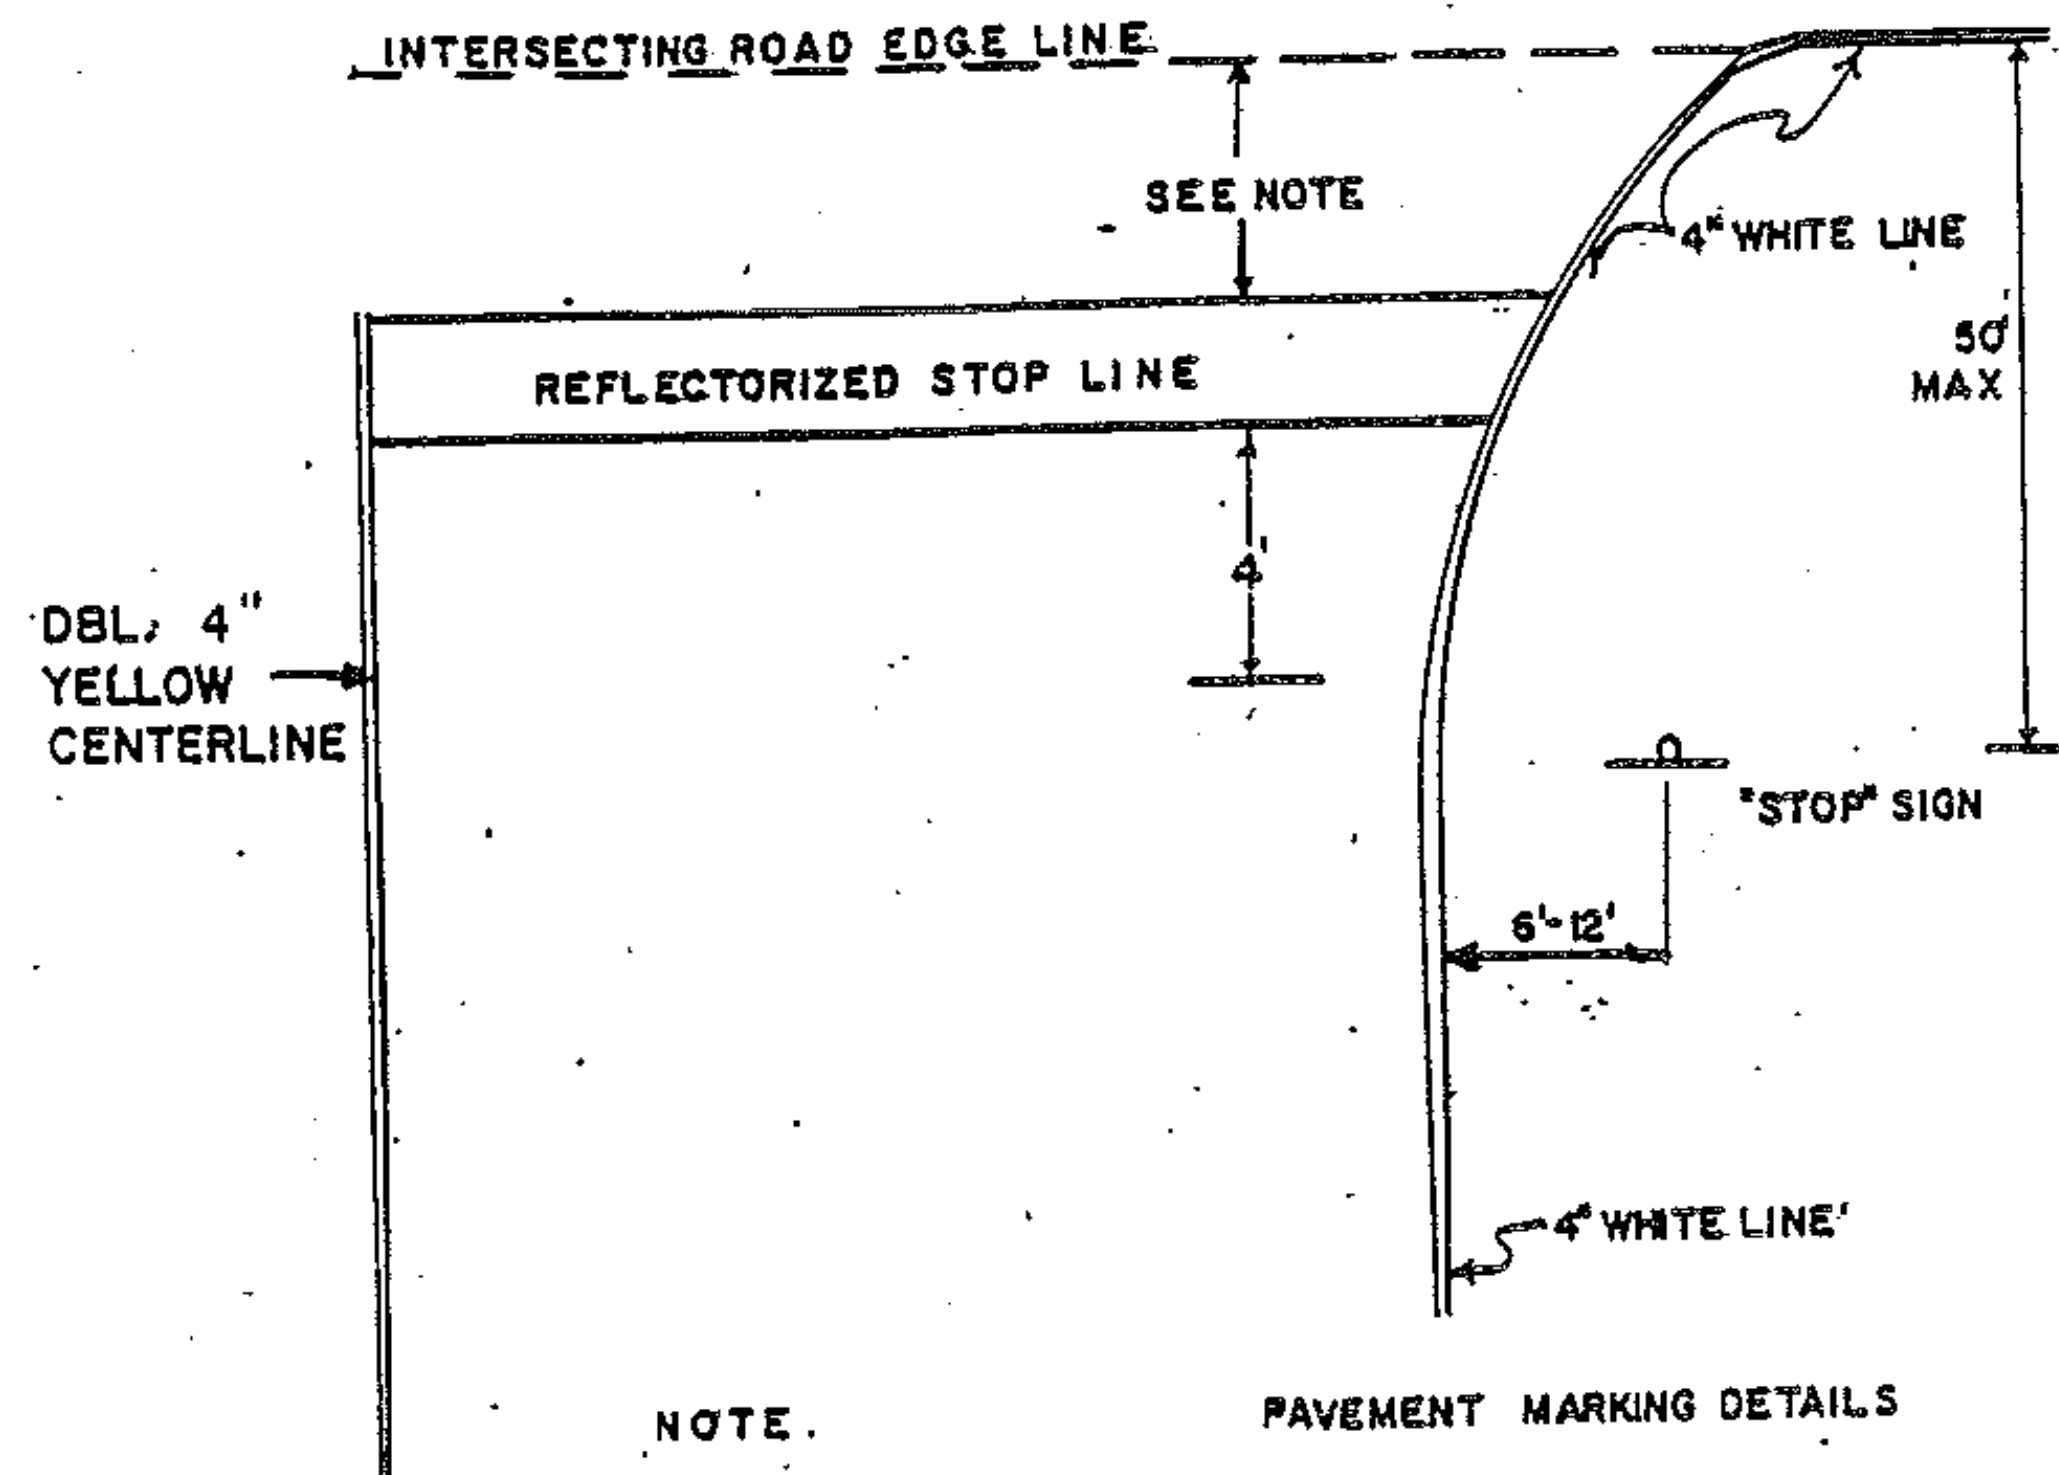

1. THE STOP LINE SHOULD BE PLACED AT THE DESIRED STOPPING POINT, IN NO CASE MORE THAN 30 FEET OR LESS THAN 4' FROM THE NEAREST EDGE OF THE INTERSECTING ROADWAY.

## Notes:

- 1) Three Stop Bars at 17 feet each - Two on Allen St.  
- One on Stowell St.
- 2) Three Stop Signs - Two on Allen Street  
- One on Stowell Street
- 3) Four No Parking Signs each side of Allen Street,  
at locations to be determined by the Engineer.