

INDEX OF SHEETS

STATE OF VERMONT  
AGENCY OF TRANSPORTATION




PROPOSED IMPROVEMENT  
BRIDGE PROJECT

TOWN OF NEWFANE  
COUNTY OF WINDHAM



ROUTE NO: T.H. 76 BRIDGE NO: 64

PROJECT LOCATION: BEGINNING APPROXIMATELY .10 MILES WEST OF THE INTERSECTION OF VT. 30 AND T.H. 76 AND EXTENDING .038 MILES EAST ON T.H. 76.  
PROJECT DESCRIPTION: TO FURNISH PRECAST PRESTRESSED CONCRETE MEMBERS AS SHOWN ON THESE PLANS AND TO PLACE AT THE JOB SITES AS DIRECTED BY THE DISTRICT ADMINISTRATOR.

LENGTH OF STRUCTURE: 42.00 FEET  
LENGTH OF PARTICIPATION ROADWAY: 158.00 FEET  
LENGTH OF NON-PARTICIPATION ROADWAY: 0.00 FEET  
LENGTH OF PROJECT: 200.00 FEET

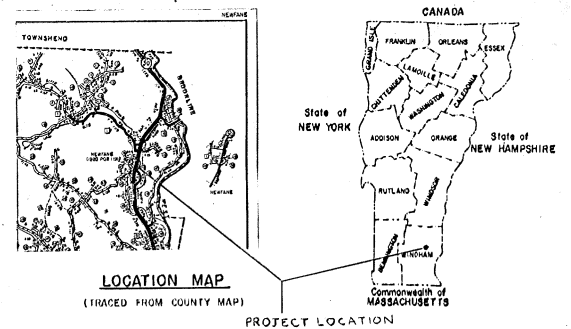


GENERAL NOTES

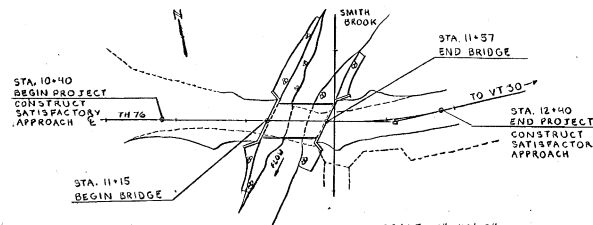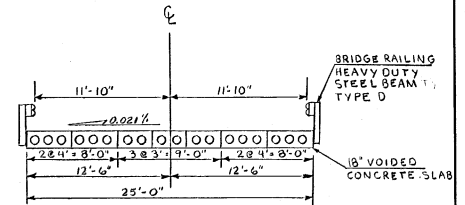

TRAFFIC DATA

EST. 1984 ADT = 380  
EST. 1984 DHV = 55  
EST. 1994 ADT = 450  
EST. 1994 DHV = 65  
D = 54%  
T = 9%

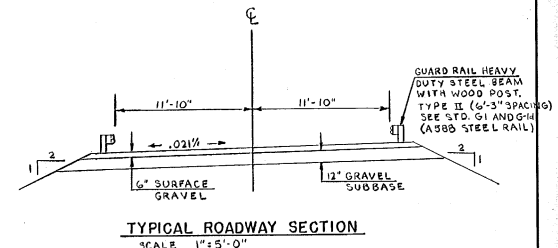

CONVENTIONAL SIGNS

- COUNTY LINE
- TOWN LINE
- LIMITS OF ACCESS
- POINT OF ACCESS
- FENCE LINE
- STONE WALL
- TRAVELED WAY
- GUARD RAIL
- RAILROAD
- SURVEY LINE
- CULVERT
- POWER POLE
- TELEPHONE POLE
- TREES
- CONTROL OF ACCESS
- PROPERTY LINE
- ROW TAKING LINE
- SLOPE RIGHTS
- TOP OF CUT
- TOE OF SLOPE

DATUM	_____
VERTICAL	_____
HORIZONTAL	_____


Construction is to be carried on in accordance with these plans and the Standard Specifications for Highway and Bridge Construction dated March, 1978, as approved by the Federal Highway Administration on October 27, 1979 for use on this project, including all subsequent revisions and such revised specifications and special provisions as are incorporated in these plans.

SUBMITTED BY ORDER OF THE STATE TRANSPORTATION BOARD	
APPROVED: <i>[Signature]</i> DATE 6/21/84	
DIRECTOR OF ENGINEERING AND CONSTRUCTION	
PROJECT NEWFANE	PROJECT NO. TH 3439
SHEET 1 OF SHEETS	
3/8 7/2/81	



DATE	
BY	
PROJECT	
DESCRIPTION	
SCALE	
DATE	

DATE	
BY	
PROJECT	
DESCRIPTION	
SCALE	
DATE	

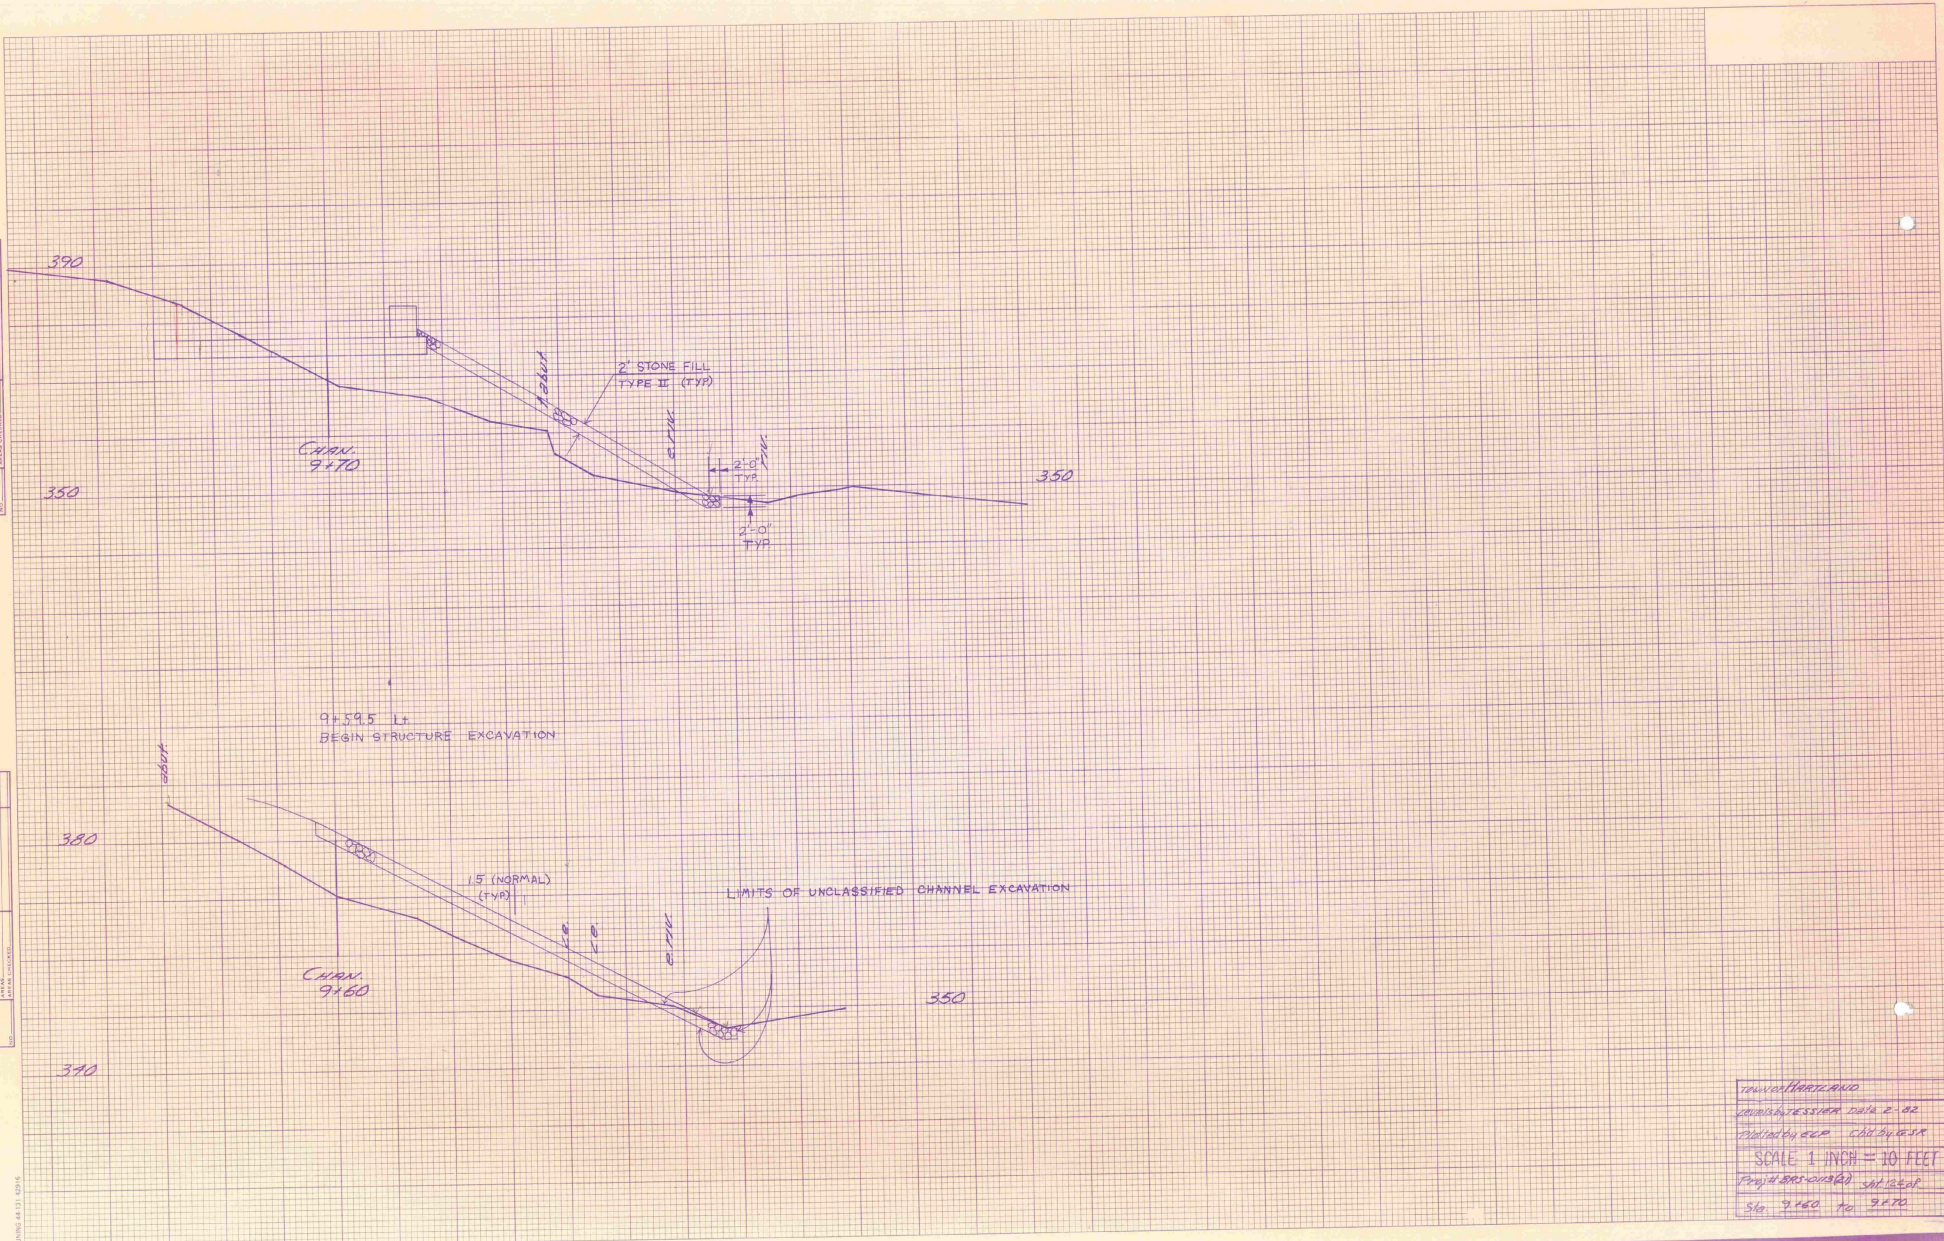

DRAWN BY: [Signature]  
 CHECKED BY: [Signature]  
 SCALE 1 INCH = 10 FEET  
 DATE: 9/16/00 TO 9/17/00

1984  
BRIDGE #64  
TR. 76

OVER  
SMITH  
BK.

NEWFANE

TR 3439

INITIALS Vermont Agency of <sup>DONE</sup>  
Transportation  
PHASE 2-INTERSTATE  
#122302-01

INITIALS Hanger 3127 <sup>DONE</sup>